


PROJECT LOCATION MAP

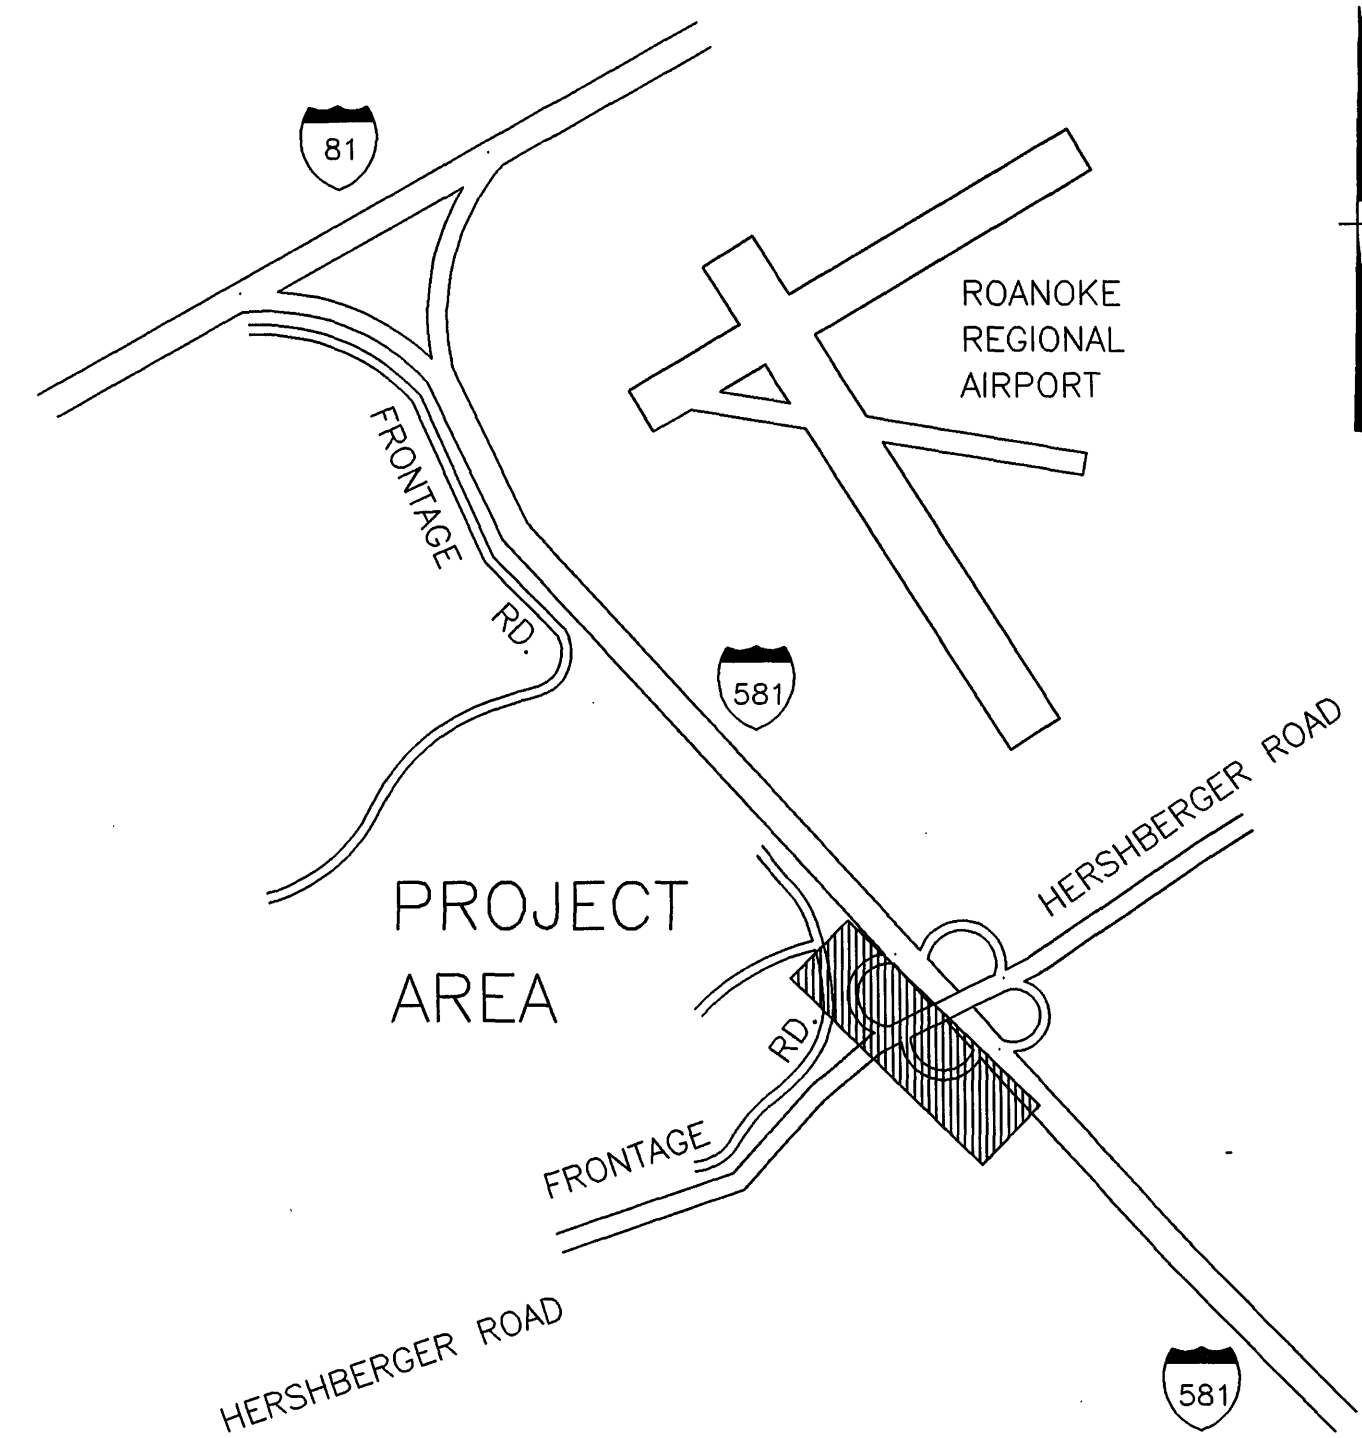

OFFICE OF CITY ENGINEER
ROOM 350
MUNICIPAL BUILDING
215 CHURCH AVENUE, S.W.
ROANOKE, VIRGINIA 24011

INDEX OF SHEETS


- | | |
|---|--------------------------------|
| 1 | TITLE |
| 2 | SUMMARY OF QUANTITIES |
| 3 | GENERAL ABBREVIATIONS & LEGEND |
| 4 | SHEET INDEX & GENERAL NOTES |
| 5 | PLAN & PROFILE |
| 6 | PLAN & PROFILE |
| 7 | PLAN & PROFILE |

CONSULTING ENGINEERS



CONSULTING ENGINEERS
SURVEYORS
701 FIRST STREET
ROANOKE, VIRGINIA

COMMISSION NUMBER: 1245G

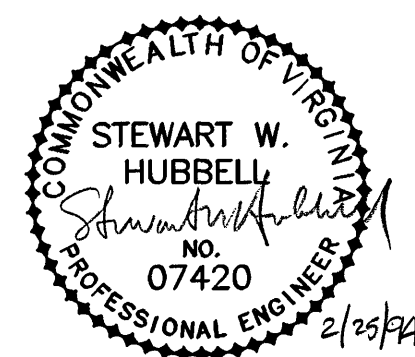

PROJECT NAME

LICK RUN SEWER REPLACEMENT
PROJECT LR-3
CITY OF ROANOKE, VIRGINIA

PROJECT NUMBER: 6245G

REVISION BY	DESCRIPTION:	DATE
REVISION BY	DESCRIPTION:	DATE
REVISION BY	DESCRIPTION:	DATE
REVISION BY	DESCRIPTION:	DATE

RECORD DRAWINGS 4-1-96

APPROVED FOR CONSTRUCTION

<i>Philip C. Schurman</i> ROANOKE CITY ENGINEER	9/13/95 DATE
<i>William F. Clark</i> DIRECTOR OF PUBLIC WORKS	9/14/95 DATE
<i>Wit B. L.</i> DIRECTOR OF PUBLIC UTILITIES AND OPERATIONS	9/15/95 DATE
	DATE
	DATE

ADVERTISED DATE: _____

SET NUMBER: _____

SHEET NUMBER: 1 OF 7