
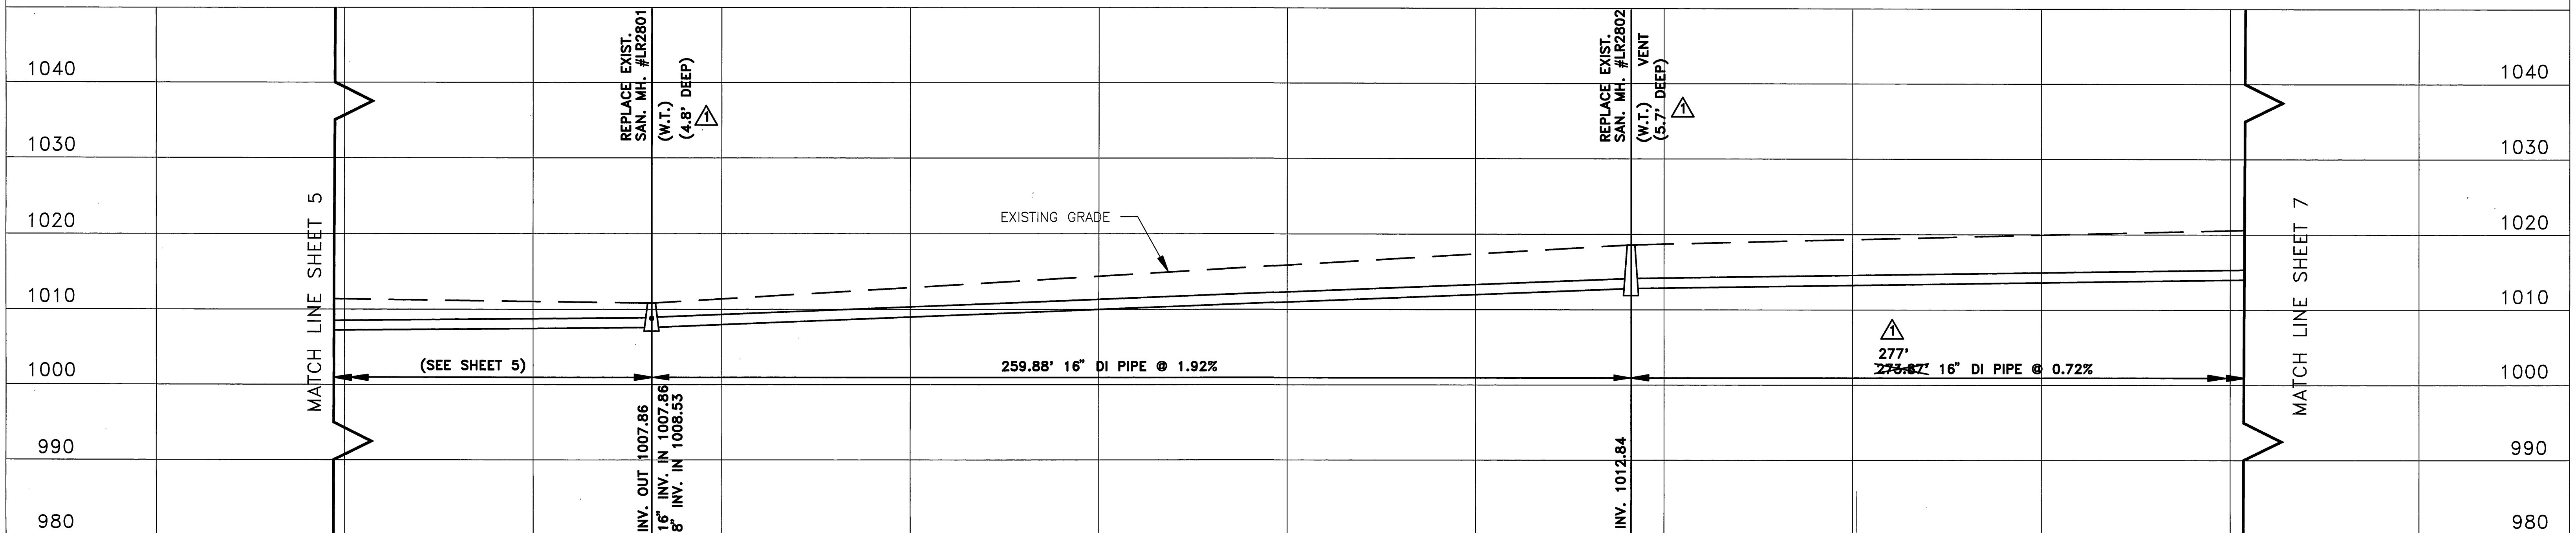
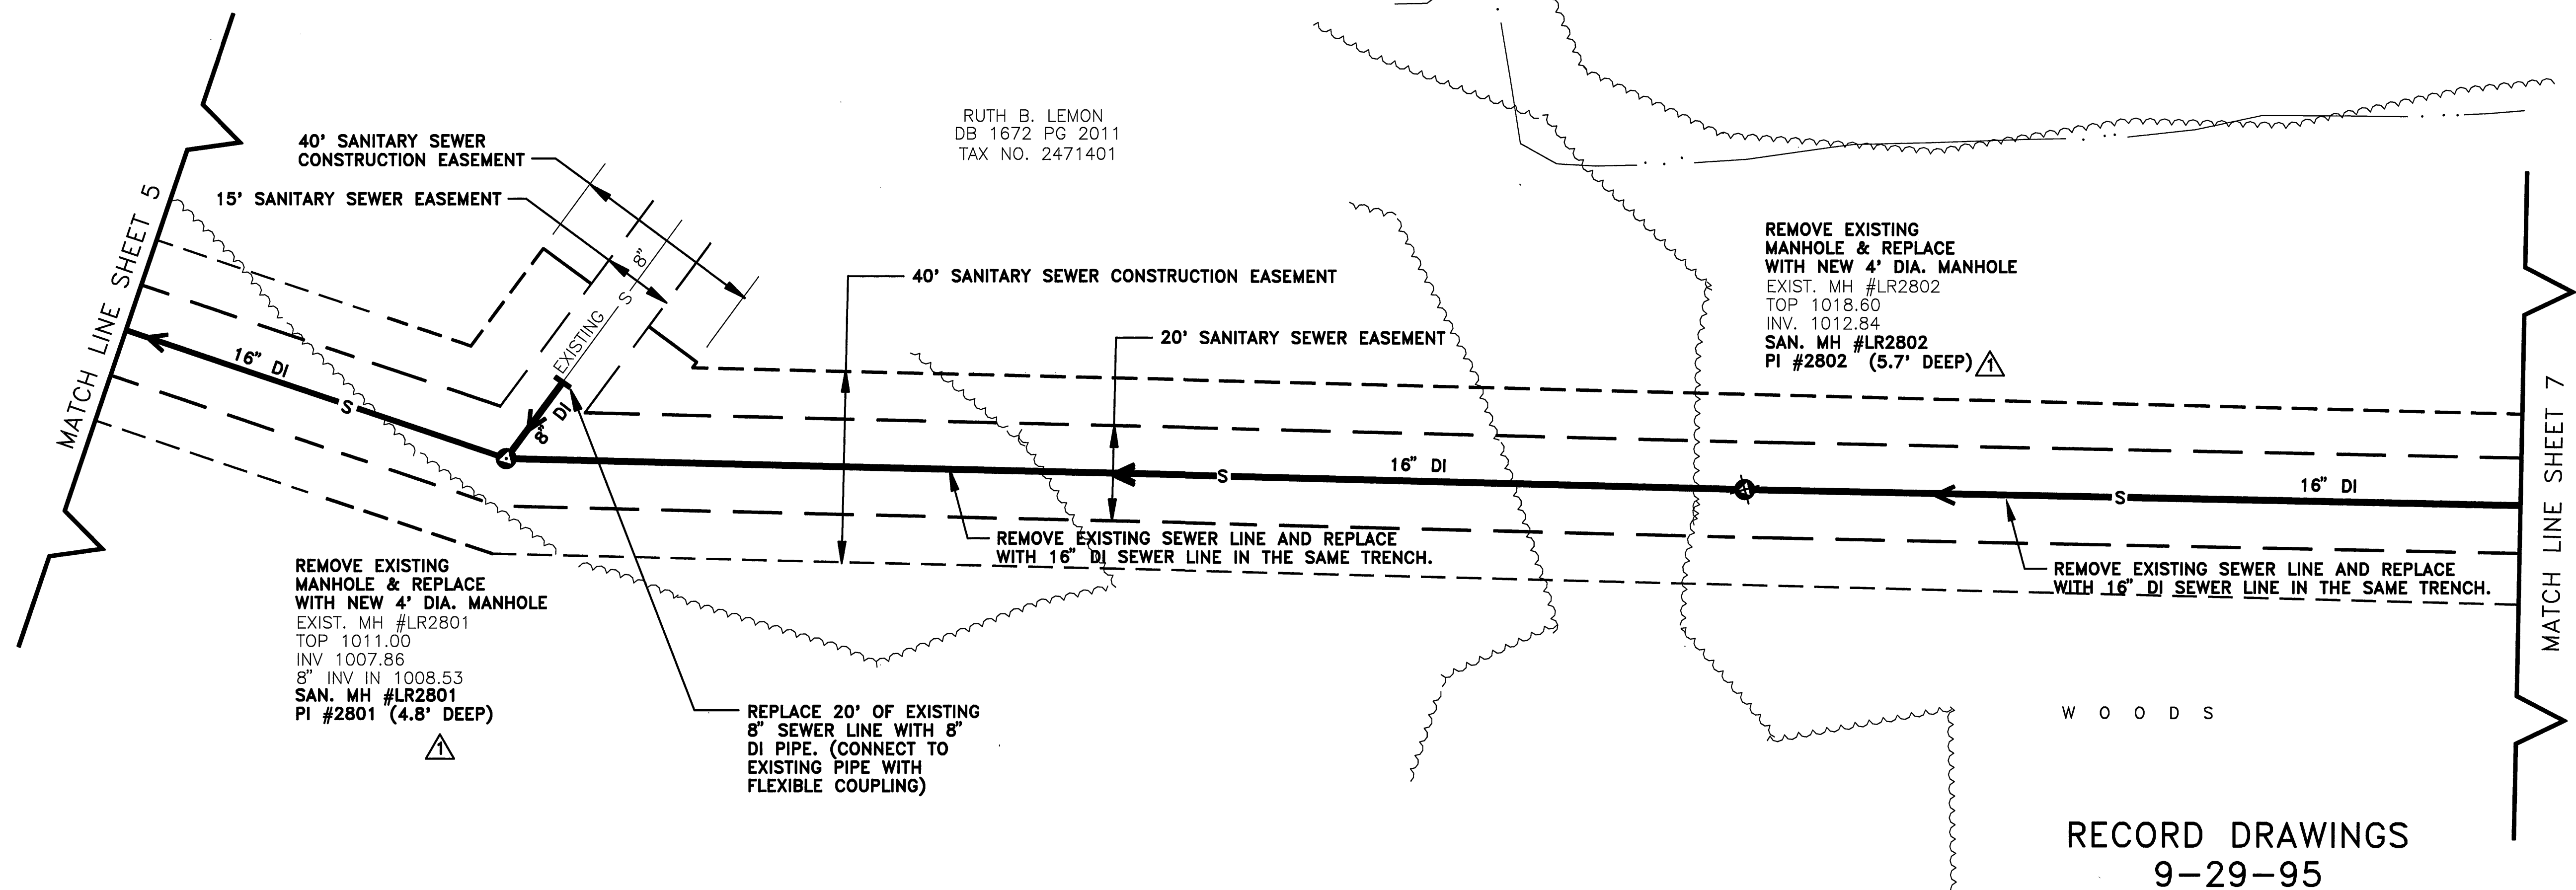
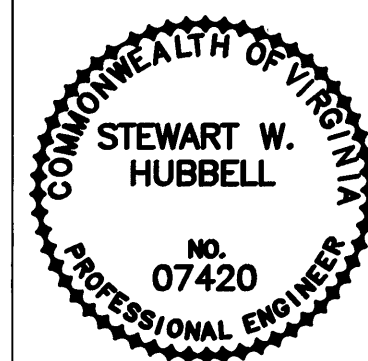


Mattern & Craig
CONSULTING ENGINEERS - SURVEYORS

DESIGNED:
TAM
DRAWN:
TAM
CHECKED:
SWH

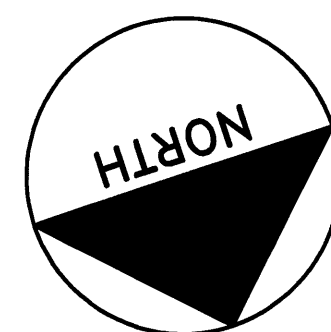

REV.	DATE	DESCRIPTION	BY	APP.
1	9/8/95	RECORD DRAWINGS	DSG	SWH

DATE
SEPTEMBER 1994
COMM. NO.
1245H

**LICK RUN SANITARY SEWER REPLACEMENT
PROJECT LR-5
PLAN
CITY OF ROANOKE, VIRGINIA**
SCALE: 1"=20' HORIZ.
1"=10' VERT.