
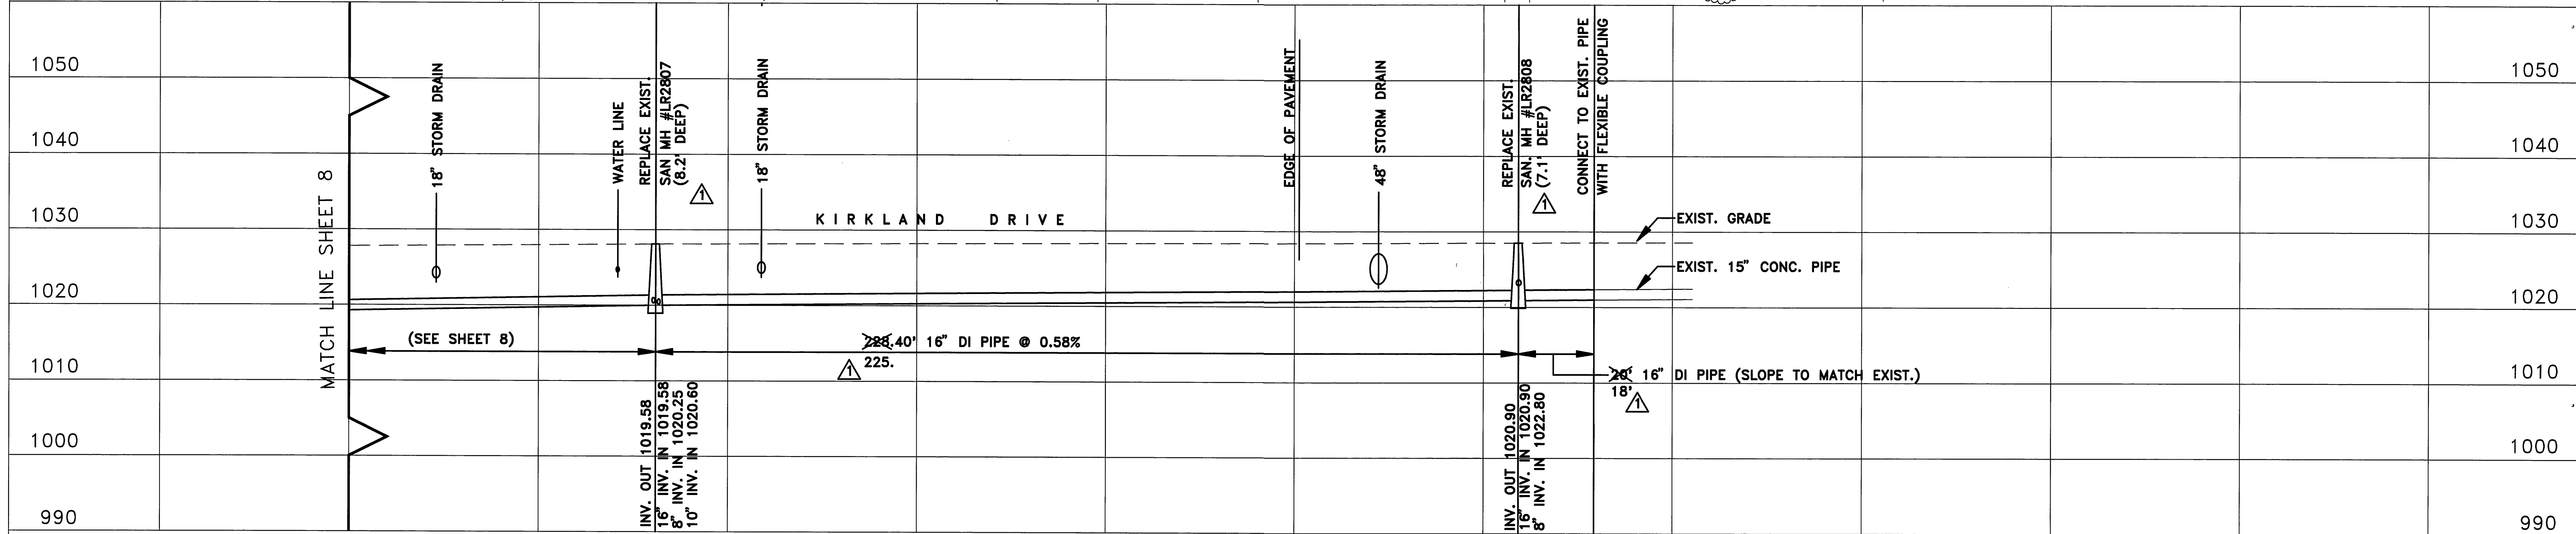
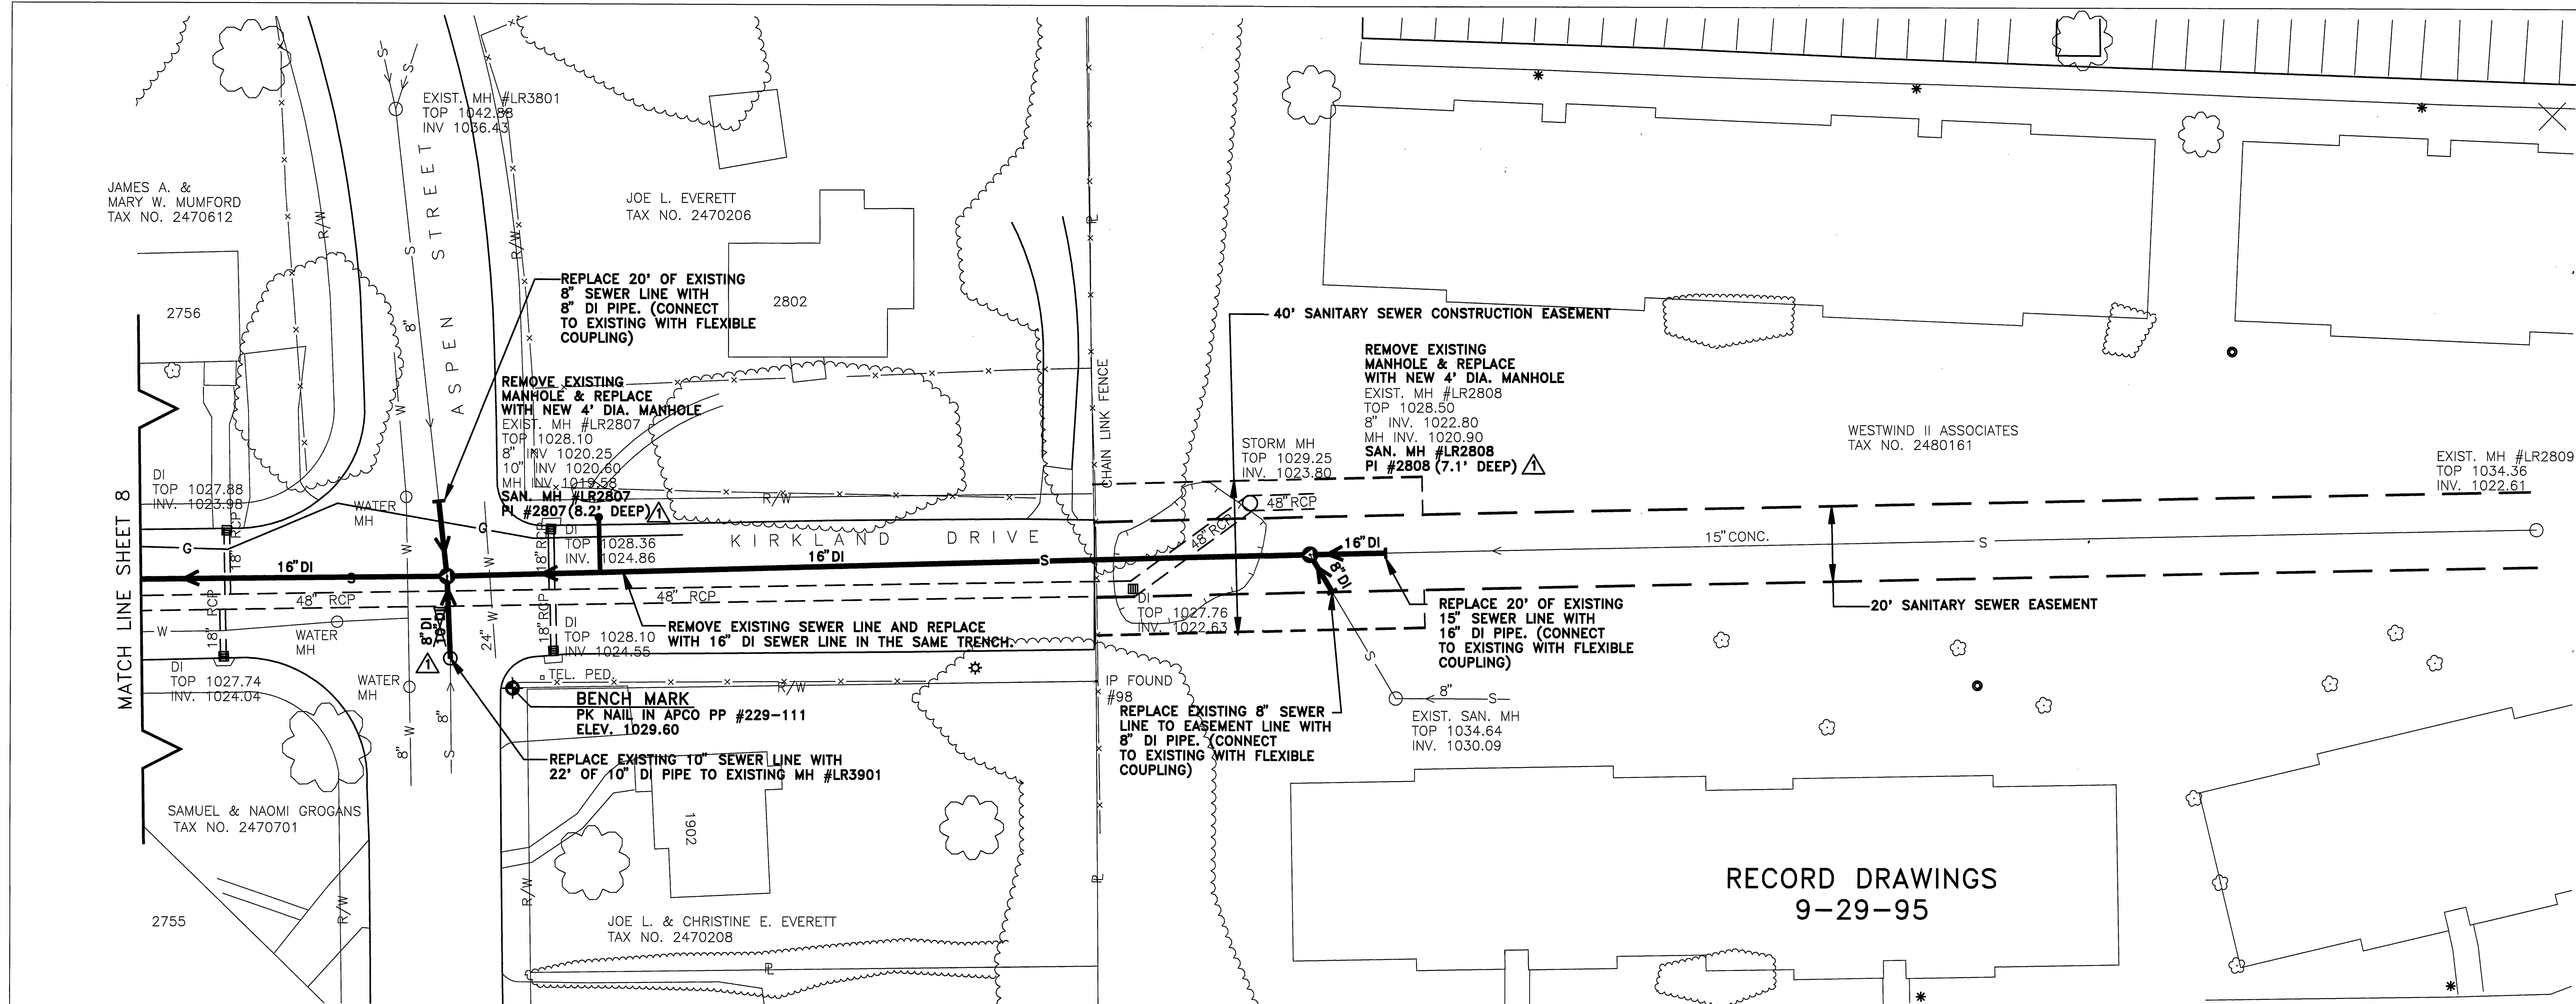
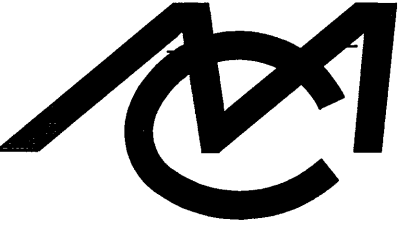
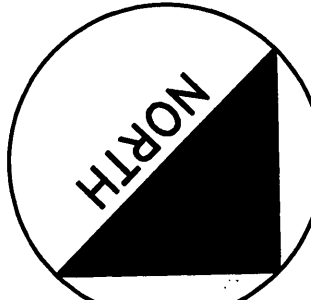


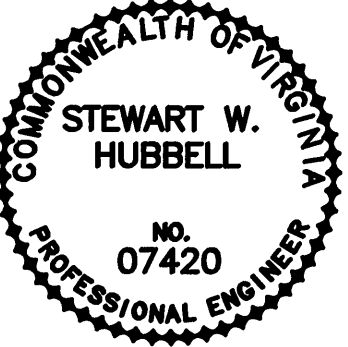

 Mattern & Craig CONSULTING ENGINEERS - SURVEYORS	DESIGNED: TAM/SWH			REV.	DATE	DESCRIPTION	BY	APP.	DATE SEPTEMBER 1994 COMM. NO. 1245	LICK RUN SANITARY SEWER REPLACEMENT PROJECT LR-5 PLAN CITY OF ROANOKE, VIRGINIA SCALE: 1"=20' HORIZ. 1"=10' VERT.	9
	DRAWN: TAM			9/8/95	RECORD DRAWINGS	DSG	SWH				
	CHECKED: SWH										