



SEE PLAN ON SHEET 5

RECORD DRAWINGS
9-29-95

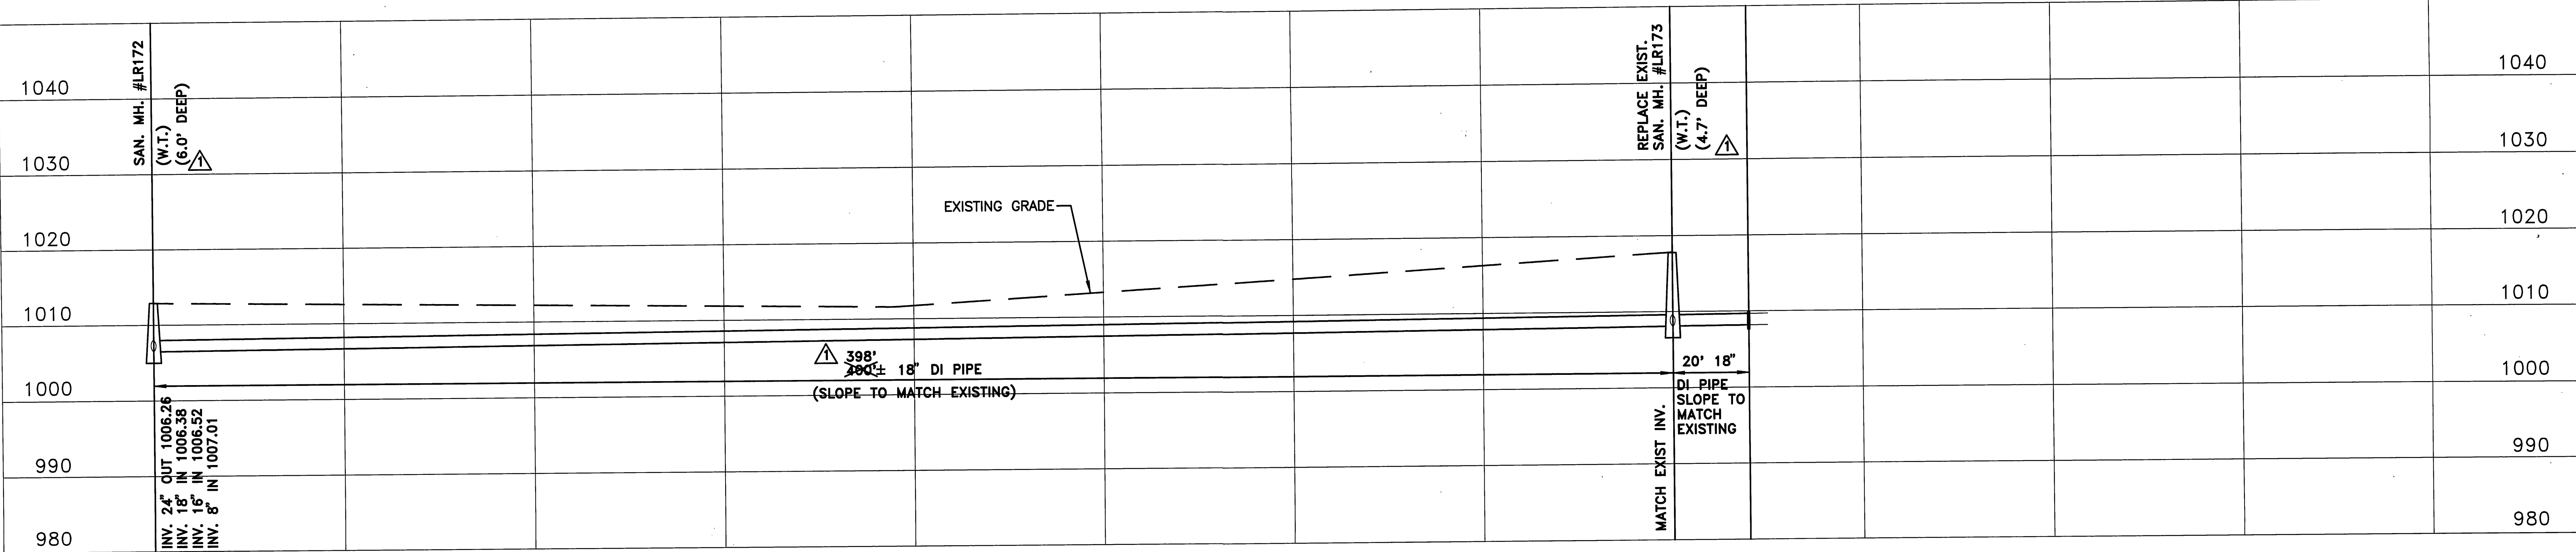

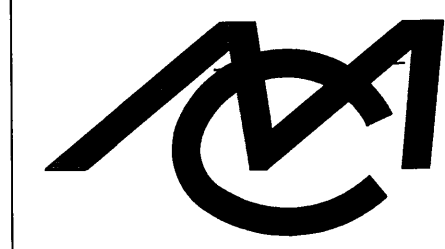


Mattern & Craig
CONSULTING ENGINEERS - SURVEYORS

DESIGNED:
TAM/SWH

DRAWN:
TAM

CHECKED:
SWH

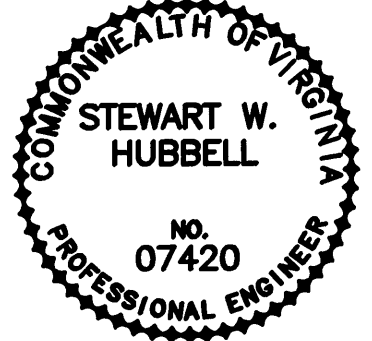

REV.	DATE	DESCRIPTION	BY	APP.
1	9/8/95	RECORD DRAWINGS	DSG	SWH

DATE
SEPTEMBER 1994

COMM. NO.
1245H

LICK RUN SANITARY SEWER REPLACEMENT
PROJECT LR-5
PROFILE
CITY OF ROANOKE, VIRGINIA

SCALE: 1"=20' HORIZ.
1"=10' VERT.

10