


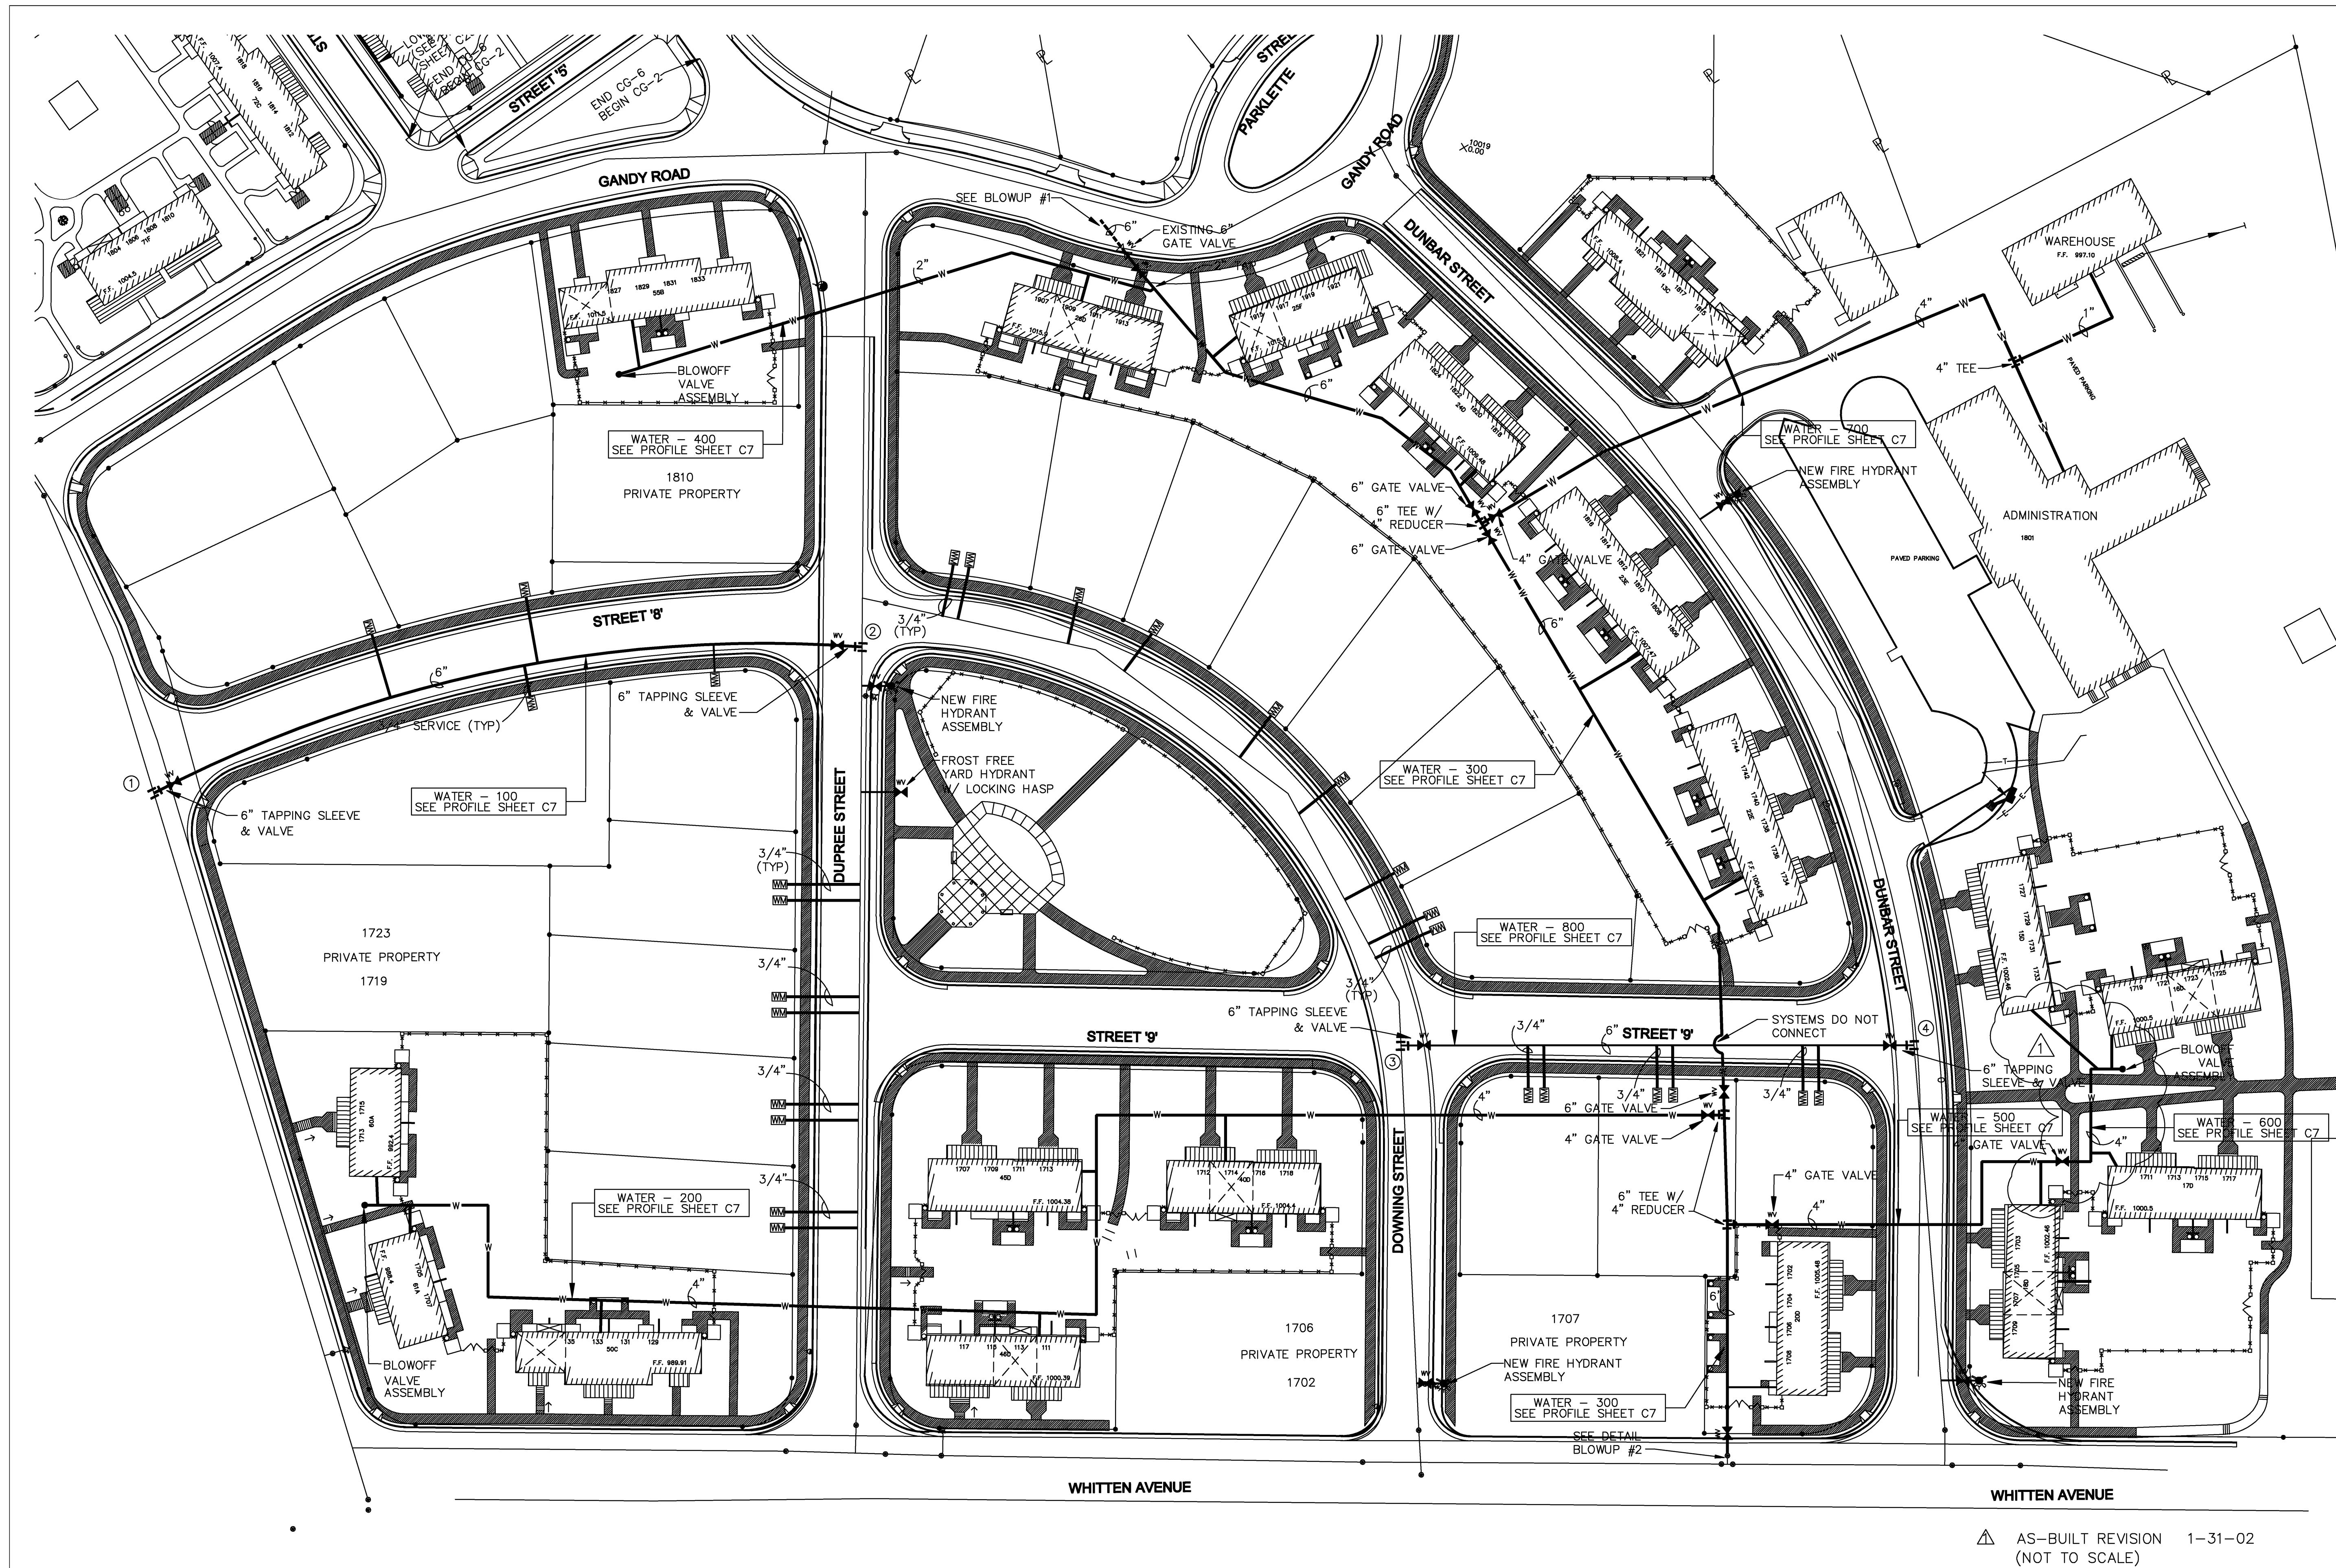

AS-BUILT REVISION 1-31-02  
(NOT TO SCALE)

MarshWitt

MarshWitt Associates, P.C.


Architecture  
Planning  
Value Analysis

315 King George Ave. SW  
Roanoke, VA 24016  
Phone: 540 982 1444  
Fax: 540 982 8300  
email: marshwitt@ver.net

CONSULTANTS:


IMW P.C.

ENGINEERING  
(540) 345-0875 102 ALBEMARLE AVE., S.E.  
FAX (540) 342-4458 ROANOKE, VIRGINIA 24013

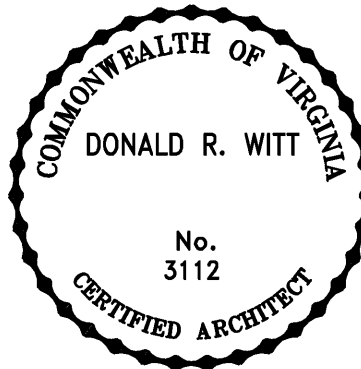

LINCOLN 2000

ROANOKE, VIRGINIA

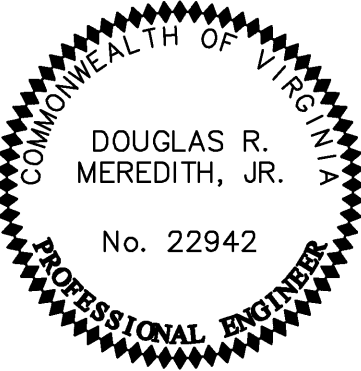

PHASE TWO

COMM. NO:

DESIGNED BY:

DRAWN BY:

CHECKED BY:

PLOT SCALE:

COPYRIGHT  
MARSHWITT ASSOCIATES P.C. 1999

| MK | DATE | DESCRIPTION |
|----|------|-------------|
|----|------|-------------|

SHEET TITLE:

SHEET OF

