



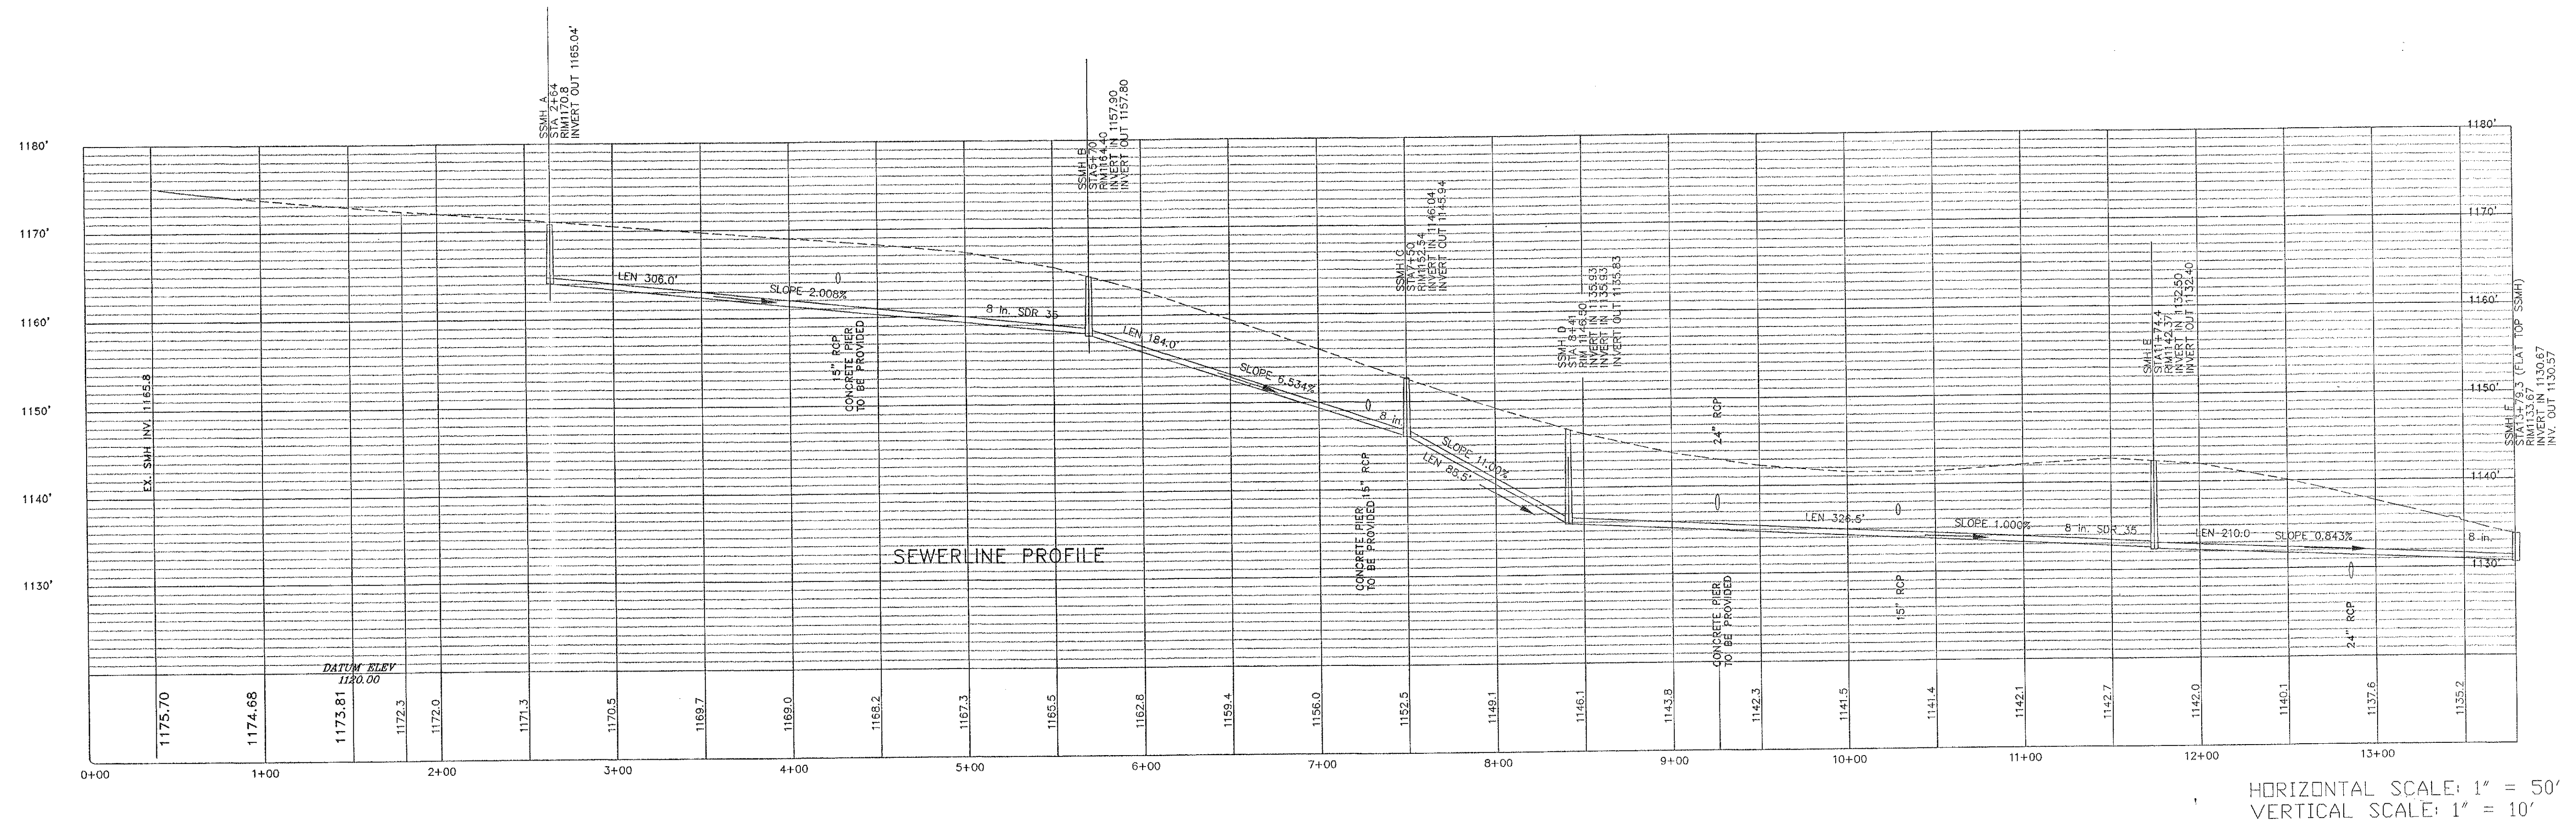

SEWERLINE CLEANOUT INFORMATION

LOT #	CLEANOUT INV. ELEV.	MIN. BLDG. ELEV.
1	1164.60	1166.60
2	1163.70	1165.70
3	1166.10	1168.10
4	1164.40	1166.40
5	1163.19	1165.19
6	1161.93	1163.93
7	1160.67	1162.67
8	1159.47	1161.47
9	1158.30	1160.30
10	1153.71	1155.71
11	1149.73	1151.73
12	1146.10	1147.40
13	1141.48	1143.48
14	1138.38	1140.38
15	1135.14	1137.14
16	1134.48	1136.48
17	1133.62	1135.62
18	1132.80	1134.80
19	1132.90	1133.28
20	1132.30	1133.30
21	1131.75	1132.75
22	1130.44	Pump
23	1130.15	Pump


6 10/30/02 AS-BUILTS

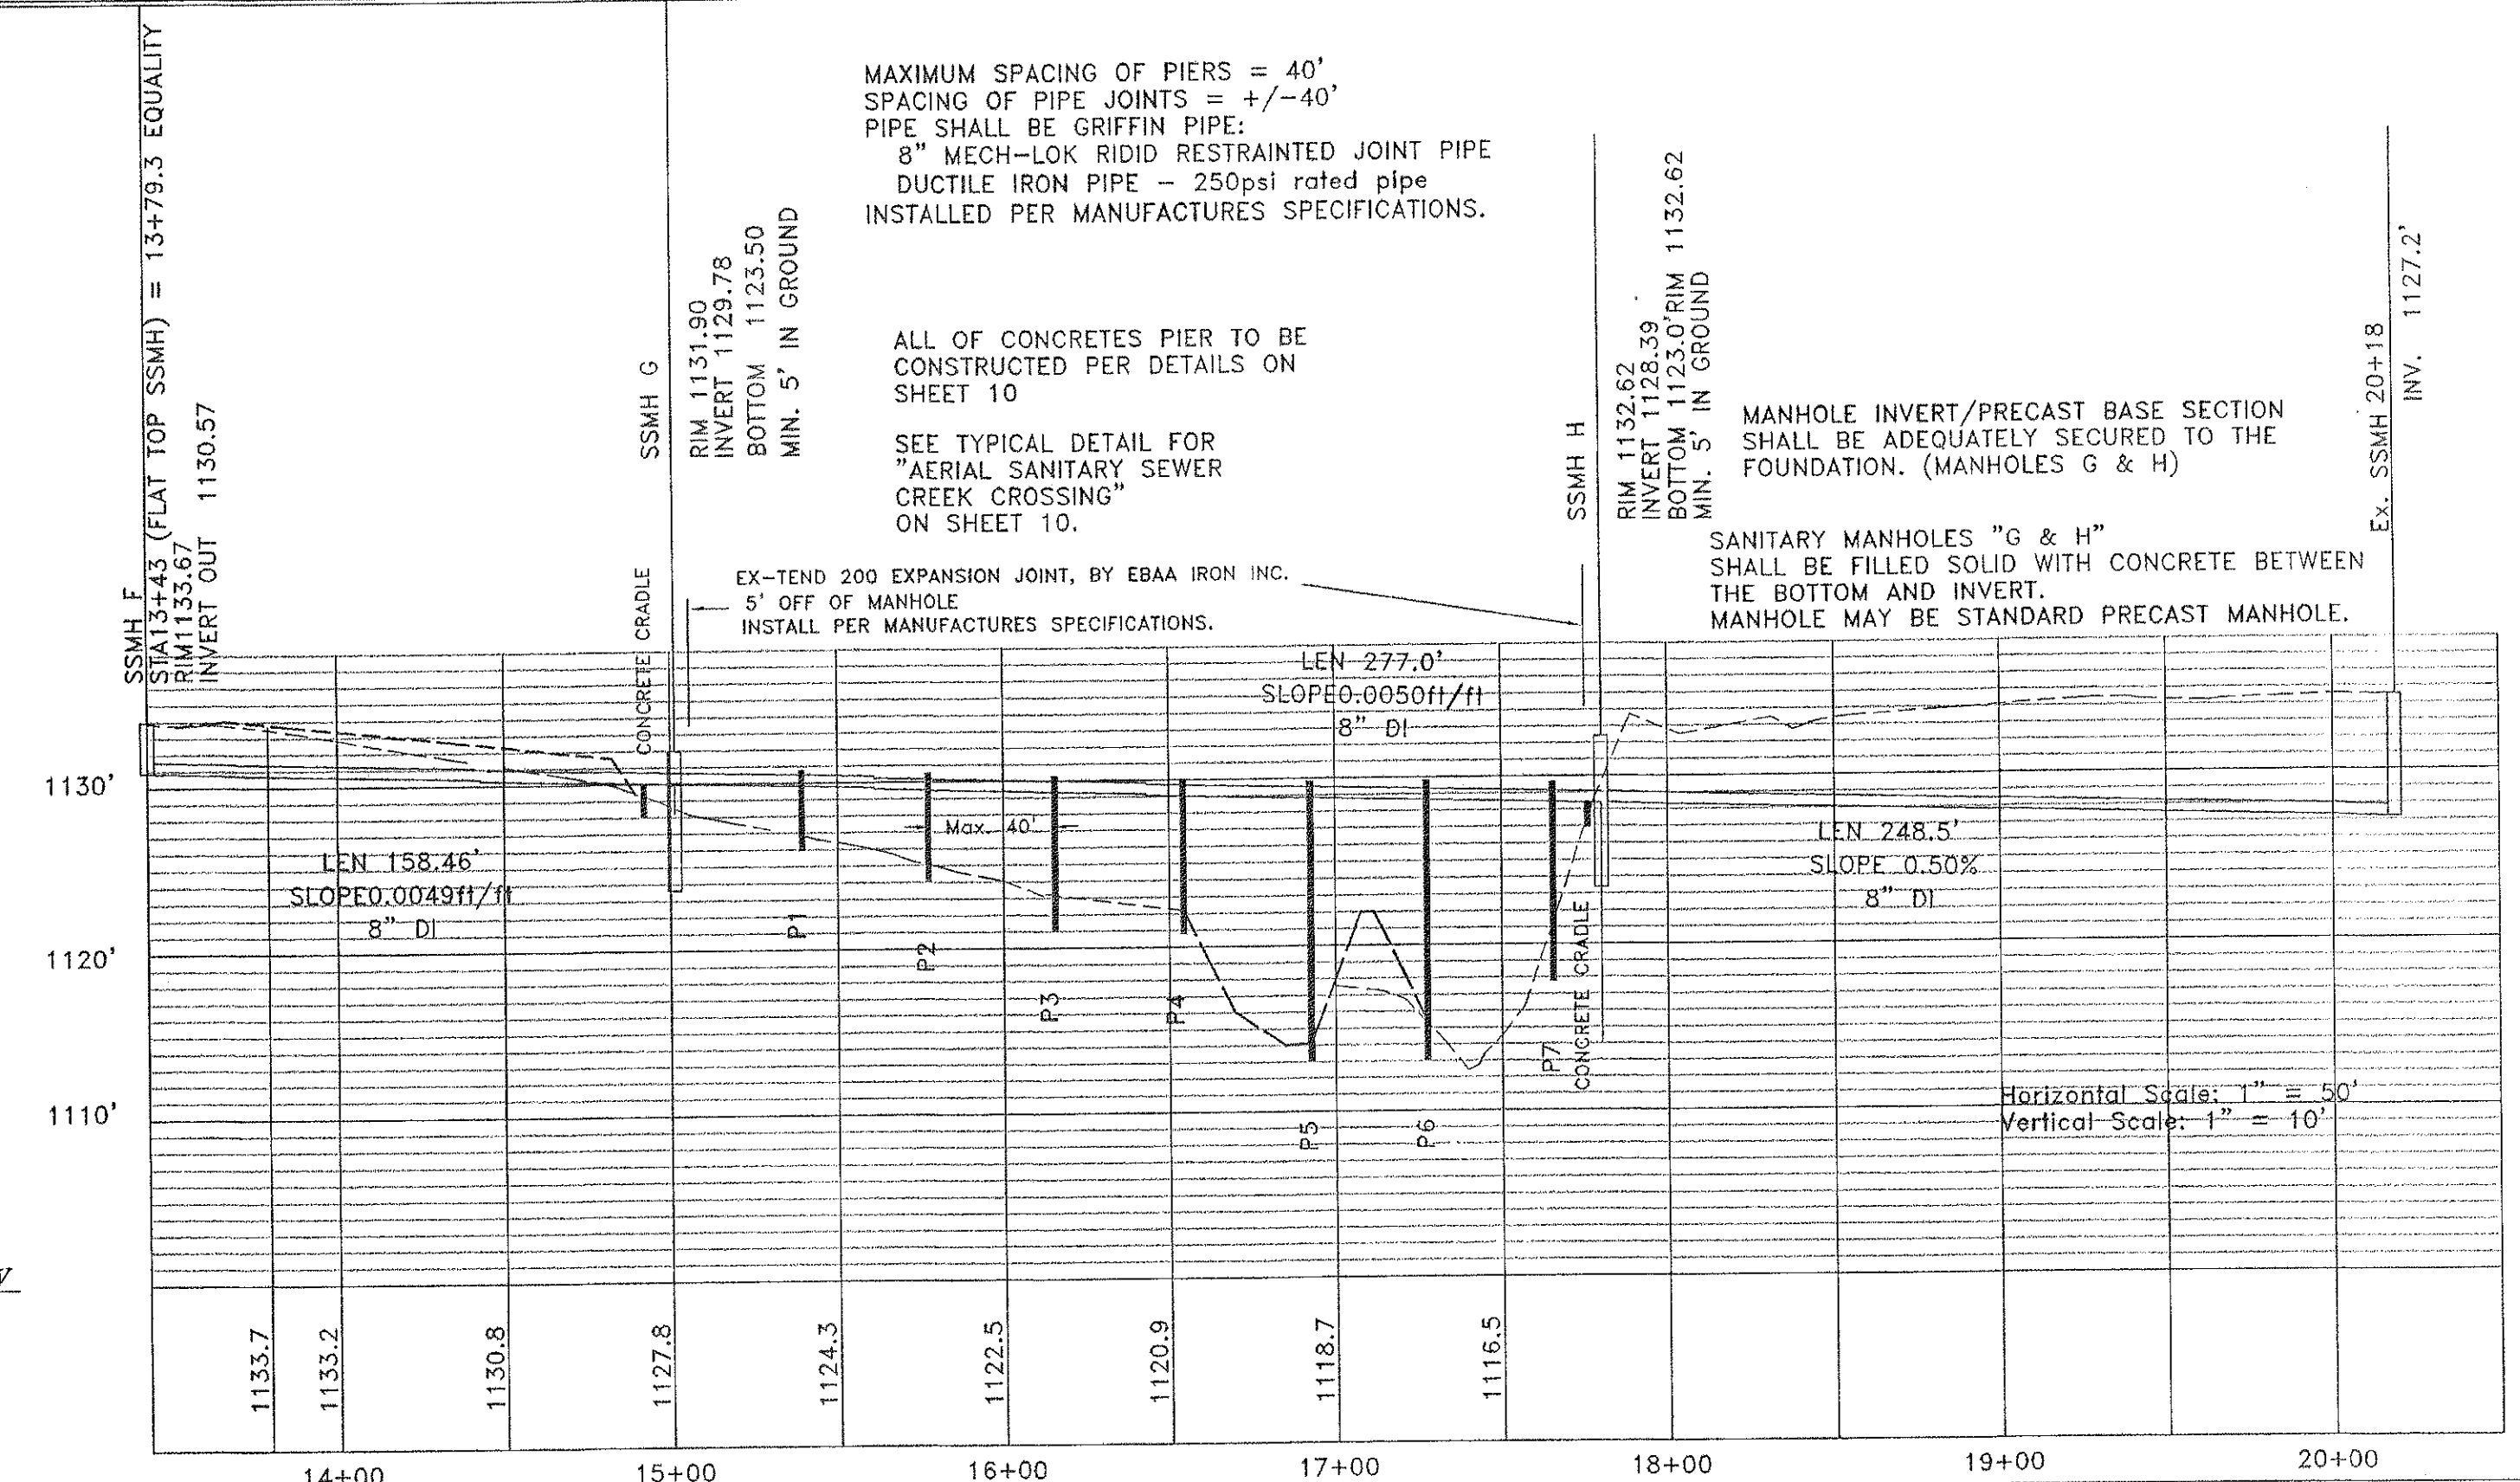

Roderick F. Pierson, P.E., L.L.S.
P.O. Box 311
1332 Roanoke Road, 220 North
Daleville, VA 24083
(540) 966-3027

REV	DATE	DESCRIPTION
1	10/01/01	PER COUNTY COMMENTS
2	11/12/01	PER COUNTY COMMENTS
3	12/31/01	PER COUNTY COMMENTS
4	02/12/02	PER COUNTY COMMENTS
5	02/25/02	PER COUNTY UTILITY DEPT. COMMENTS

SEWERLINE PROFILE SHEET
LINNMEAD SUBDIVISION
ROANOKE COUNTY, VIRGINIA

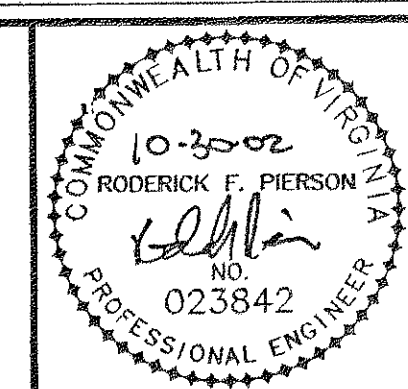

SCALE: 1" = 50'
COMM. NO. R200123
DATE: 04/25/01
SHEET 3

PETERCROFT/SHS

RC-9158