



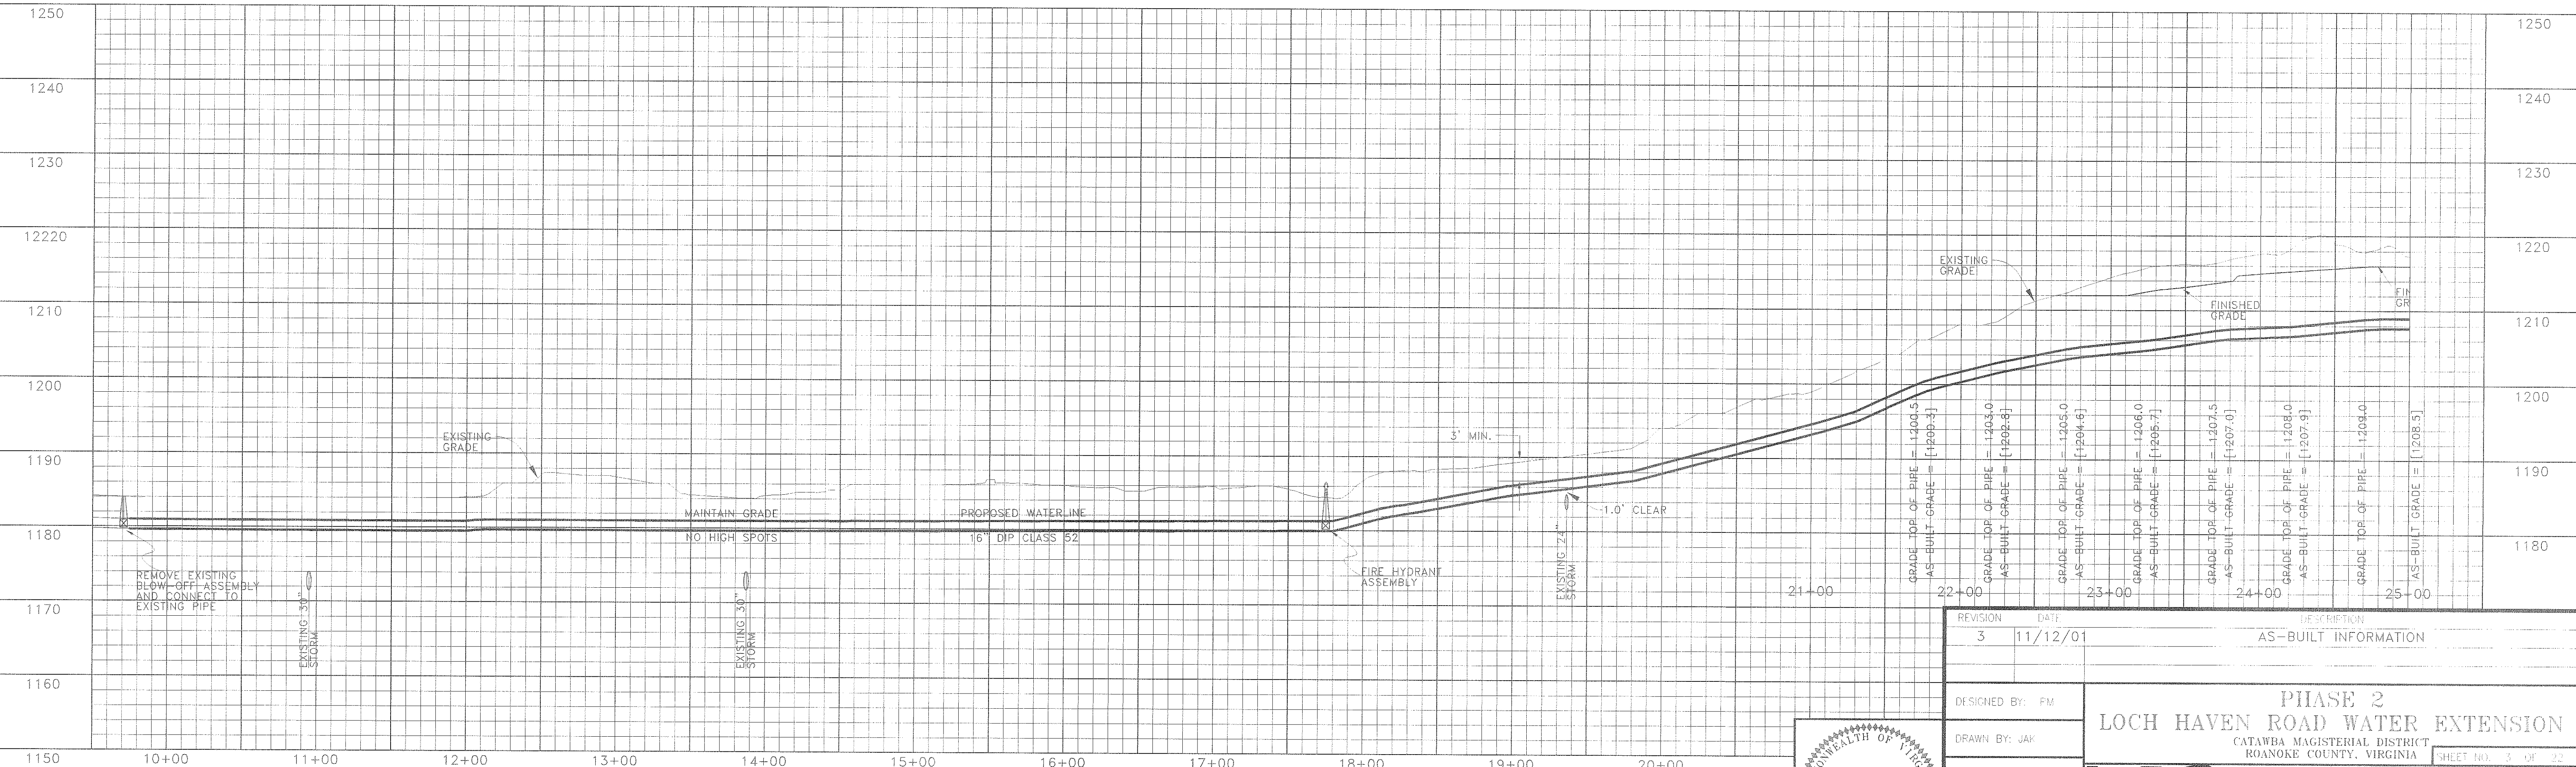

REVISION	DATE	DESCRIPTION
3	11/12/01	AS-BUILT INFORMATION

DESIGNED BY: FM	PHASE 2 LOCH HAVEN ROAD WATER EXTENSION CATAWBA MAGISTERIAL DISTRICT ROANOKE COUNTY, VIRGINIA SHEET NO. 3 OF 22
DRAWN BY: JAK	
CHECKED BY:	
SCALE: 1" = 50' HOR. 1" = 10' VERT.	
DATE: 14 MARCH 2000	

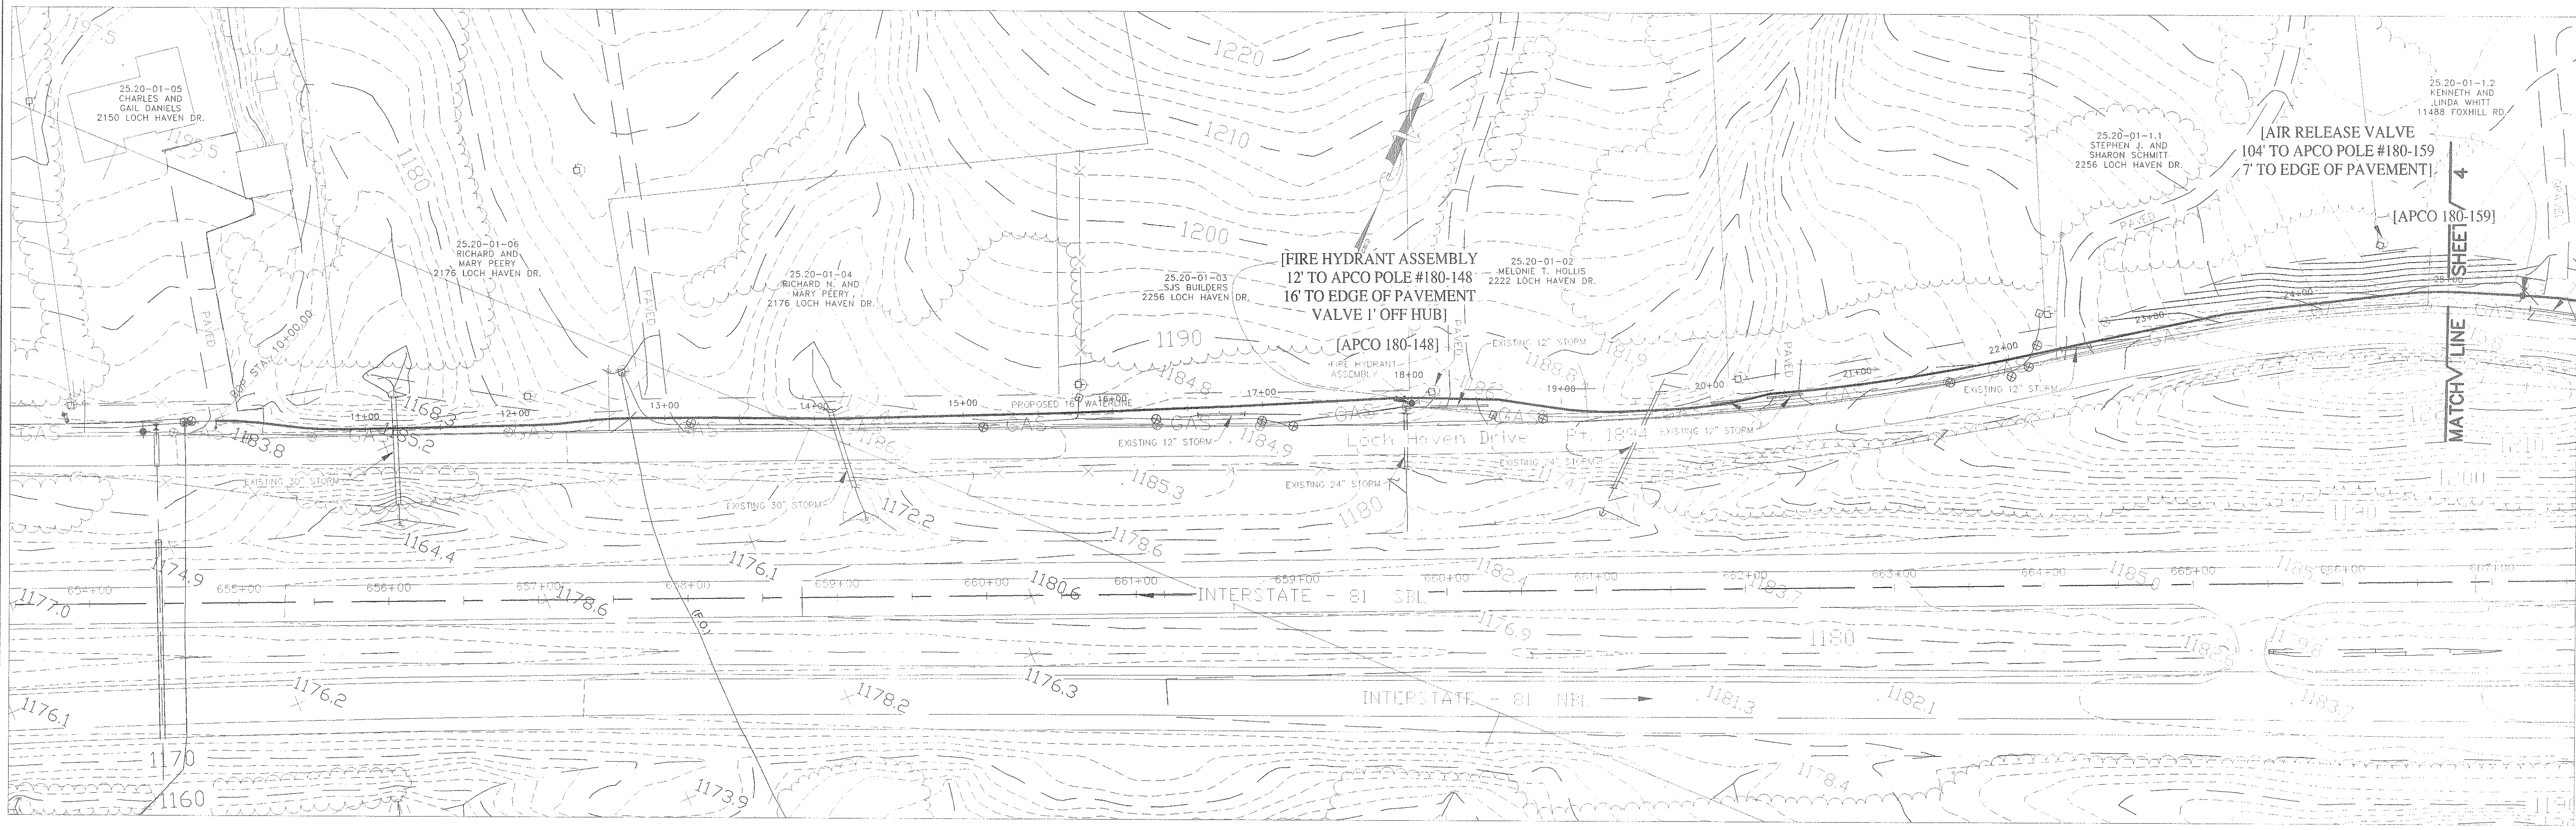