
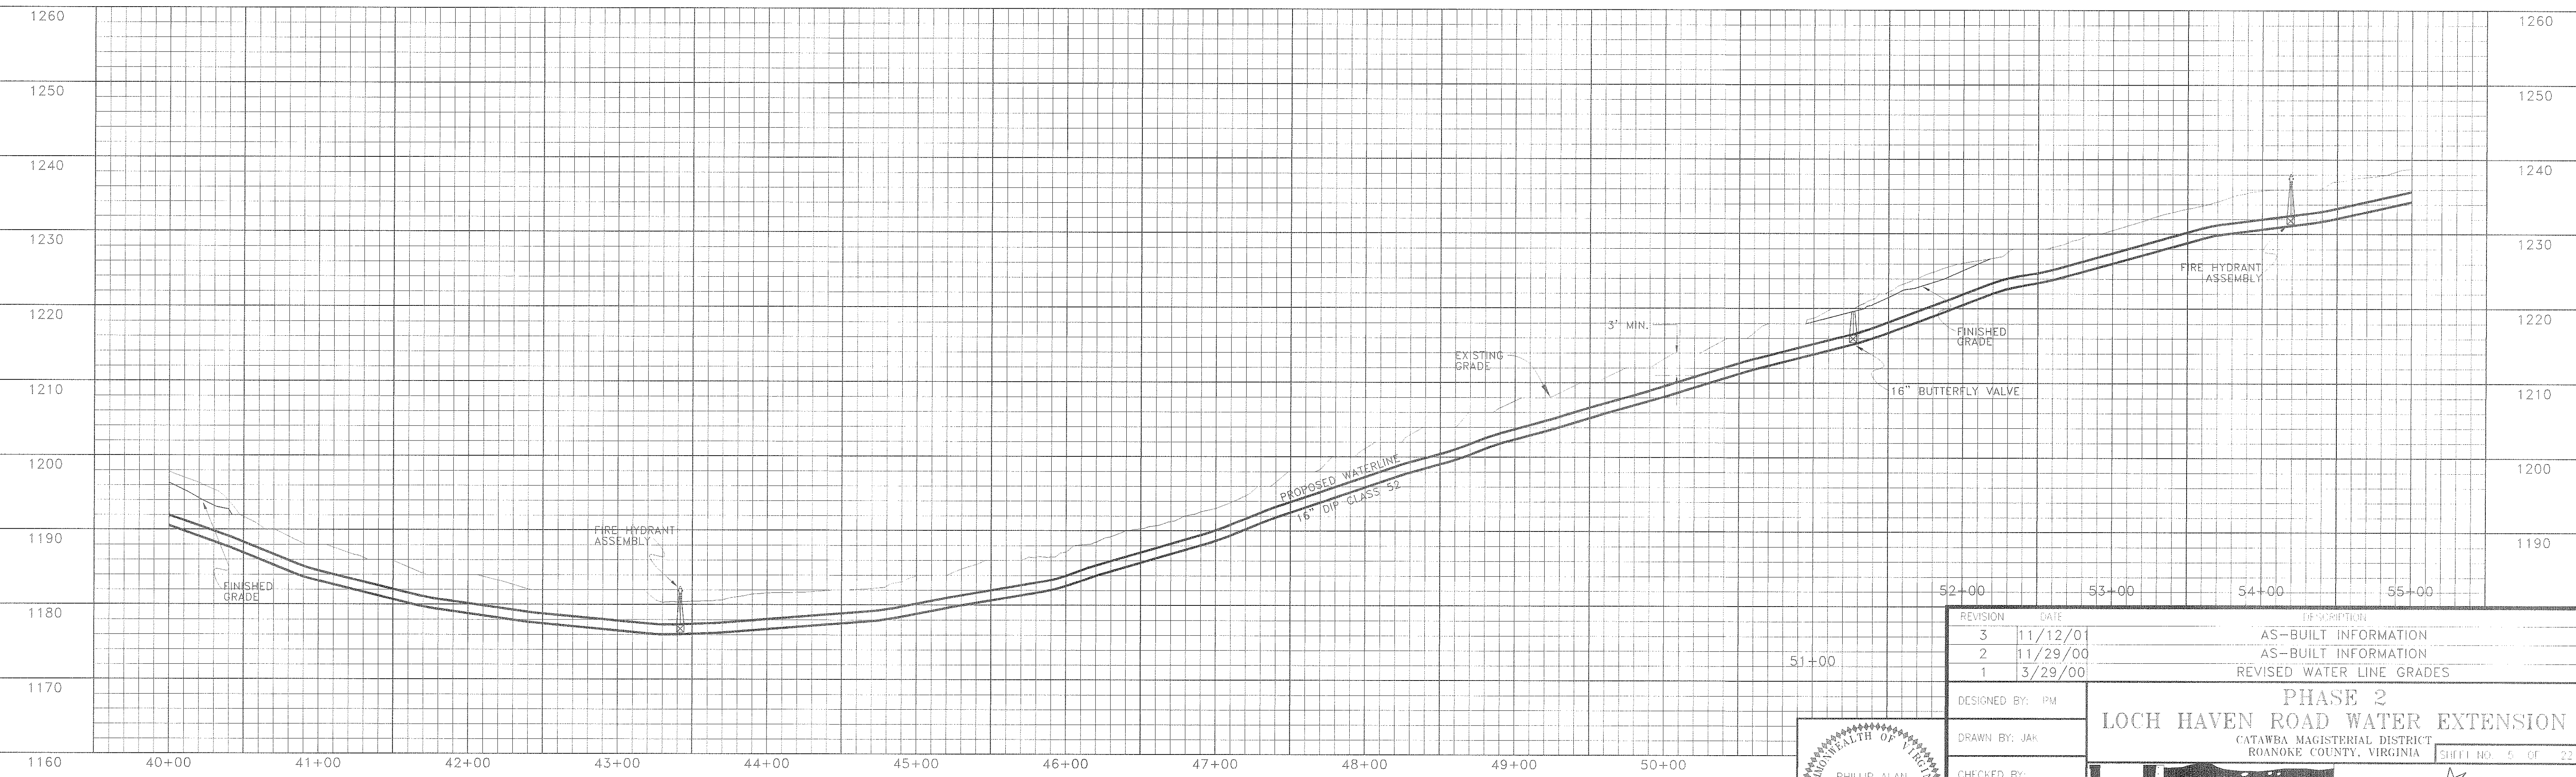


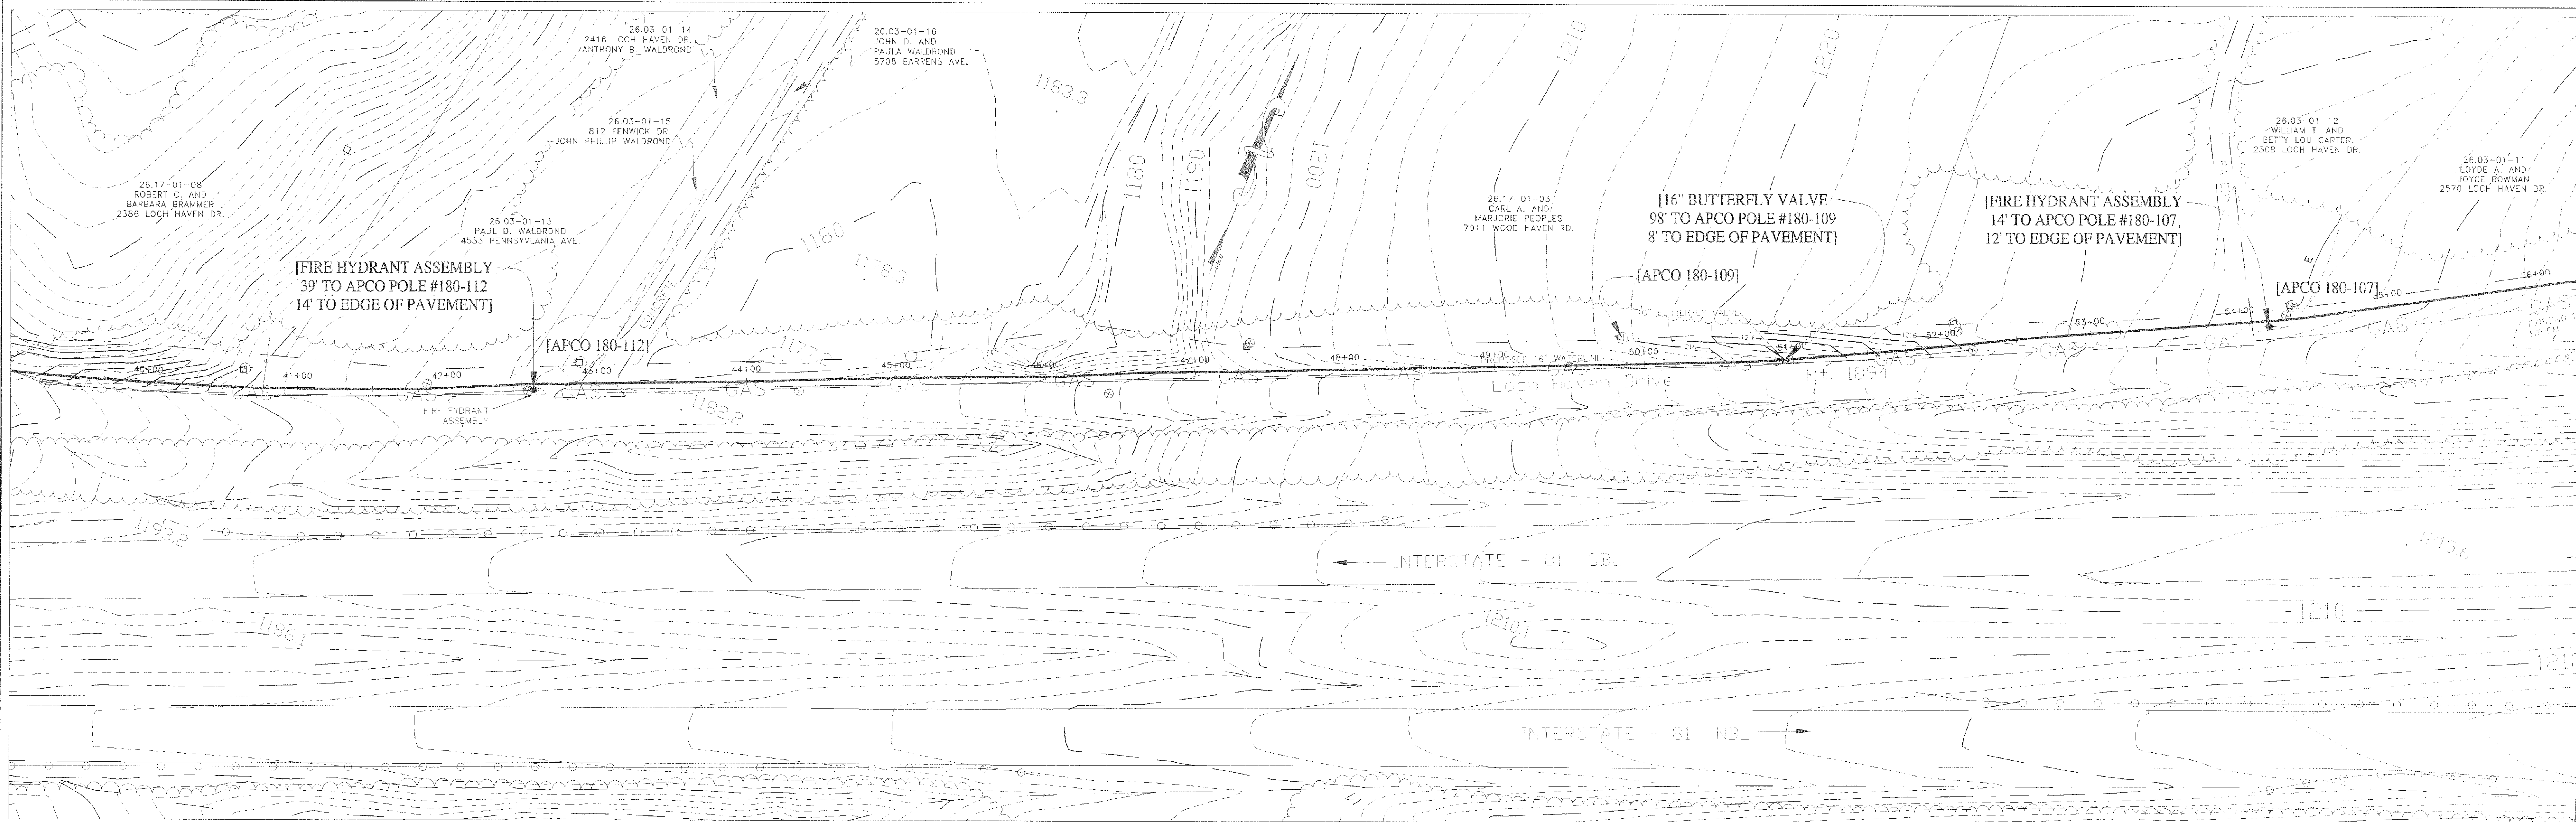

| REVISION | DATE     | DESCRIPTION               |
|----------|----------|---------------------------|
| 3        | 11/12/01 | AS-BUILT INFORMATION      |
| 2        | 11/29/00 | AS-BUILT INFORMATION      |
| 1        | 3/29/00  | REVISED WATER LINE GRADES |

|                   |                                                                                                                      |
|-------------------|----------------------------------------------------------------------------------------------------------------------|
| DESIGNED BY: PM   | <b>PHASE 2</b><br><b>LOCH HAVEN ROAD WATER EXTENSION</b><br>CATAWBA MAGISTERIAL DISTRICT<br>ROANOKE COUNTY, VIRGINIA |
| DRAWN BY: JAK     |                                                                                                                      |
| CHECKED BY:       |                                                                                                                      |
| DATE: XX 000 1999 |                                                                                                                      |

PHILLIP ALAN MARTIN  
No. 030630  
PROFESSIONAL ENGINEER

ROANOKE COUNTY, VIRGINIA  
UTILITY DEPARTMENT

ROANOKE  
VIRGINIA, CHARTERED 1882