

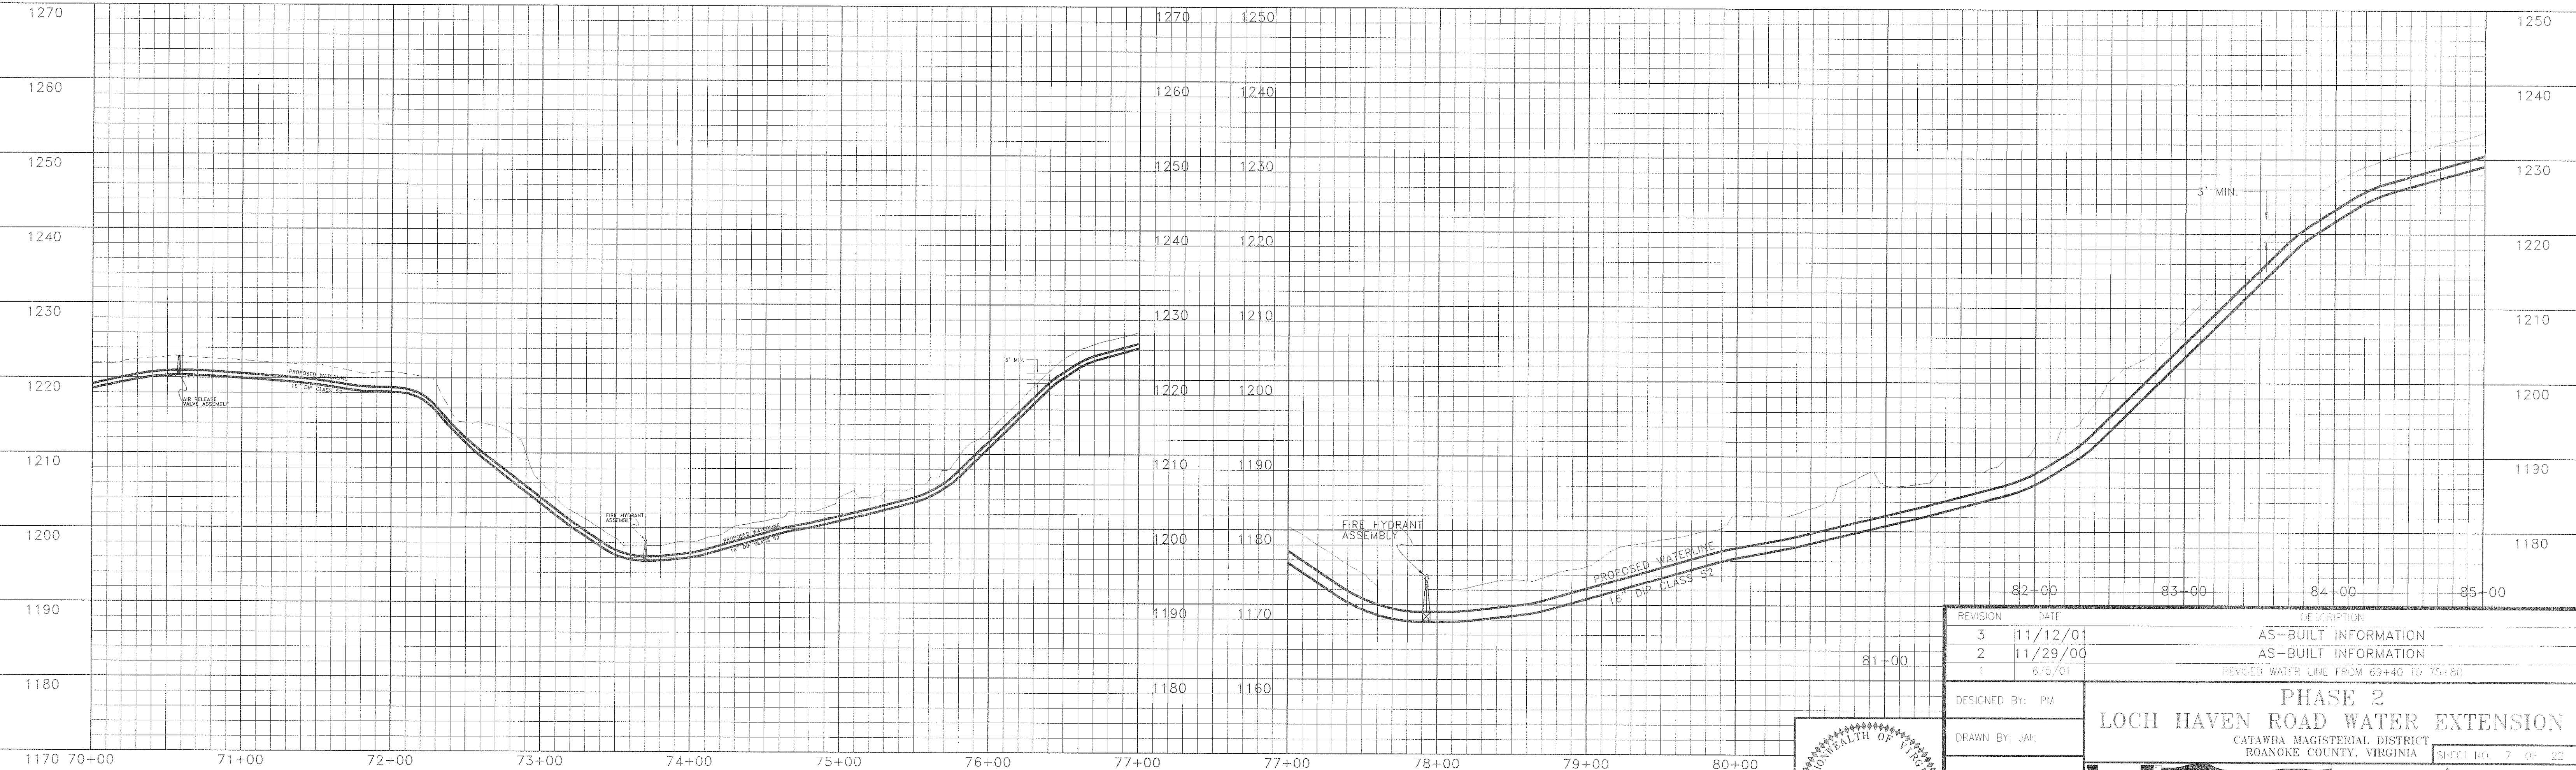


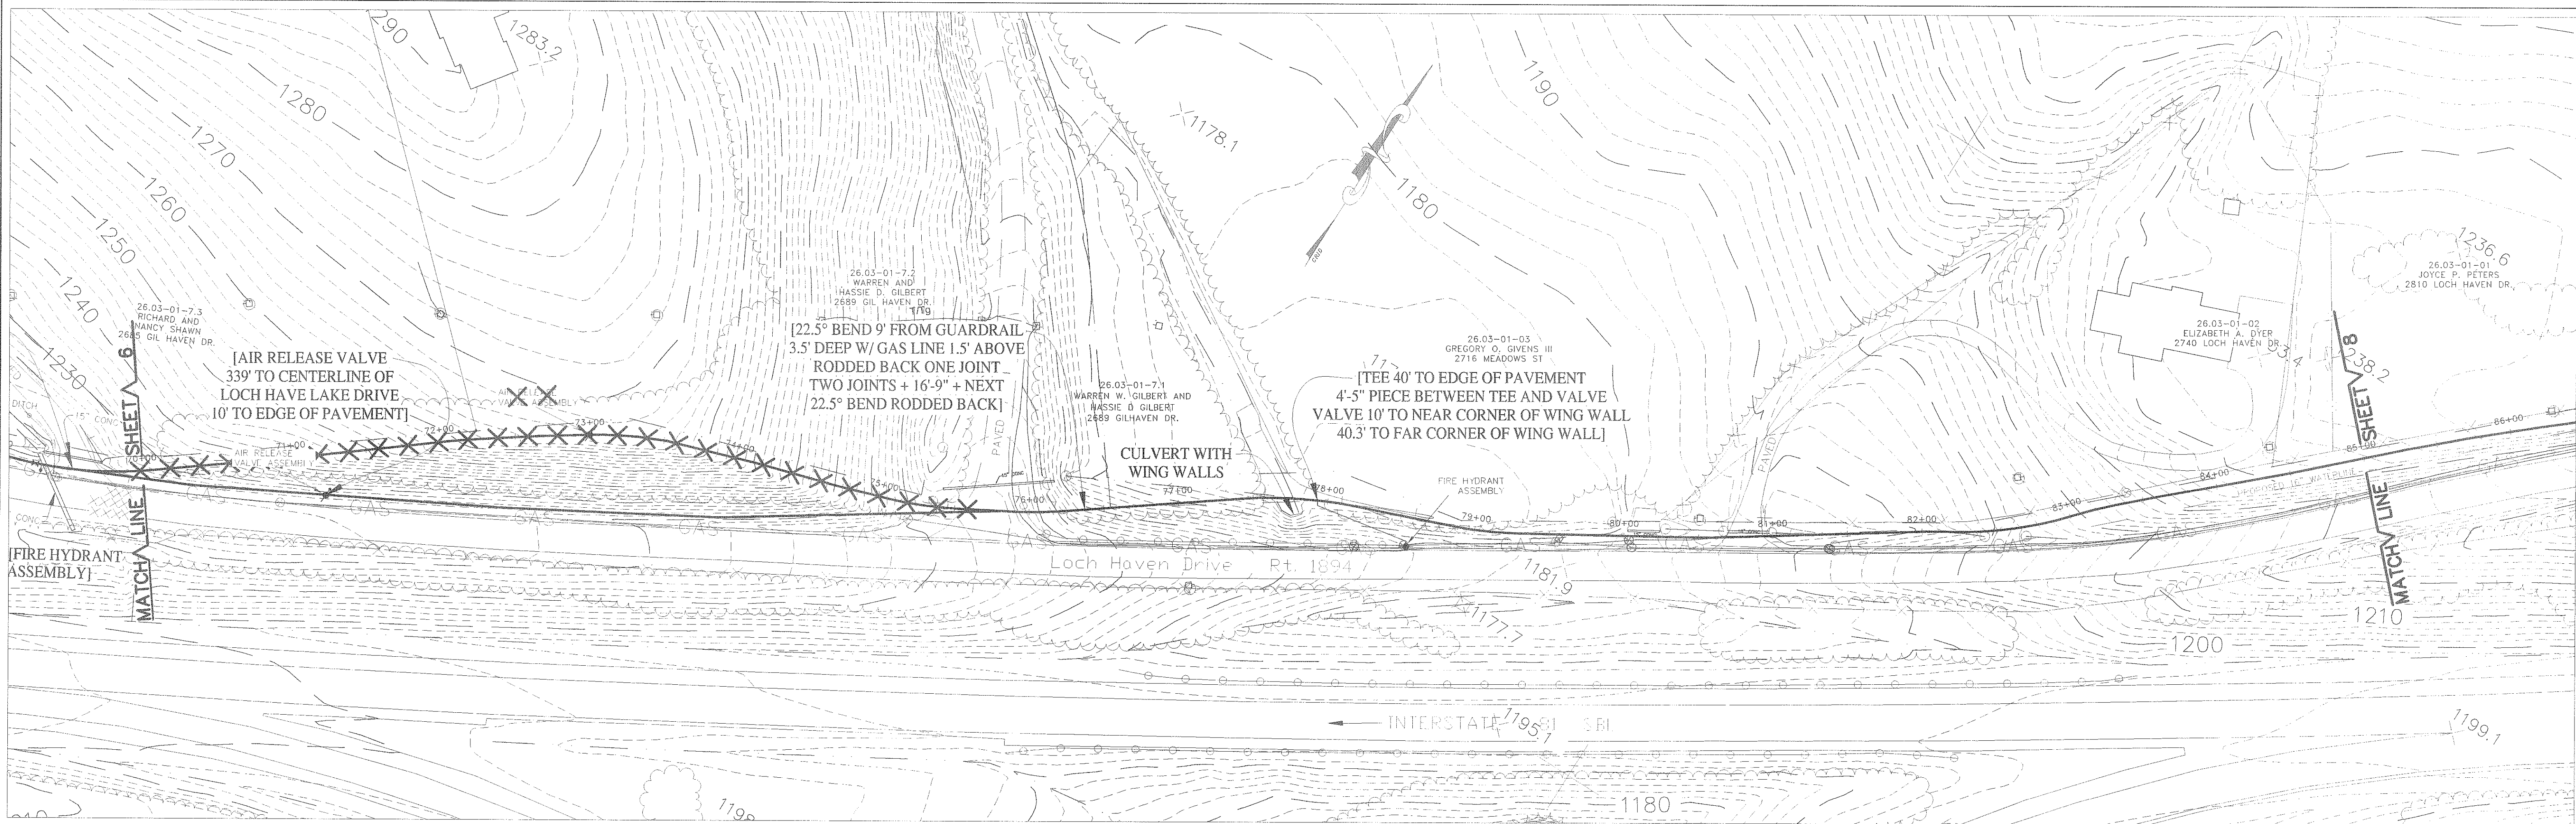

REVISION	DATE	DESCRIPTION
3	11/12/01	AS-BUILT INFORMATION
2	11/29/00	AS-BUILT INFORMATION
1	6/5/01	REVISED WATER LINE FROM 69+40 TO 75+180

DESIGNED BY: PM	PHASE 2 LOCH HAVEN ROAD WATER EXTENSION CATAWBA MAGISTERIAL DISTRICT ROANOKE COUNTY, VIRGINIA
DRAWN BY: JAK	
CHECKED BY:	
DATE: 14 MARCH 2000	

SCALE: 1"= 50' HOR. 1"= 10' VERT.	 ROANOKE COUNTY, VIRGINIA UTILITY DEPARTMENT	 ROANOKE VIRGINIA, CHARTERED 1882
--------------------------------------	---	--

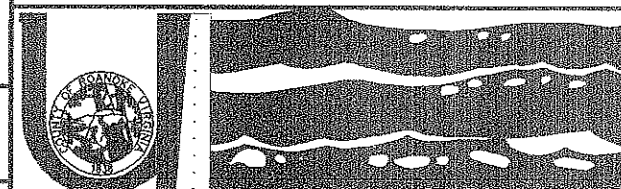