

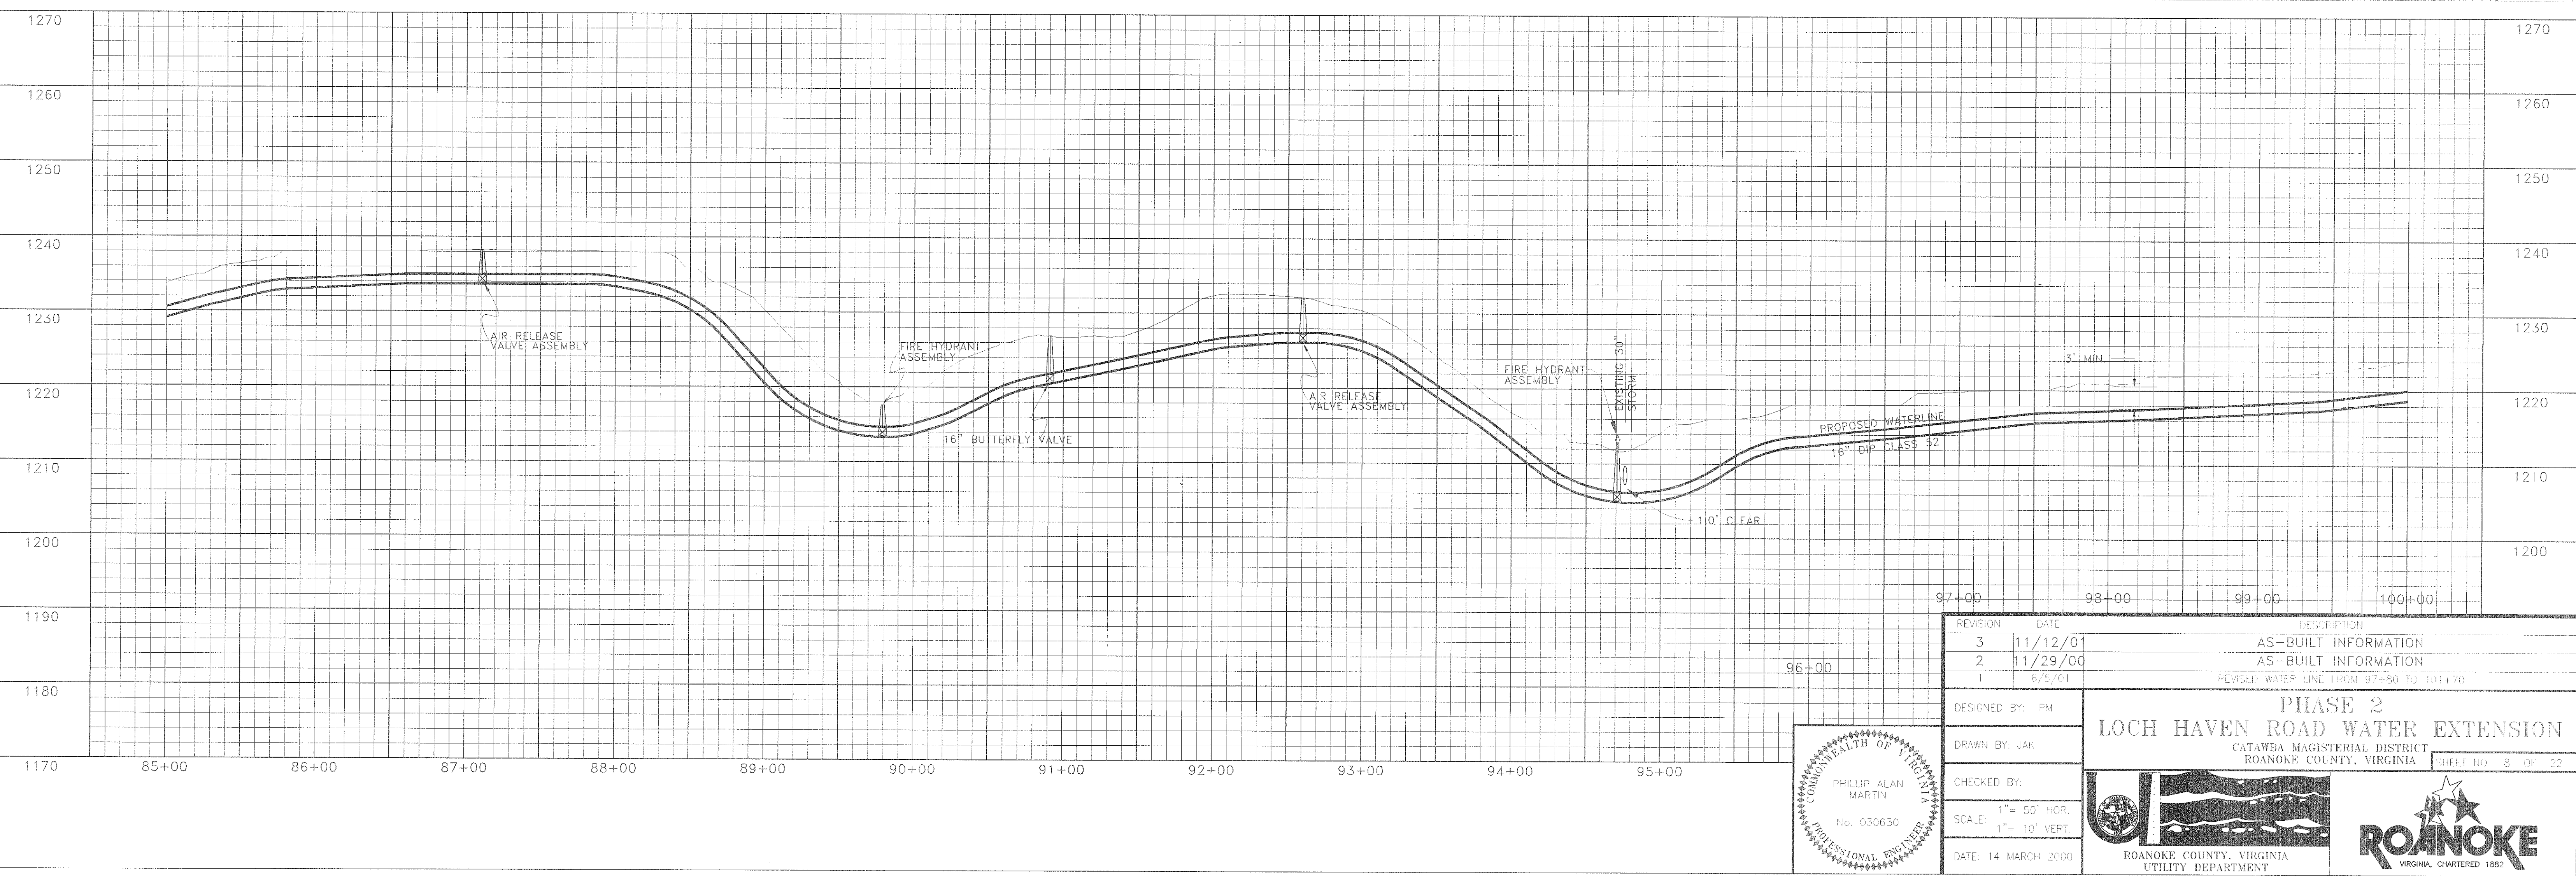


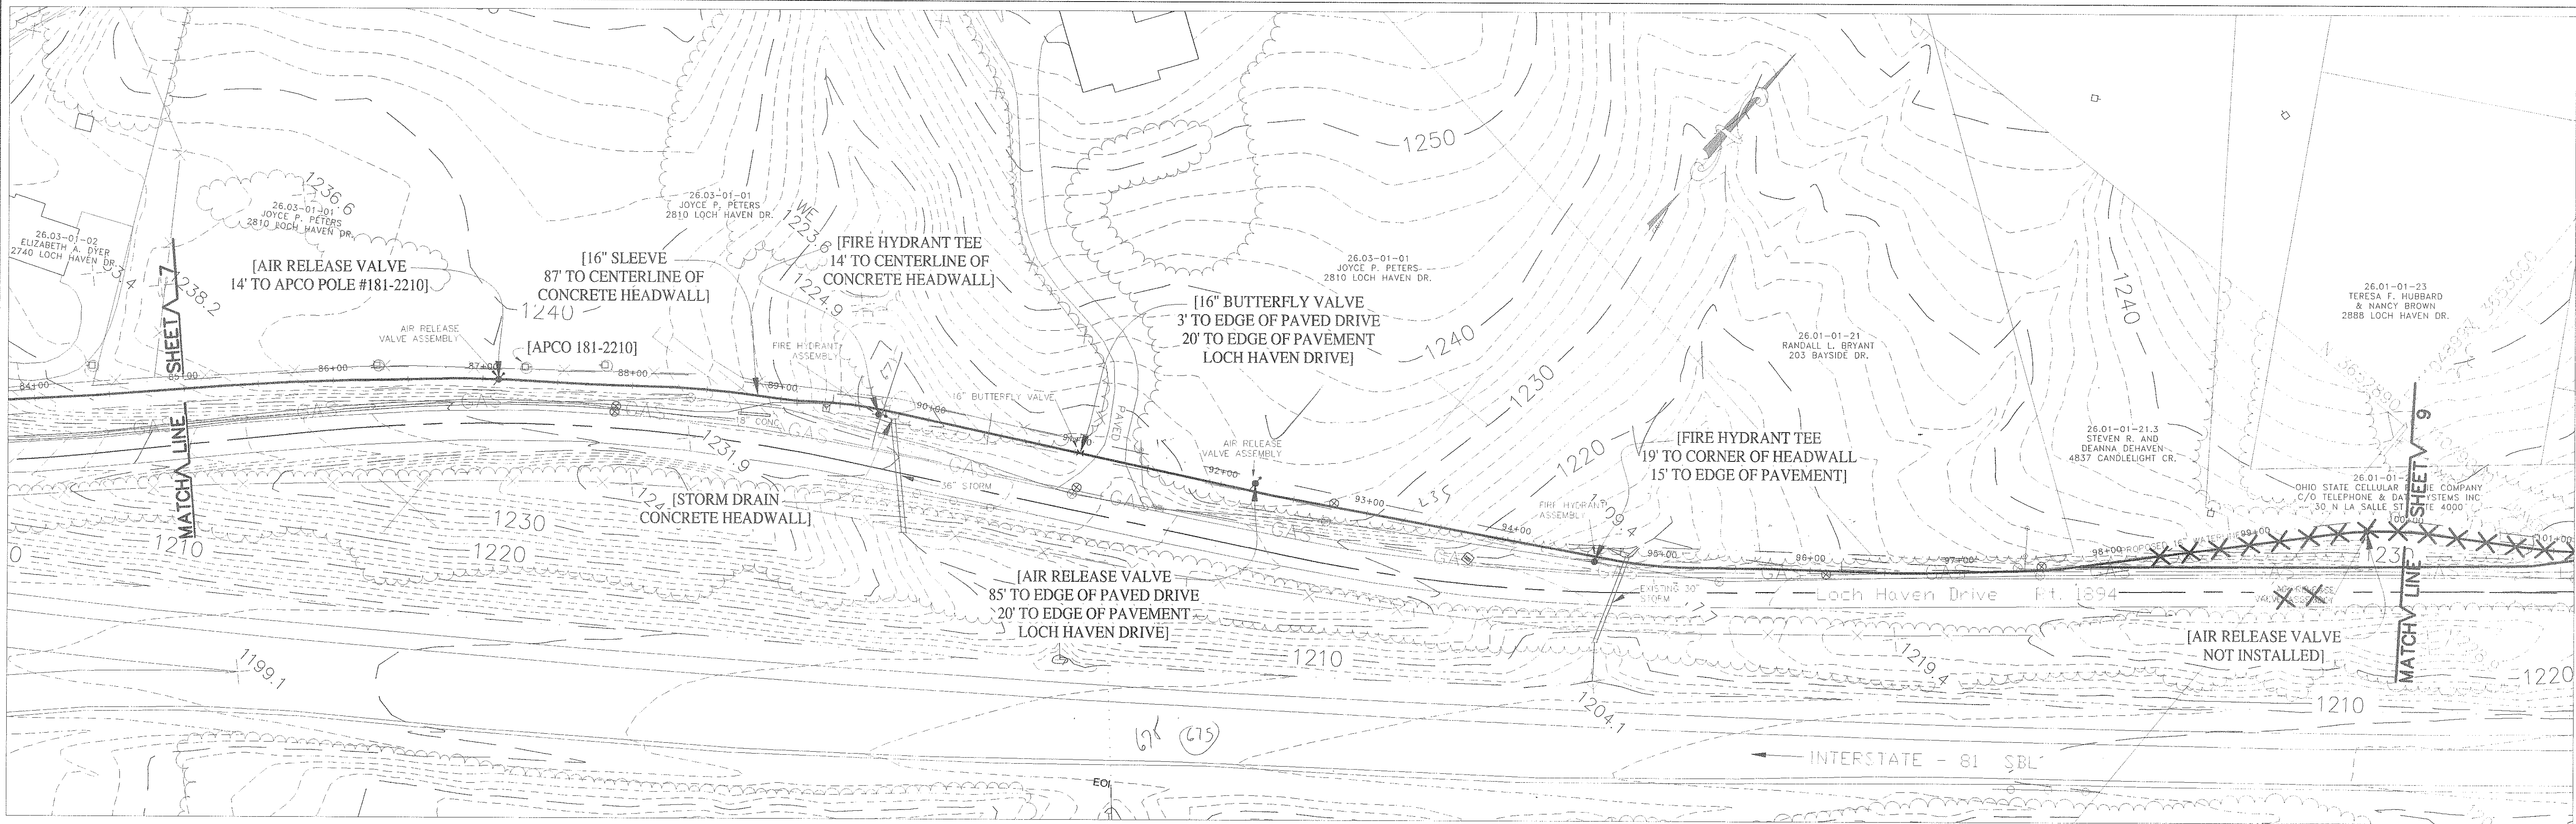

REVISION	DATE	DESCRIPTION
3	11/12/01	AS-BUILT INFORMATION
2	11/29/00	AS-BUILT INFORMATION
1	6/5/01	REVISED WATER LINE FROM 97+80' TO 101+70'

DESIGNED BY: PM	PHASE 2 LOCH HAVEN ROAD WATER EXTENSION CATAWBA MAGISTERIAL DISTRICT ROANOKE COUNTY, VIRGINIA	 ROANOKE COUNTY, VIRGINIA UTILITY DEPARTMENT
DRAWN BY: JAK		
CHECKED BY:		
SCALE: 1"= 50' HOR. 1"= 10' VERT.		
DATE: 14 MARCH 2000		 ROANOKE VIRGINIA, CHARTERED 1882

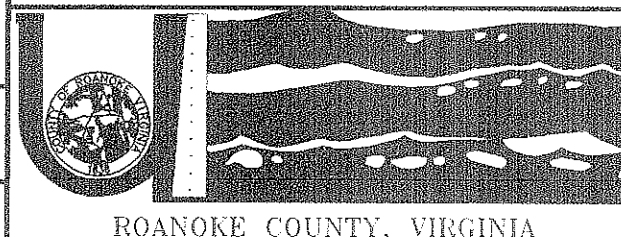