



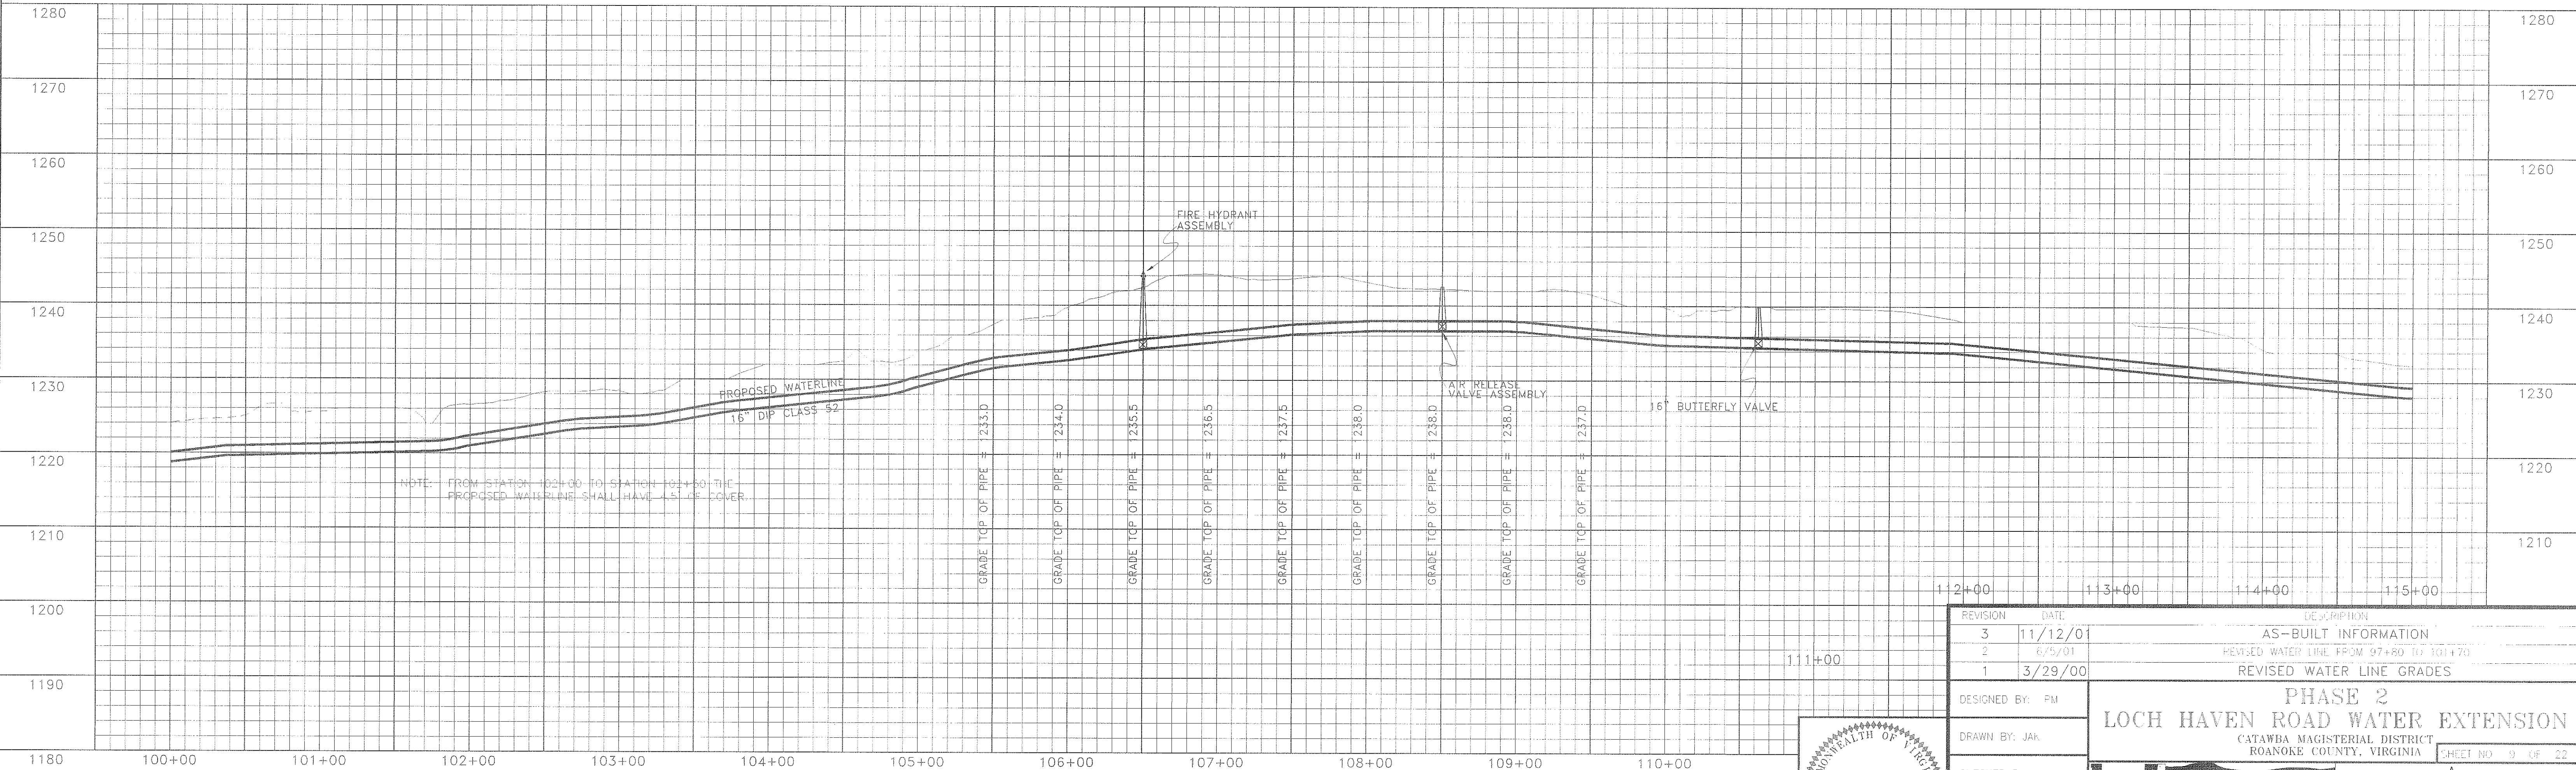

REVISION	DATE	DESCRIPTION
3	11/12/01	AS-BUILT INFORMATION
2	6/5/01	REVISED WATER LINE FROM 97+80 TO 101+70
1	3/29/00	REVISED WATER LINE GRADES

DESIGNED BY: FM	PHASE 2 LOCH HAVEN ROAD WATER EXTENSION CATAWBA MAGISTERIAL DISTRICT ROANOKE COUNTY, VIRGINIA
DRAWN BY: JAK	
CHECKED BY:	
SCALE: 1"= 50' HOR. 1"= 10' VERT.	SHEET NO. 9 OF 22
DATE: 14 MARCH 2000	

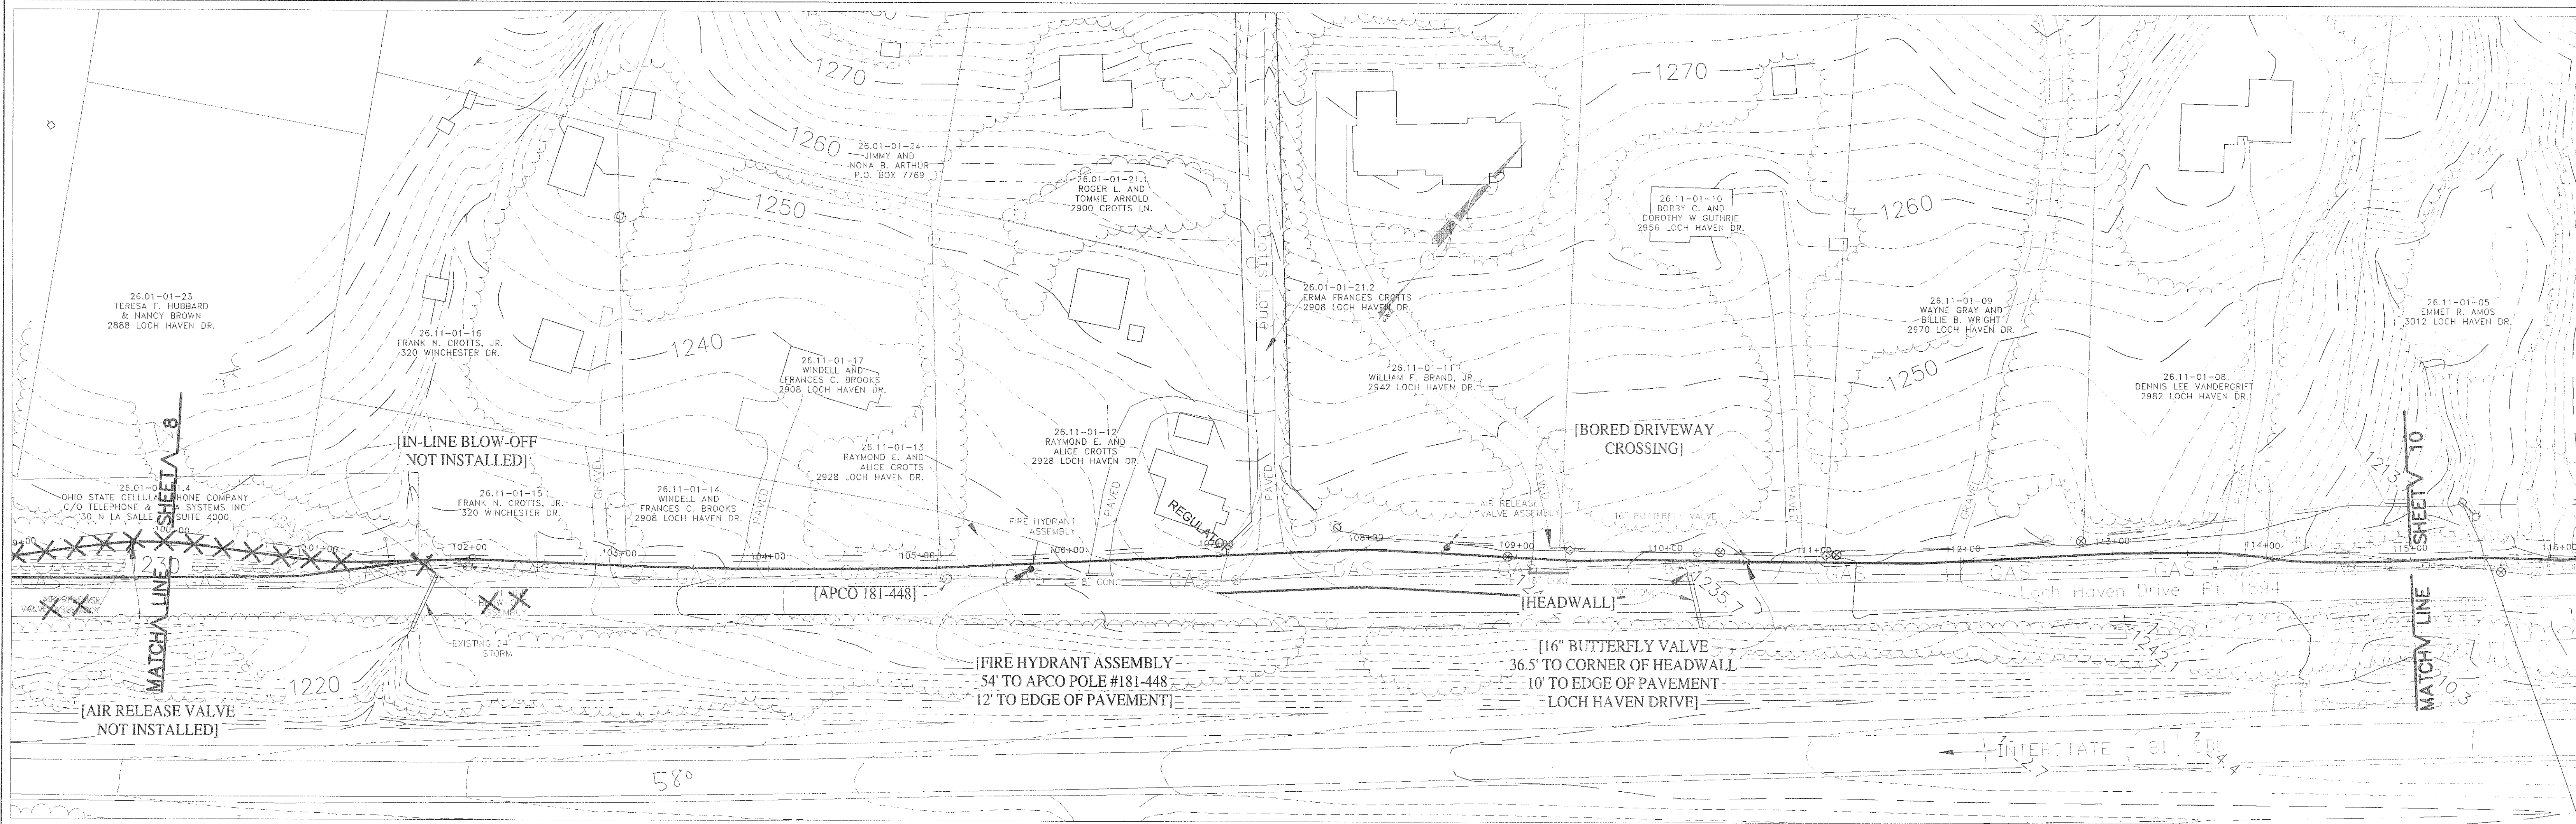