

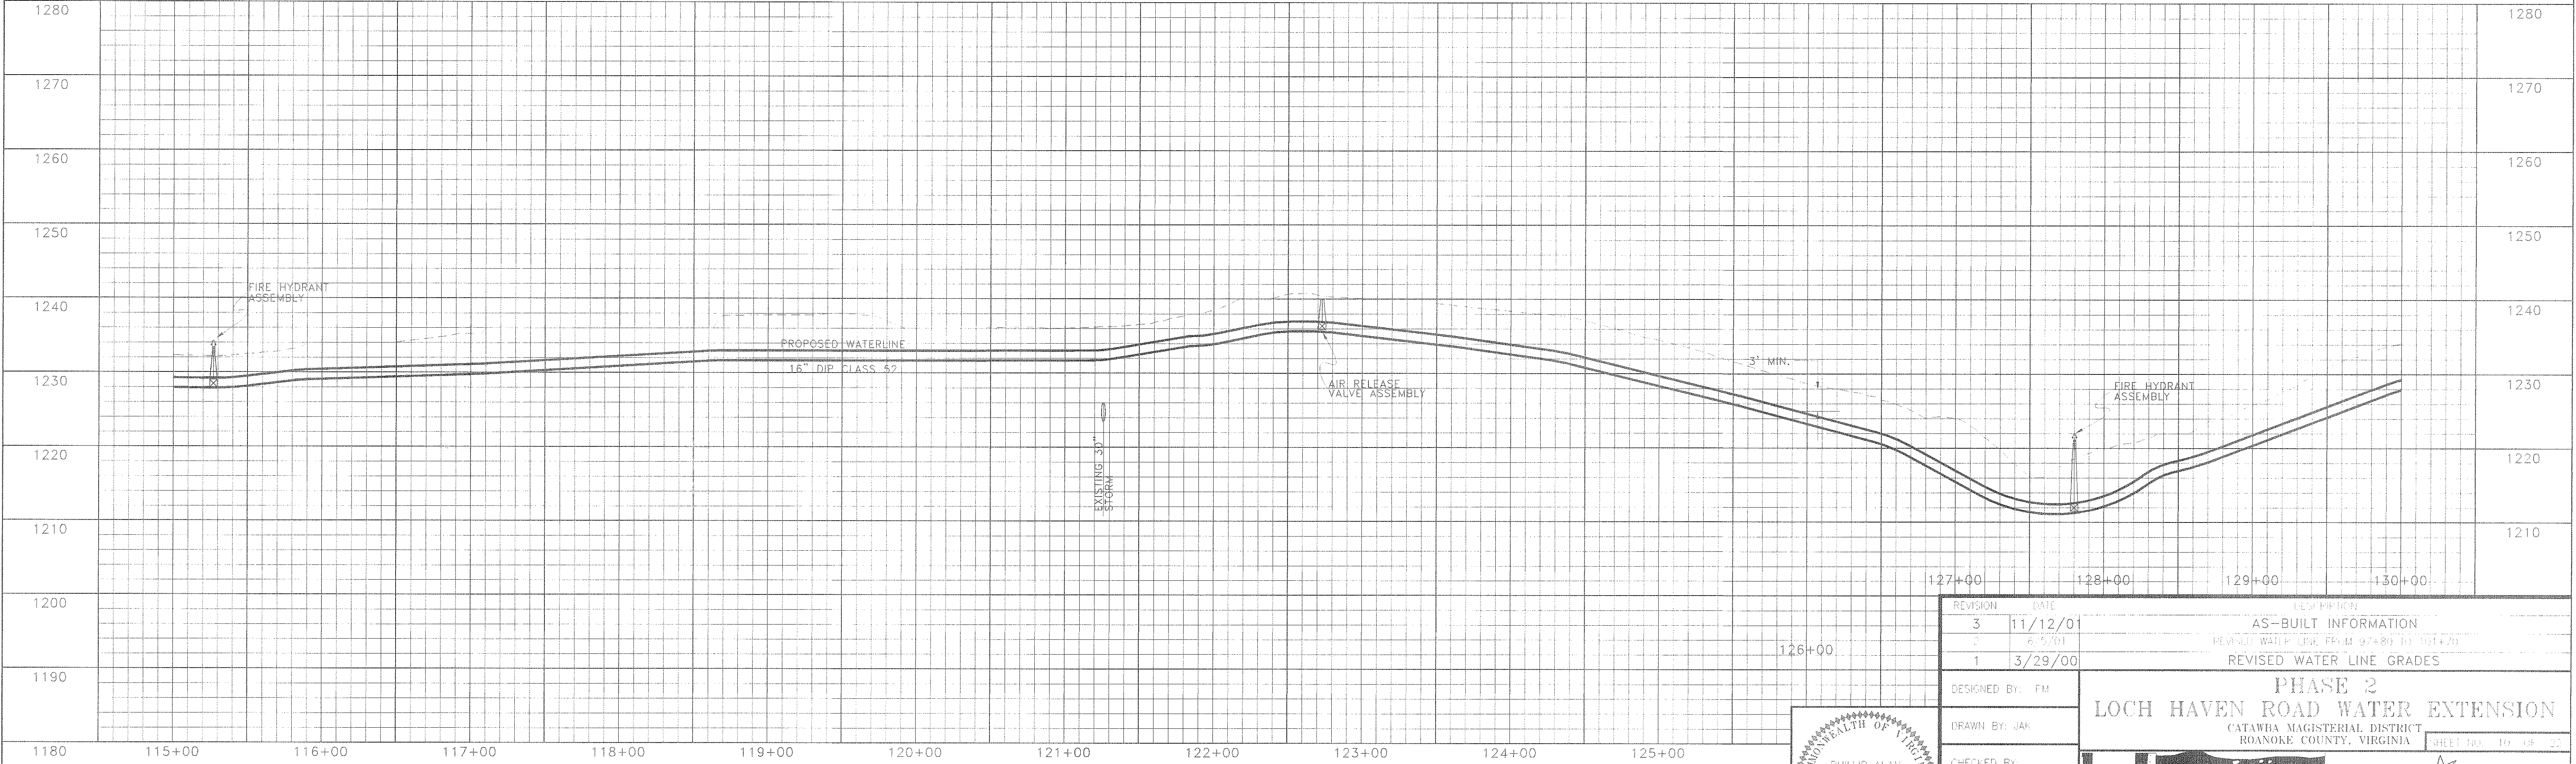


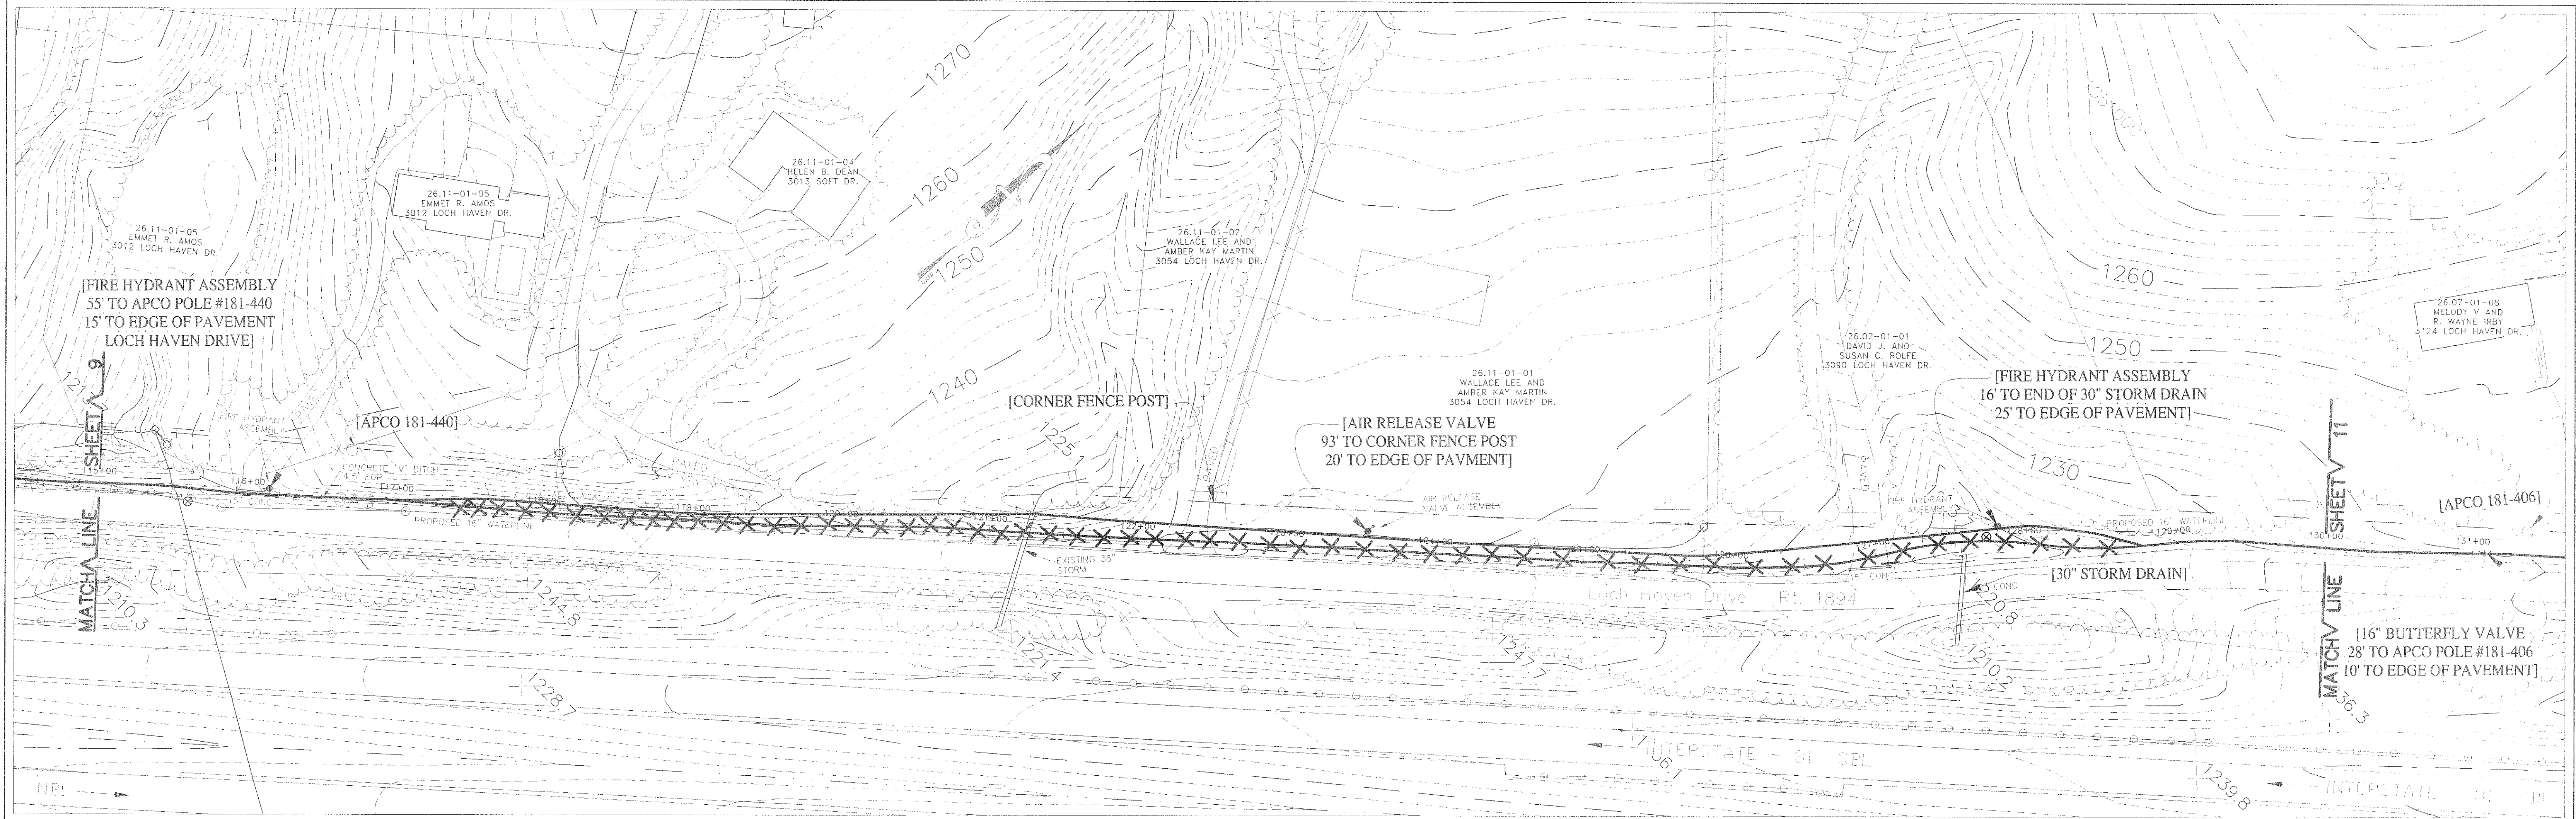

REVISION	DATE	DESCRIPTION
3	11/12/01	AS-BUILT INFORMATION
2	6/5/01	REVISED WATER LINE FROM 97+80 TO 101+70
1	3/29/00	REVISED WATER LINE GRADES

DESIGNED BY: FM	PHASE 2 LOCH HAVEN ROAD WATER EXTENSION CATAWHA MAGISTERIAL DISTRICT ROANOKE COUNTY, VIRGINIA		
DRAWN BY: JAK			
CHECKED BY:			
SCALE: 1"= 50' HOR. 1"= 10' VERT.			
DATE: 14 MARCH 2000		 ROANOKE COUNTY, VIRGINIA UTILITY DEPARTMENT	 ROANOKE VIRGINIA, CHARTERED 1882

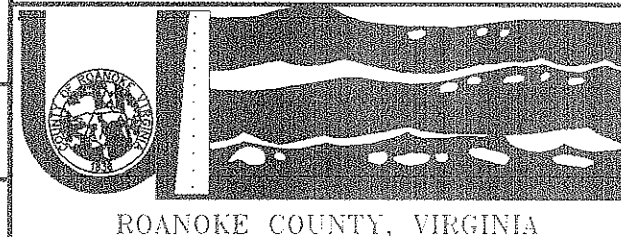