


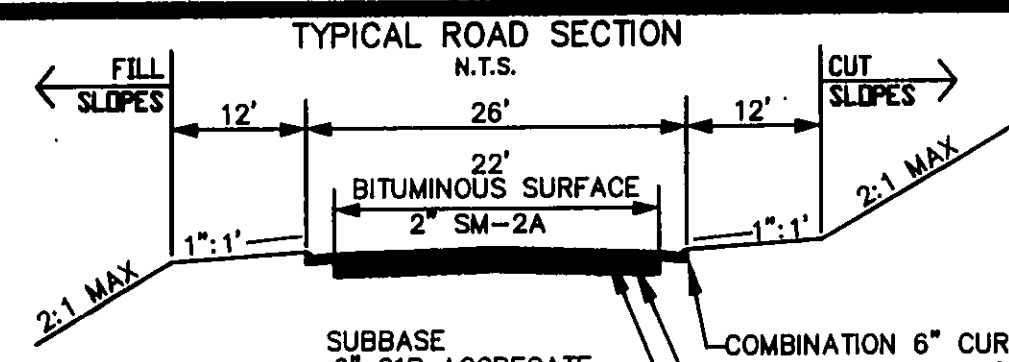


- ⑦ SANITARY SEWER STRUCTURE LABEL
- ④ STORM DRAIN STRUCTURE LABEL
- △ WATER LINE STRUCTURE
- ⑰ LOT NUMBER

WATER METER & SERVICE
4" S.S. LATERAL


ROAD CURVE DATA
LENGTH 242.12'
TANGENT 156.65'
RAD 150'
DELTA 92 29'05"

PROPERTY OF
PAULINE DOOLEY MORAN
D.B.1235 PG.233
TAX NO.3121806


PROPERTY OF
EDWARD L. CORSON II
D.B.1566 PG.709
TAX NO.3121808

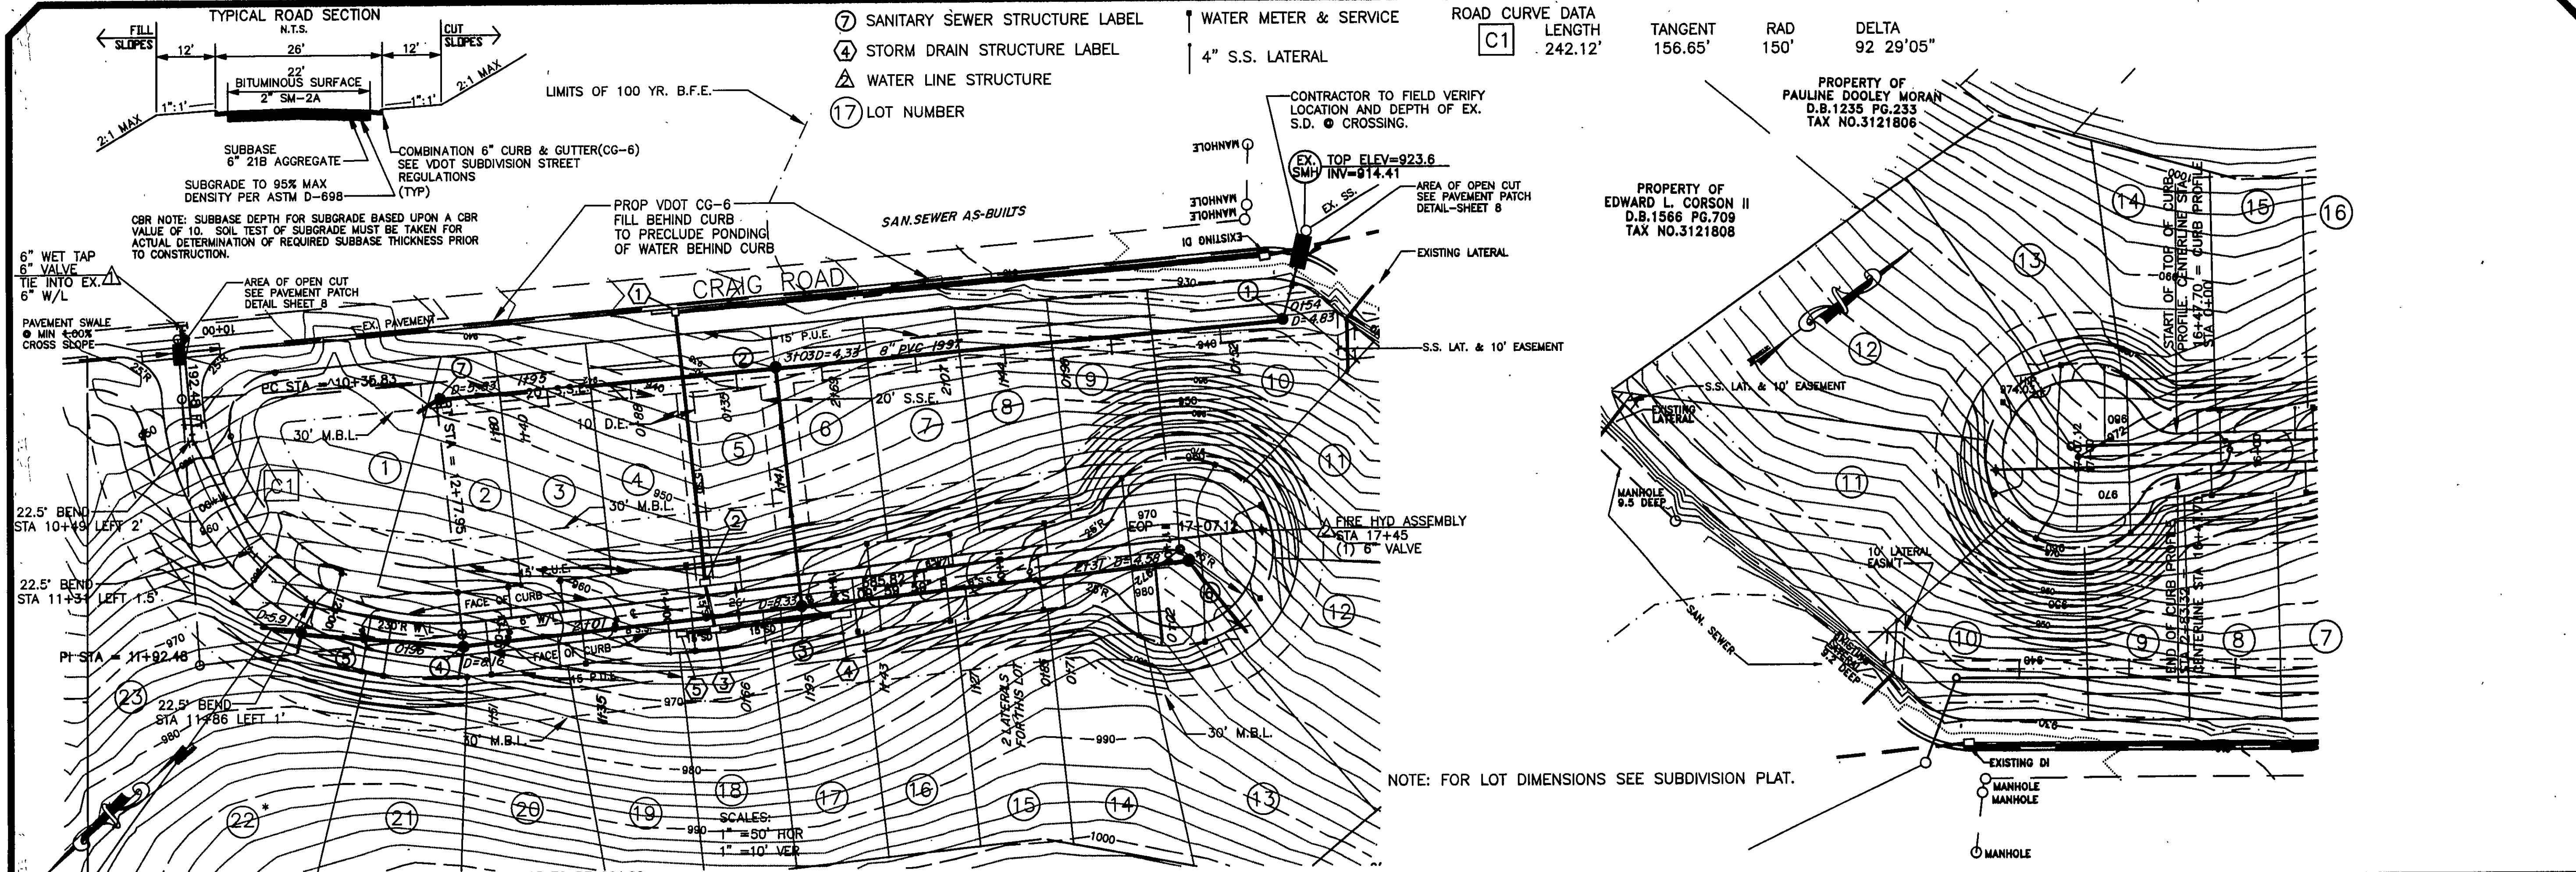

*NOTE: MIN FF. ELEV. @ LOT = 23 TO BE 964.00

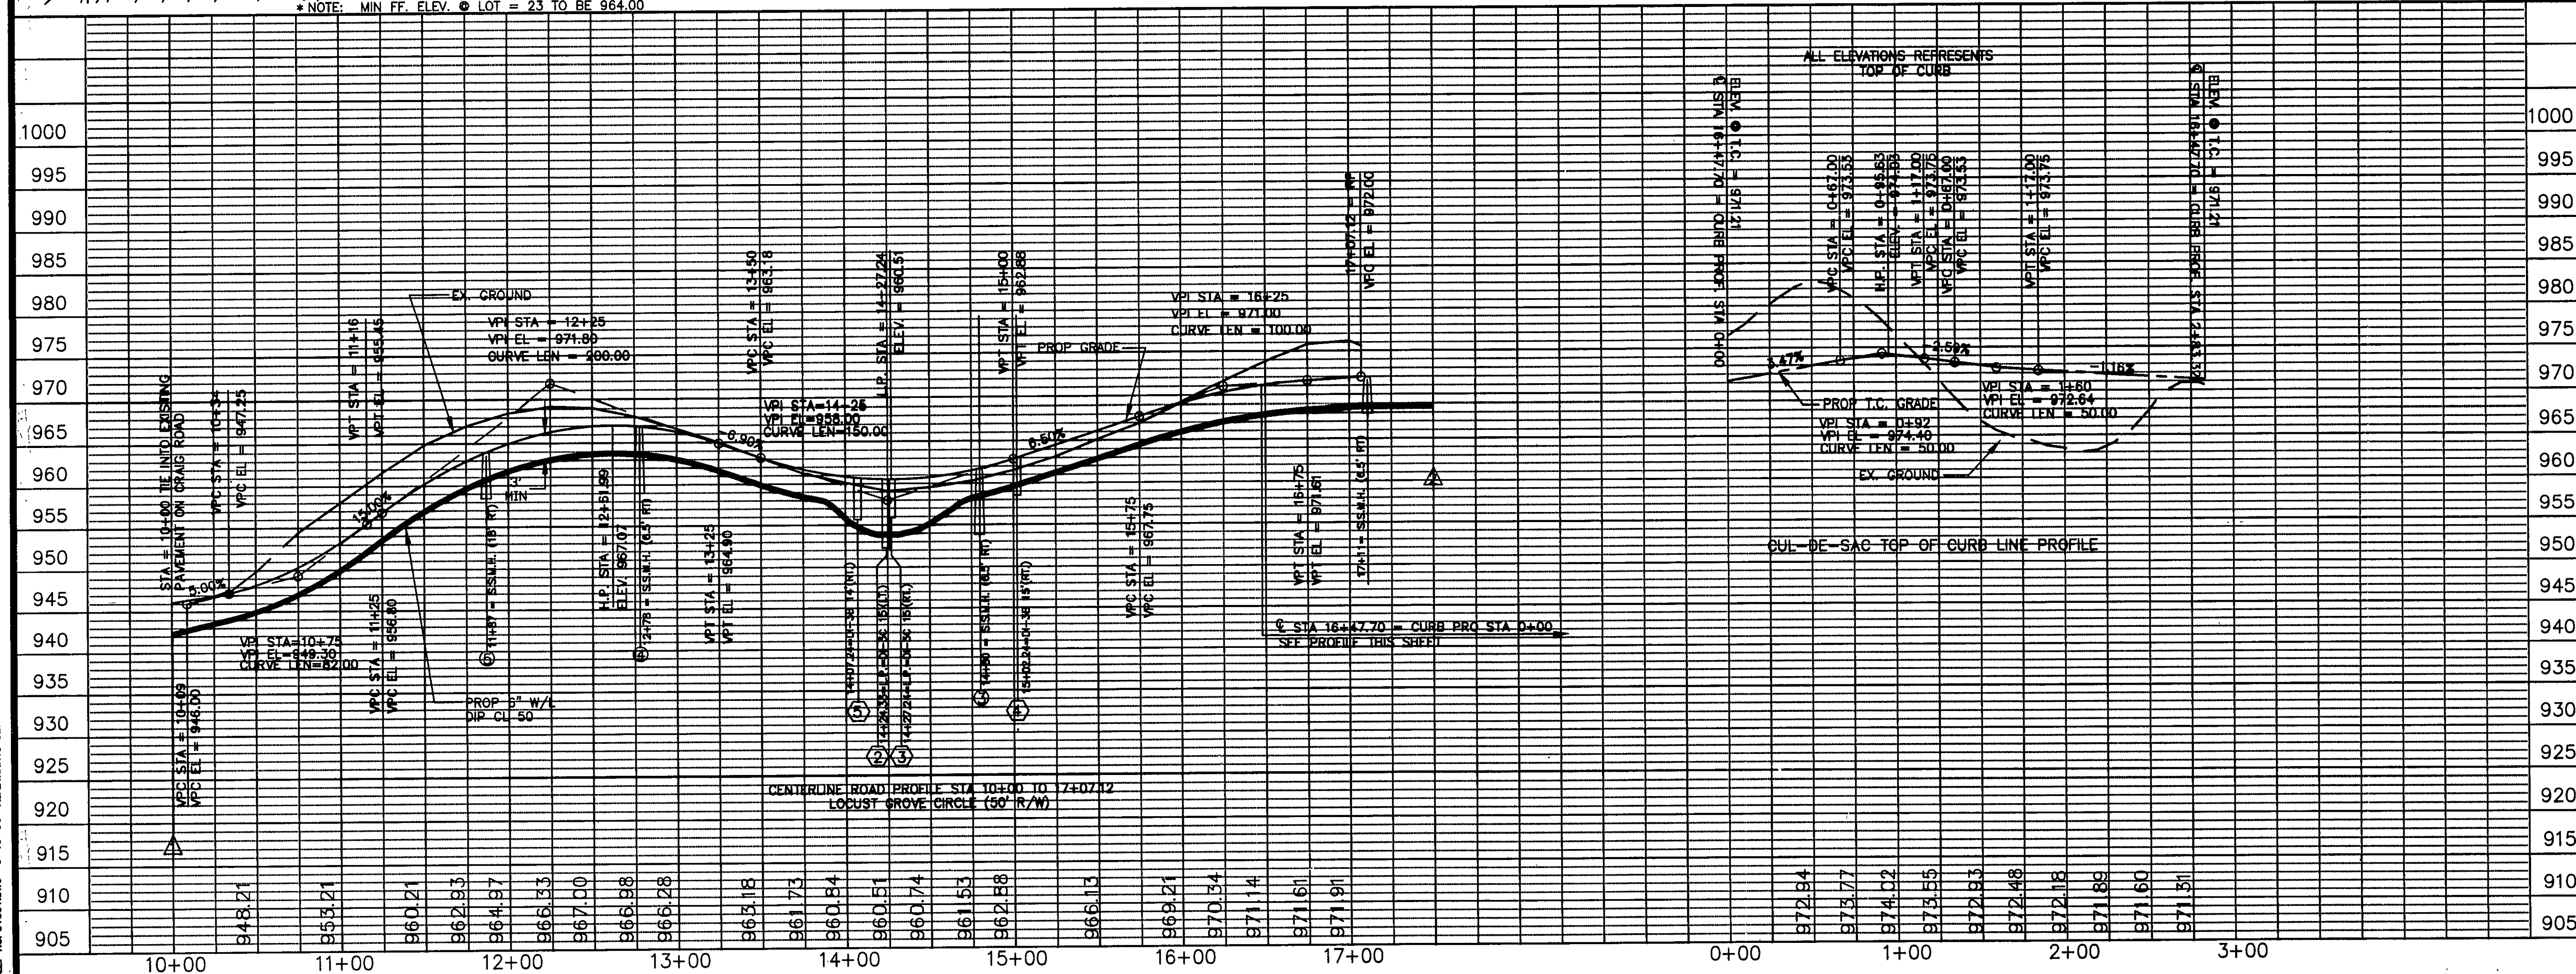


Water As-Built in Utility Line Services
SAN SEWER AS-BUILTS

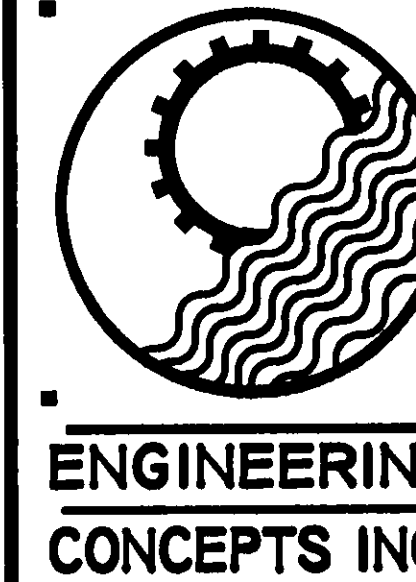

DESIGNED	JDE/CEV
DRAWN	CEV
CHECKED	JDE/LWW
APPROVED	LWW
SCALE	1"=50' HOR: 1"=10' VER
DATE	JUNE 98
PROJECT	96048

REVISIONS		
NO.	DATE	BY

LOCUST GROVE CIRCLE
ROAD PLAN & PROFILE
ROANOKE, VIRGINIA

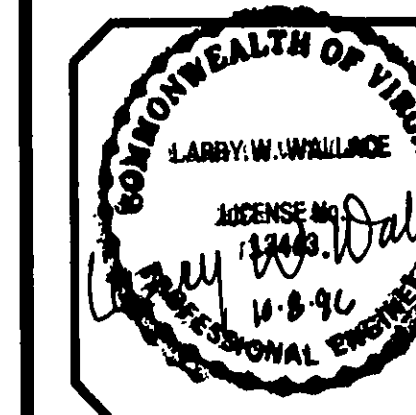

SHEET NO.
2
OF 11