


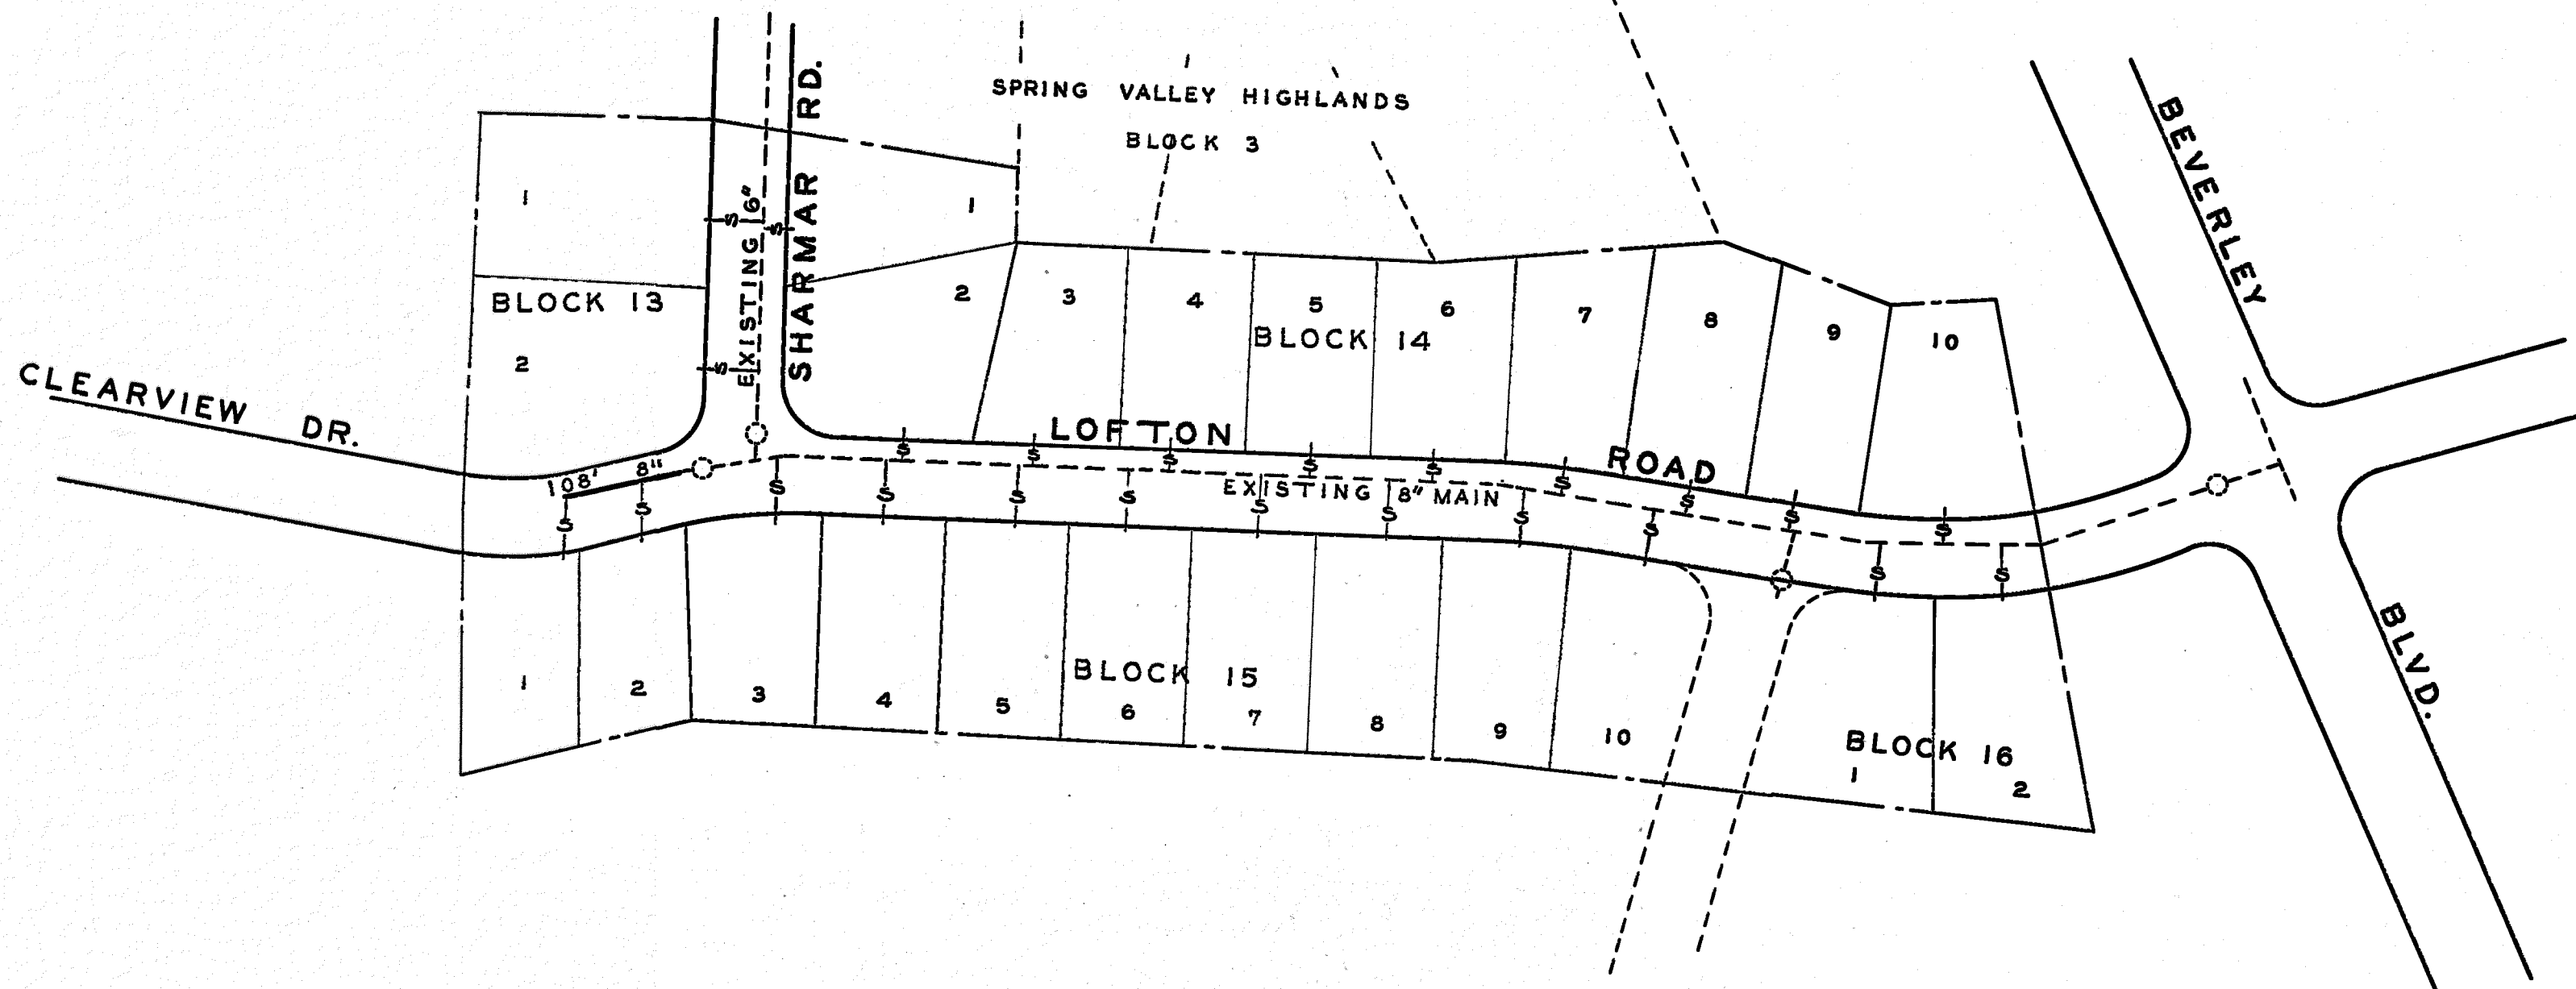

DATE STARTED					JULY 20, 1961	
DATE COMP.					JULY 26, 1961	
FEET MAIN		SIZE	VALVE	VAULT	BOX	
108		8"				
F. H. COMP.						
F. H. STUB ONLY						
SERV. INS. BY:			R.W.D. - M.L.C.			
MAINS INS. BY:			"		"	
NO. ¾" SERV. INS.			24			
CITY OR CO.			COUNTY			
DEPT. INSP.						

R.E. Pillow
 MGR. ROANOKE WATER DEPT.
Wm. K. Linsbach
 AGENT FOR ROANOKE PLANNING COMM.
H. Clute Boyles
 CITY ENGINEER OF ROANOKE, VA.
John J. Mendenhall
 DIRECTOR OF PUBLIC WORKS

6-19-61
~~4-11-61~~
 DATE
 6-19-61
~~4-11-61~~
 DATE
 6-19-61
~~4-11-61~~
 DATE

WATER DEPARTMENT
 CITY OF ROANOKE, VA.
 SPRING VALLEY SECT. 7
 SCALE - 1" = 100'
 DRAWN BY N.H.C. APRIL 10, 1961