




AS-BUILTS 5/31/24

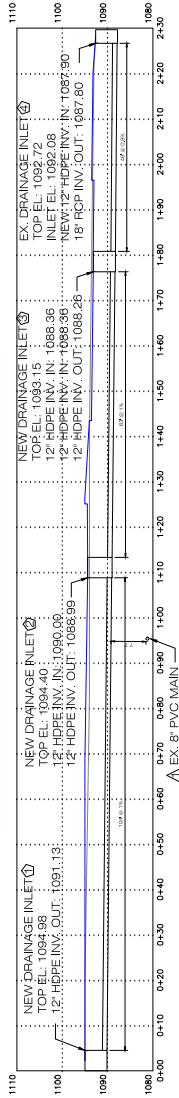

STORM SEWER PROFILE A

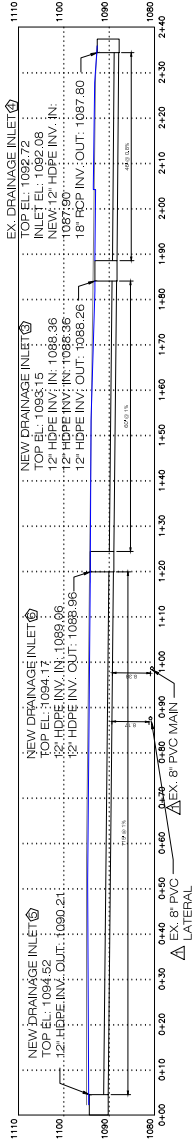

STORM SEWER PROFILE B

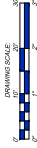

3757 ROBERT C. BYRD DR.  
BECKLEY, WV 25801  
304-939-2832  
centec-engineering.com

**CEN TEC**  
ENGINEERING, PLLC

CIVIL and ENVIRONMENTAL ENGINEERS

| NO.                                                                         | DESCRIPTION       | DATE     |
|-----------------------------------------------------------------------------|-------------------|----------|
| 1                                                                           | REVISION COMMENTS | NO. DATE |
| DESIGNED BY: JAMES H. BYRD<br>CHECKED BY: JAMES H. BYRD<br>DATE: 05-22-2023 |                   |          |

PROJECT NUMBER: 4773 WILLIAMSON, ROANSKOE, VA  
CHARTER FOODS, INC.  
TALBOTT, TN

FIGURE NO. 10

**DRAWING NO. C-1.9**

City of Roanoke  
Planning Building & Development  
COMPREHENSIVE DEVELOPMENT PLAN  
**APPROVED**  
By Aaron Ogilvie 10/30/2023