


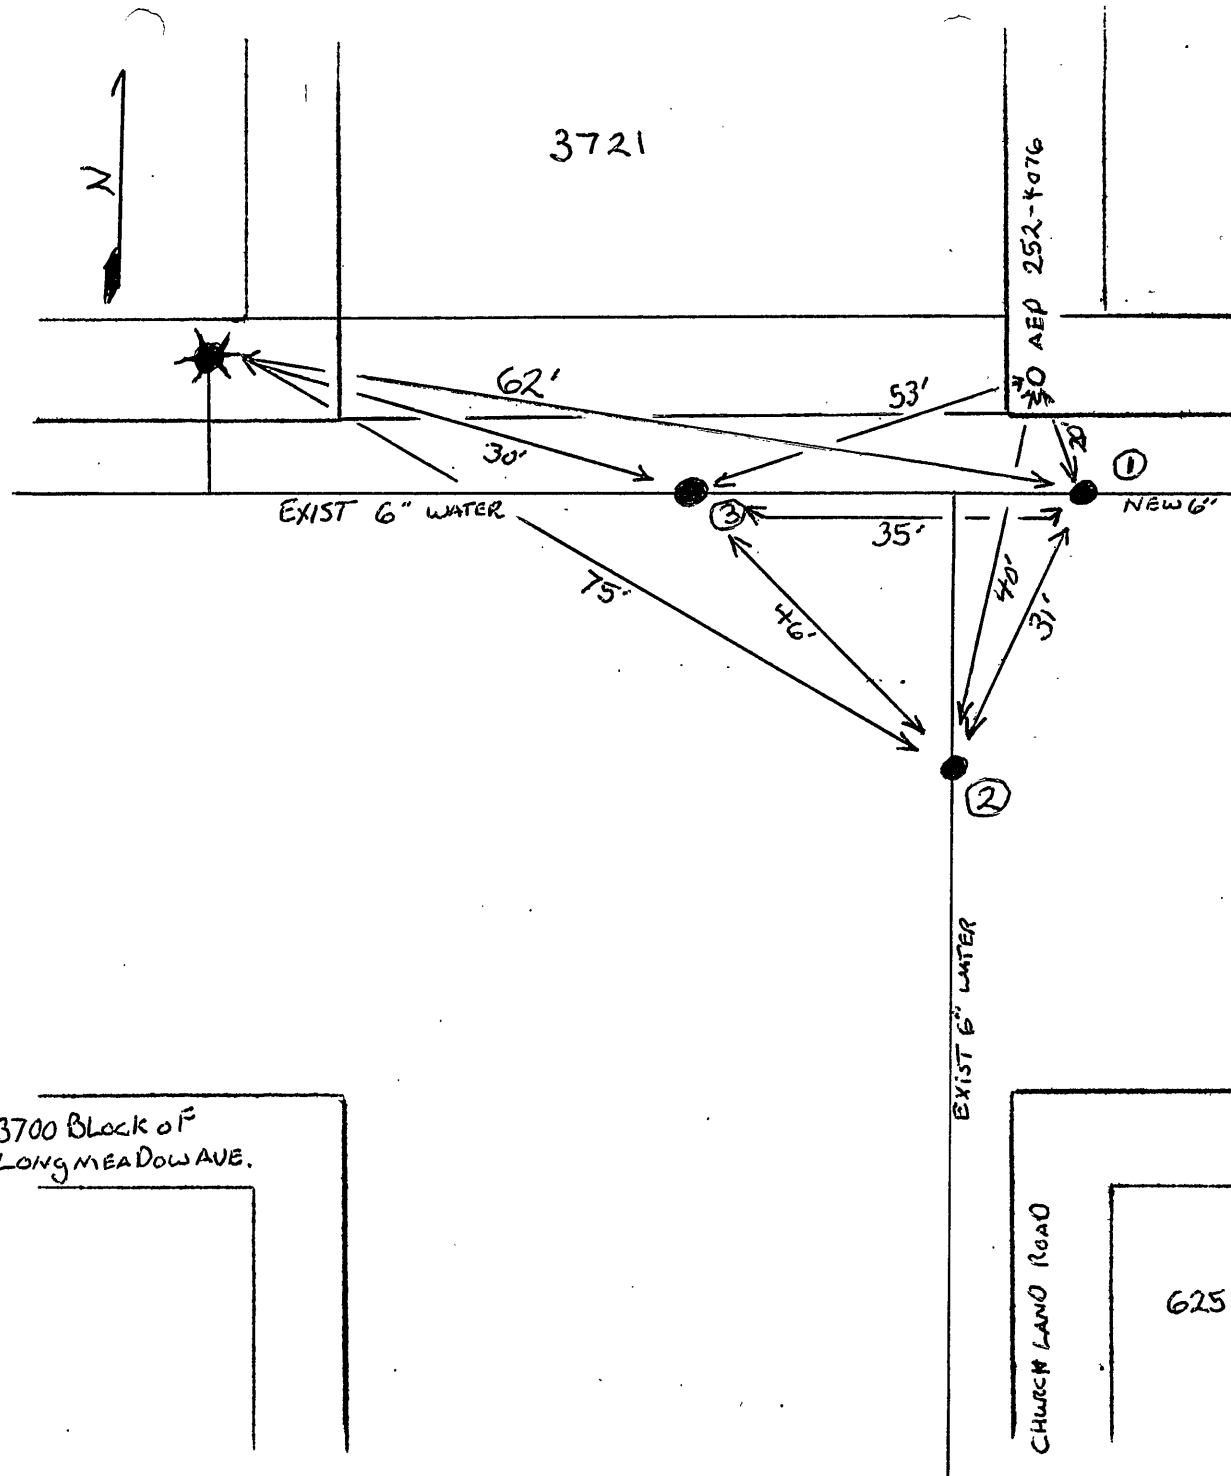

DATE	NO.	SIZE	MAKE	OPEN	TURNS
4/5/99	1	6"	MULL	R	21
1962	2	6"	MULL	R	21
1963	3	6"	MULL	R	21

P. L. Measurements		
No.	Distance	Direction

CITY OF ROANOKE - WATER DEPT.	
VALVE DIAGRAM	
LONG MEADOW AVE. AND CHURCH LANE ROAD	
Churchland Rd	
LONG MEADOW AVE.	
Sec. Map 274	NW
Date 4-5-99	Page No.