


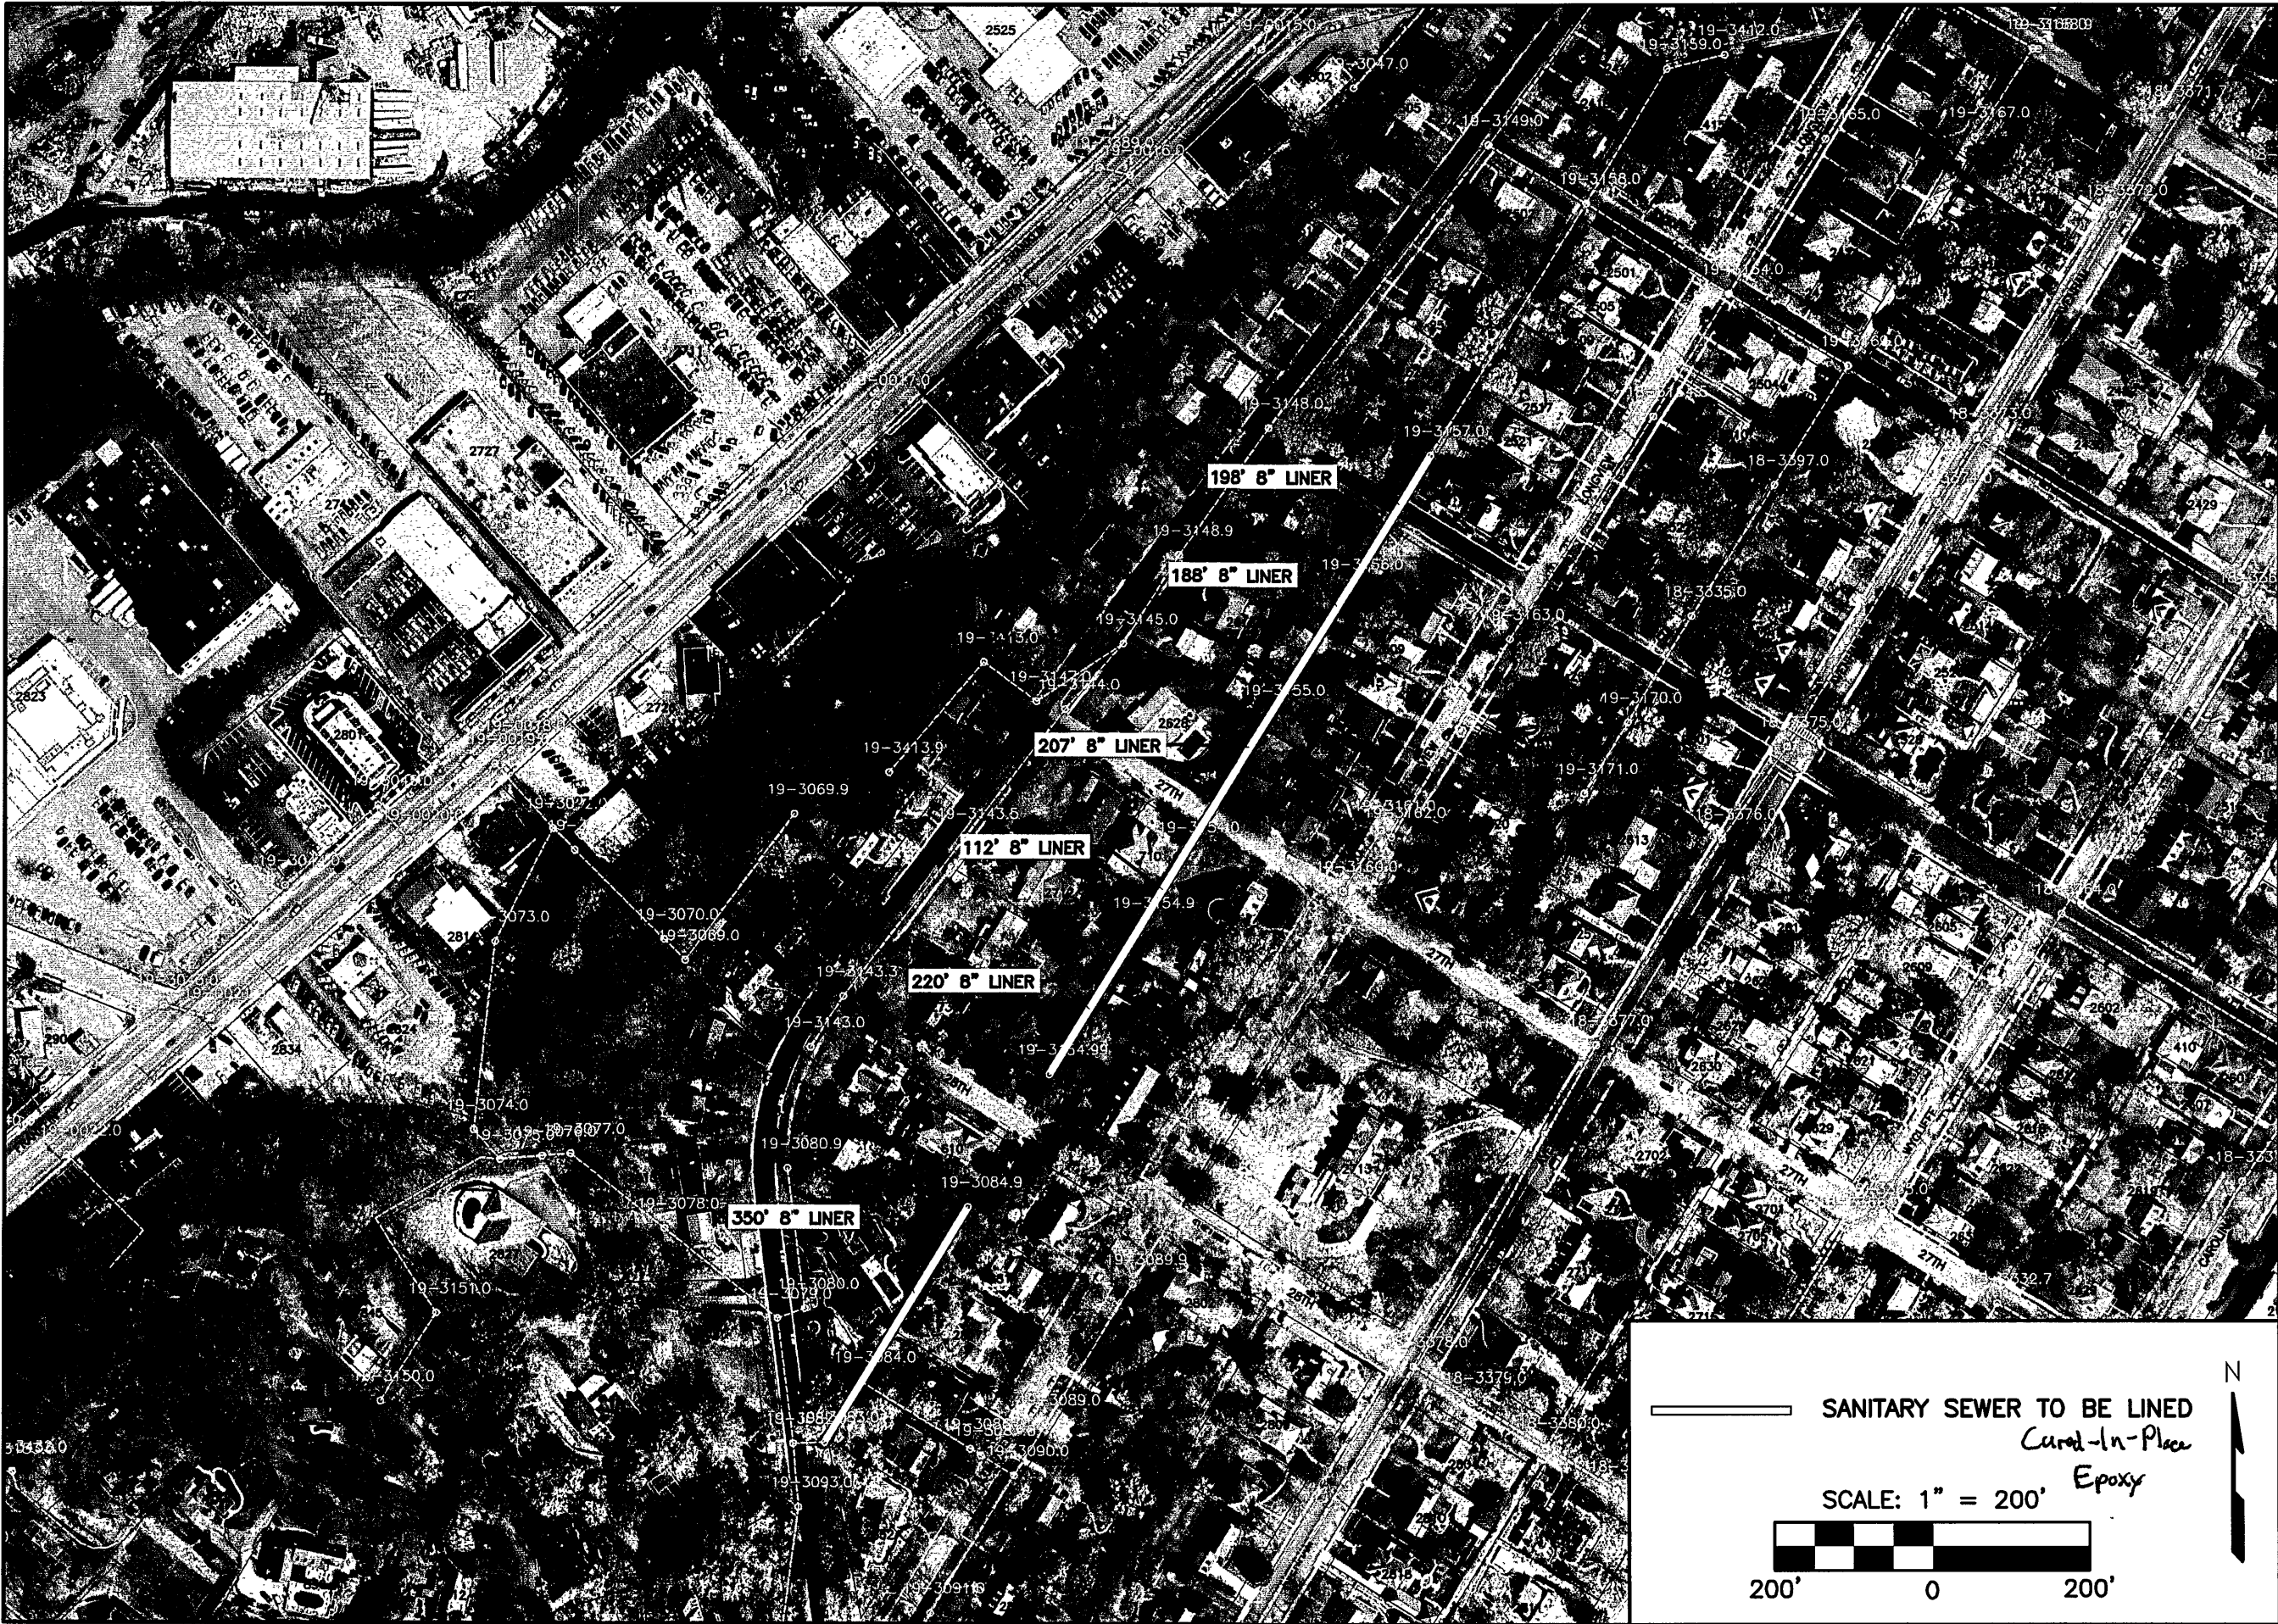

SANITARY SEWER TO BE LINED
*Cured-In-Place
Epoxy*

SCALE: 1" = 200'

200'0200'

N

 Wiley Wilson Constant Progress		127 Nationwide Drive Lynchburg, Virginia 24502-4272	
PROJECT WWWA LINER PROJECTS 2009		TITLE LONGVIEW AVENUE	
COMM. NO. 209050.00		DATE 12-09	
DRAWN LDB	CHECKED WM	DWG. REFERENCE NO. LONGVIEW.DWG	
SHEET TITLE		REV.	
As-Built		ΣΣΣ 10/01/10	