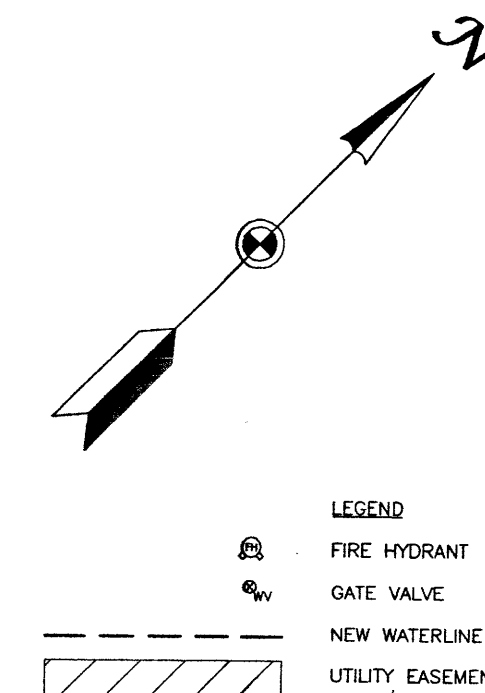
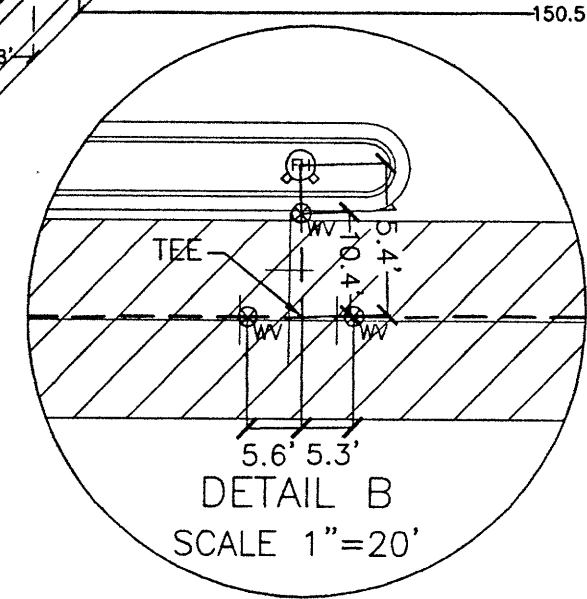
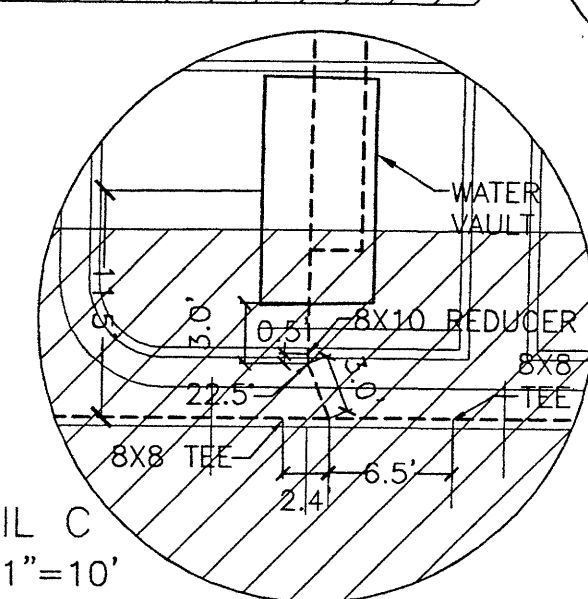
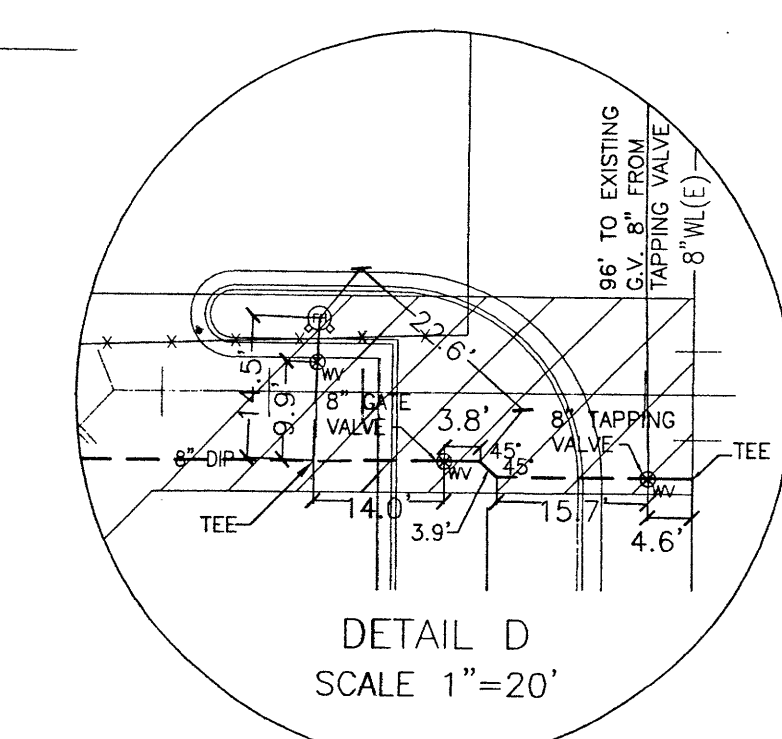
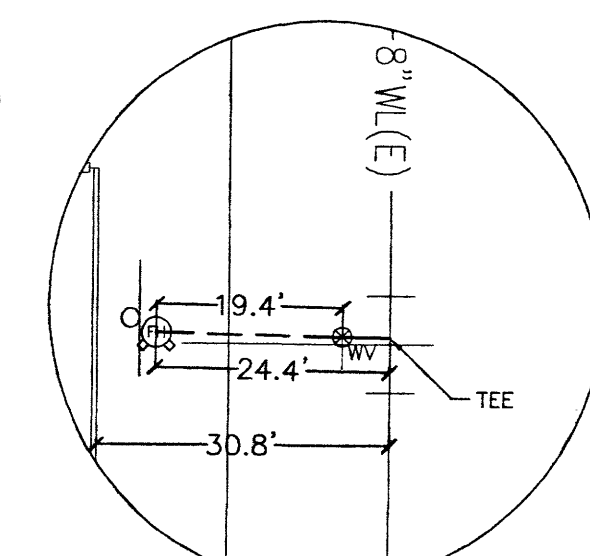
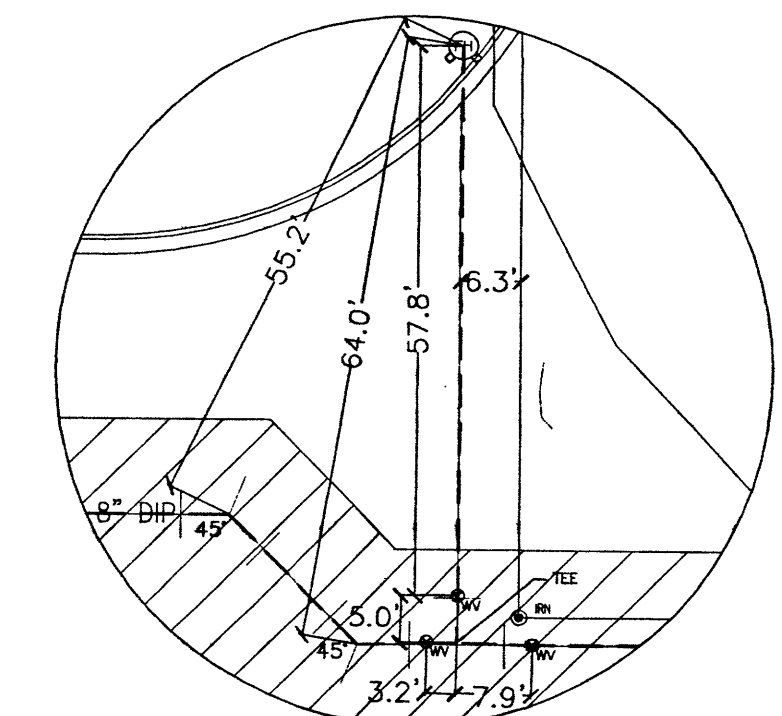
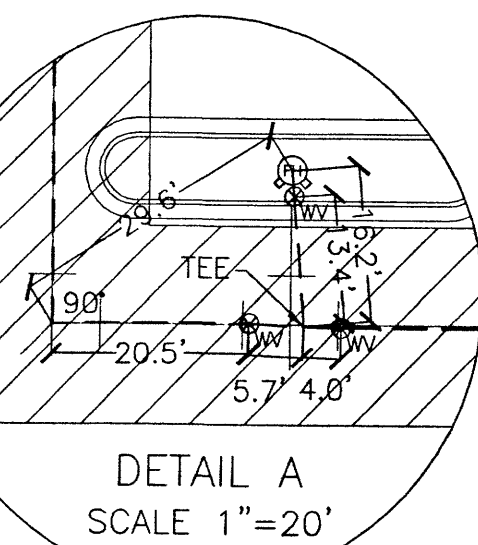


DESIGNED BY:	PROJECT:				REVISION NUMBER:
DRAWN BY:	LOWE'S OF EAST ROANOKE ROANOKE, VIRGINIA				DRAWING NUMBER:
REVIEWED BY:					TITLE:
TWG	WATERLINE AS-BUILT				
WWA NUMBER: 203070.00	FILE NAME:	DISCIPLINE: CIVIL	SCALE: H: 1"=30' V: N/A	DATE: 1/22/04	SHEET NUMBER: 1 OF 1