


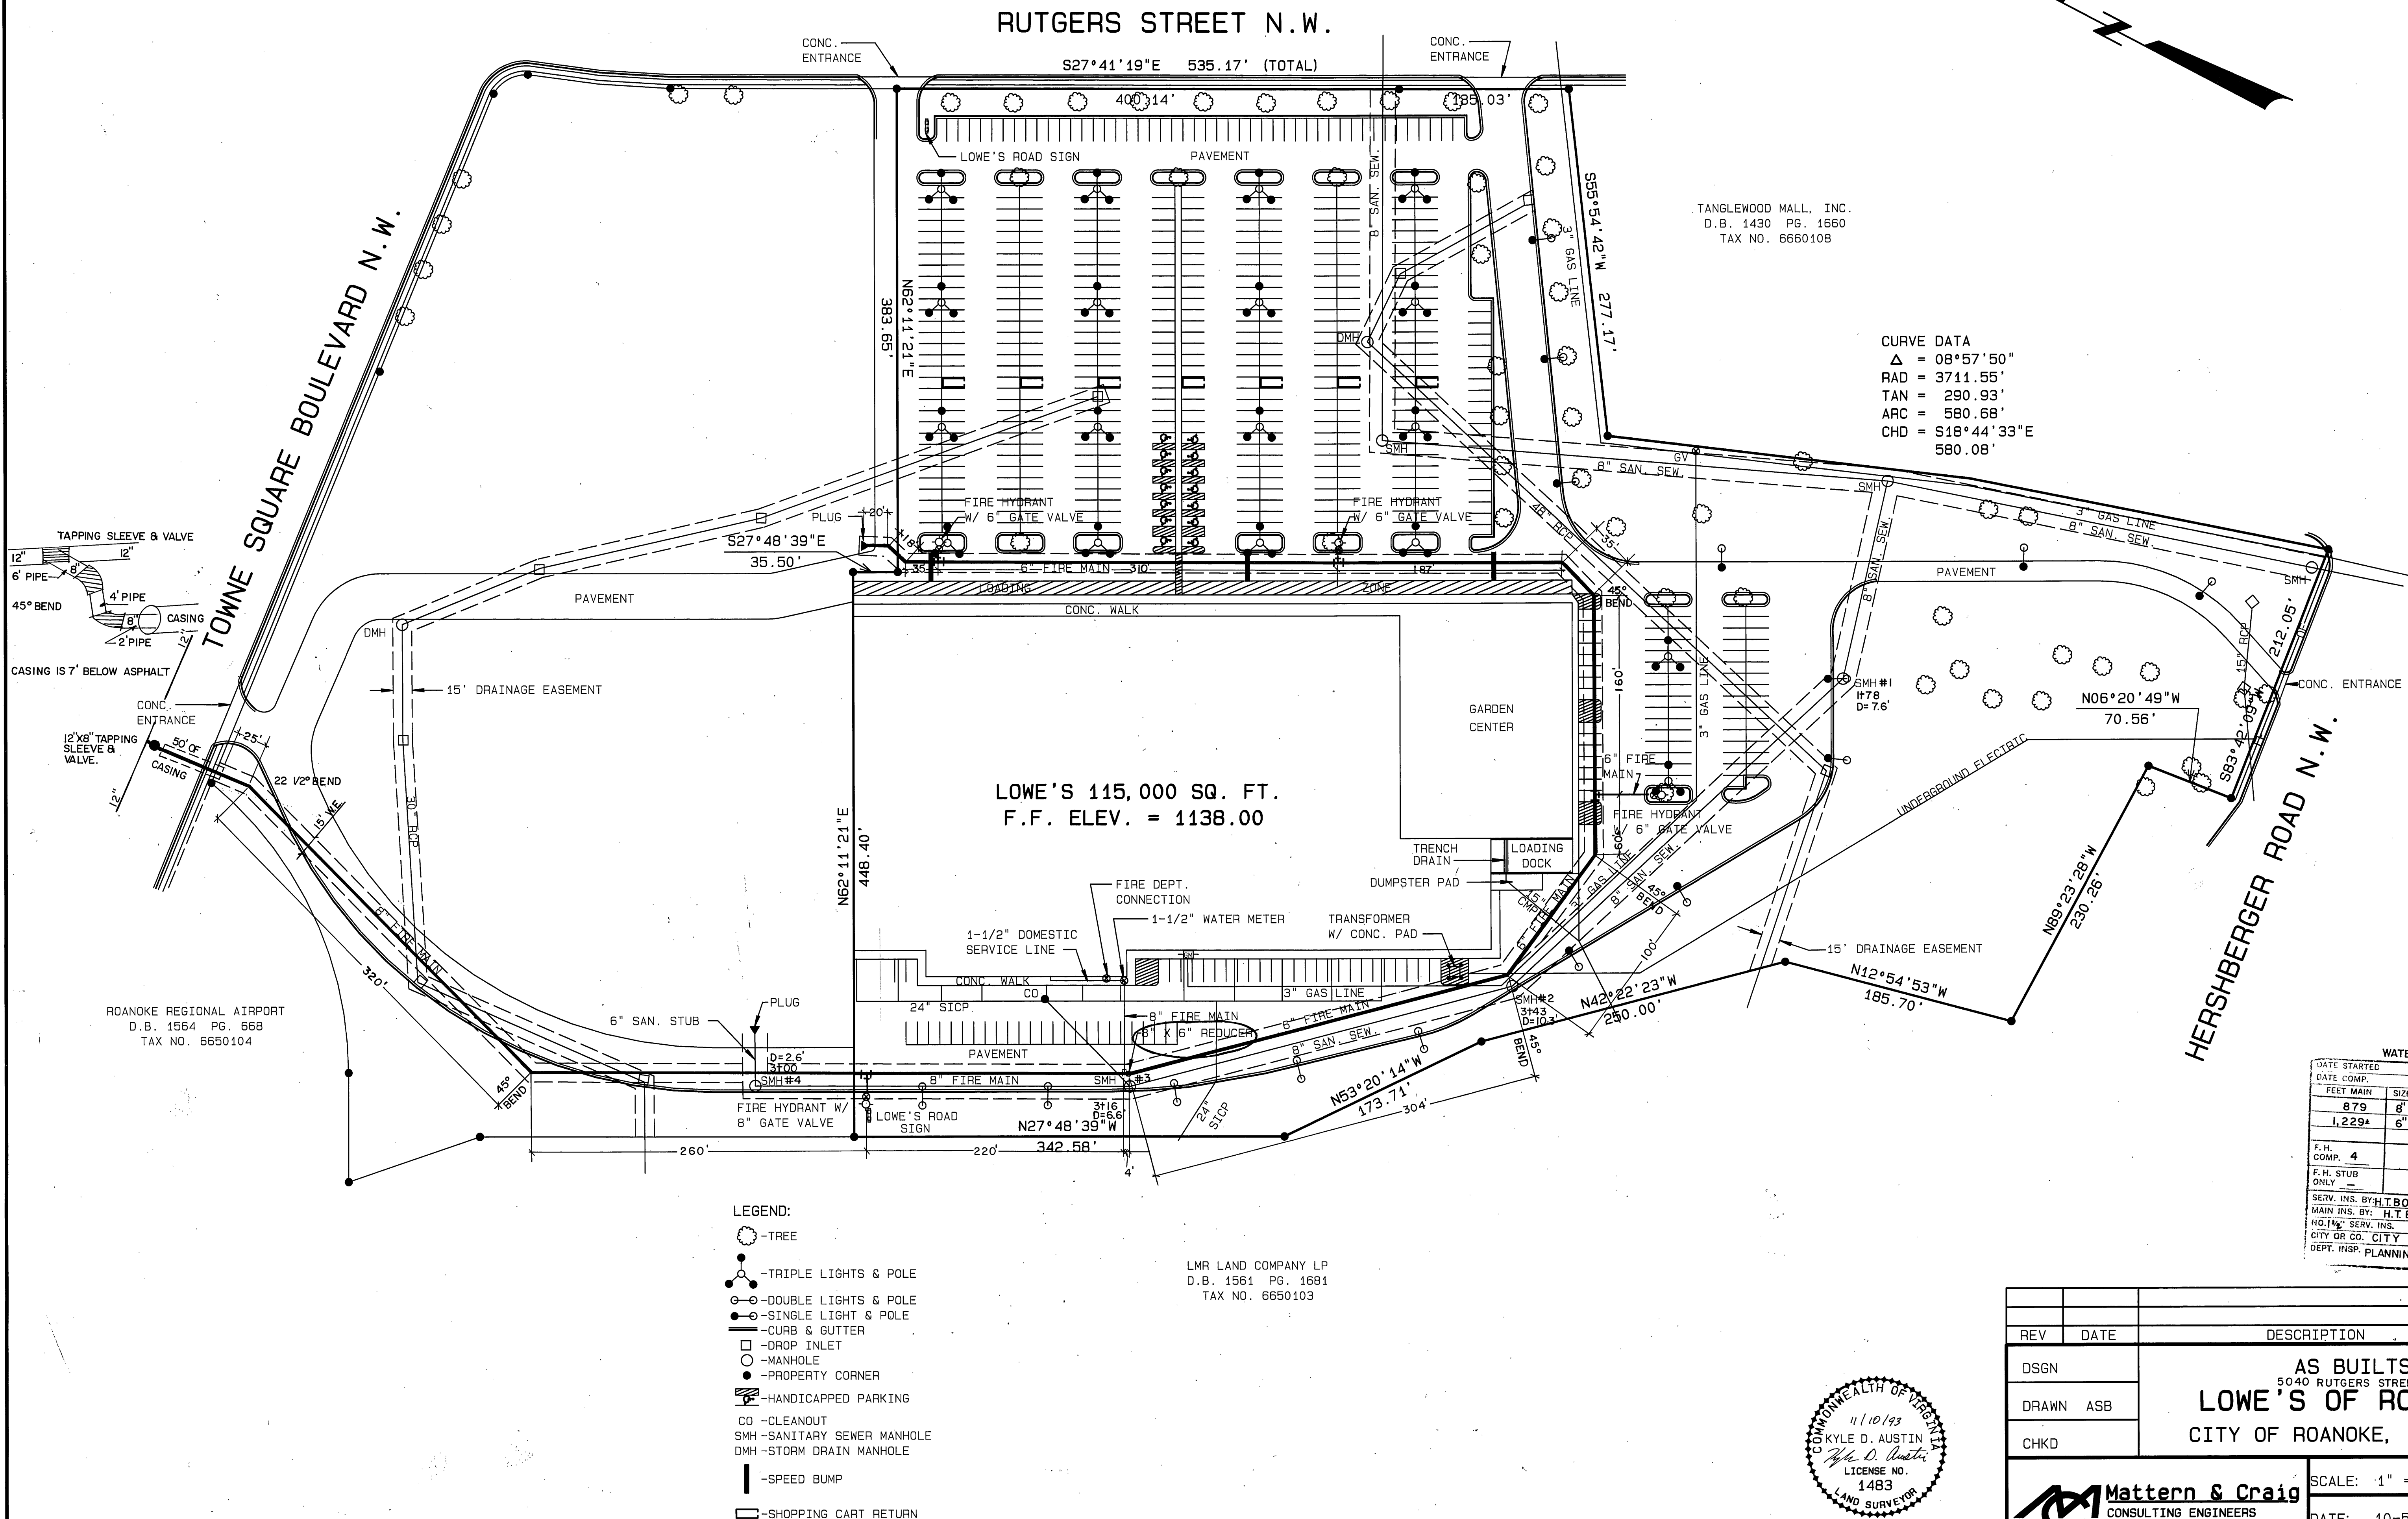

WATER				
DATE STARTED	7-7-93			
DATE COMP.	8-23-93			
FEET MAIN	SIZE	VALVE	VAULT	BOX
879	8"	1	1	
1,229*	6"	-	-	-
F.H. COMP.	4			
F.H. STUB ONLY	-			
SERV. INS. BY	H.T. BOWLING			
MAIN INS. BY	H.T. BOWLING			
NO. 1/2" SERV. INS.	1			
CITY OR CO.	CITY			
DEPT. INSP.	PLANNING - DAN CONNER			

REV	DATE	DESCRIPTION	BY	APP
DSGN		AS BUILTS		
DRAWN	ASB	5040 RUTGERS STREET, N.W.		
CHKD		LOWE'S OF ROANOKE		
		CITY OF ROANOKE, VIRGINIA		
		SCALE: 1" = 60'	COMM. NO. 1236	
		DATE: 10-5-93	SHEET 1	
		DRAWING # SITE	WATER DEPT. # 93-01	