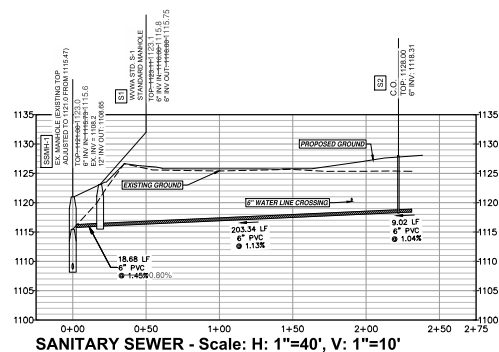
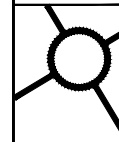


2122 Carolina Ave, SW
Roanoke, VA 24014
Ph: 540-387-1153
Fax: 540-389-5767

1915-B W. Cary Street
Richmond, VA 23220
Phone: 804-358-2947
Fax: 804-359-9645

These documents are the property of Parker Design Group (PDG) and may not be reproduced or used without the express permission of PDG. Any reuse of these documents without authorization of PDG will be at the sole risk of the individual or entity utilizing said documents.

[illegible]

DESIGNED BY:	JMD
DRAWN BY:	JDE / JMD
CHECKED BY:	JDE
SCALE:	1" = 40'
DATE:	AUGUST 24, 2022
PROJECT NUMBER:	21-0337

**AS-BUILT WATER &
SANITARY SEWER
PROFILES**

AB2

02 OF 02