

SANITARY SEWER INVERT SCHEDULE:

LOT NUMBER	MINIMUM FF	STA	TOP OF SEW. MAIN
1	NONE	NONE	NONE
2	1029.55	11+52.40	1026.55
3	1030.40	12+07.06	1027.40
4	1031.60	12+84.00	1028.60
5	1032.61	13+43.64	1029.61
6	1033.63	14+02.65	1030.63
7	1033.93	14+42.92	1030.93
8	1034.68	14+99.50	1031.68



GAY AND NEEL, INC.
CIVIL ENGINEERING
LAND PLANNING
SURVEYING

328 Mountain Avenue S.W.
Roanoke, Virginia 24016
Phone: (540) 345-1110 Fax: (540) 345-5560
Email: info@gayandneel.com




**HILL
STUDIO**

Community Planning
Landscape Architecture
Architecture
Historic Preservation




120 W. Campbell Ave. SW
Roanoke, VA 24011

tel: 540-342-5263
fax: 540-345-5625


www.hillstudio.com

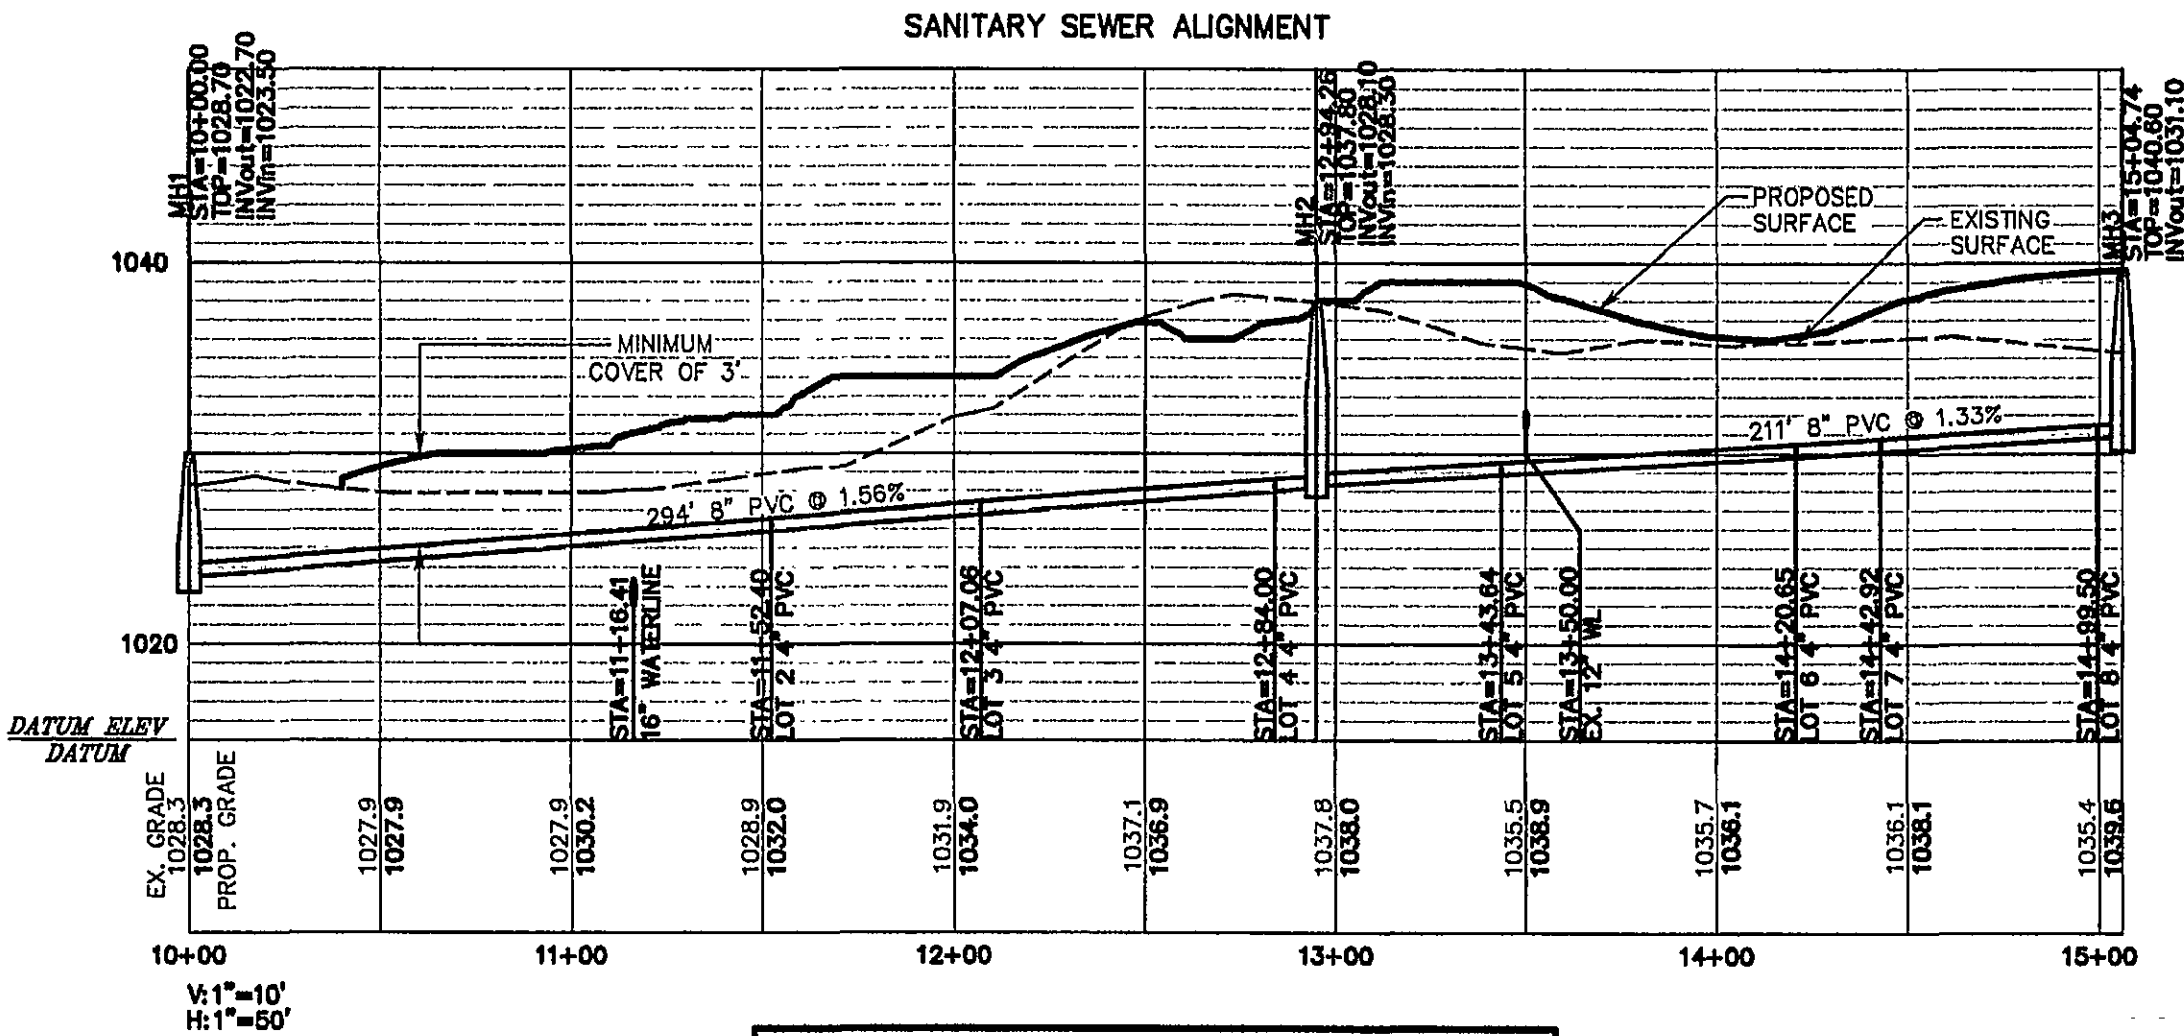

MATERIALS AND INSTALLATION SHALL BE IN CONFORMANCE WITH THE WESTERN VIRGINIA WATER AUTHORITY STANDARDS

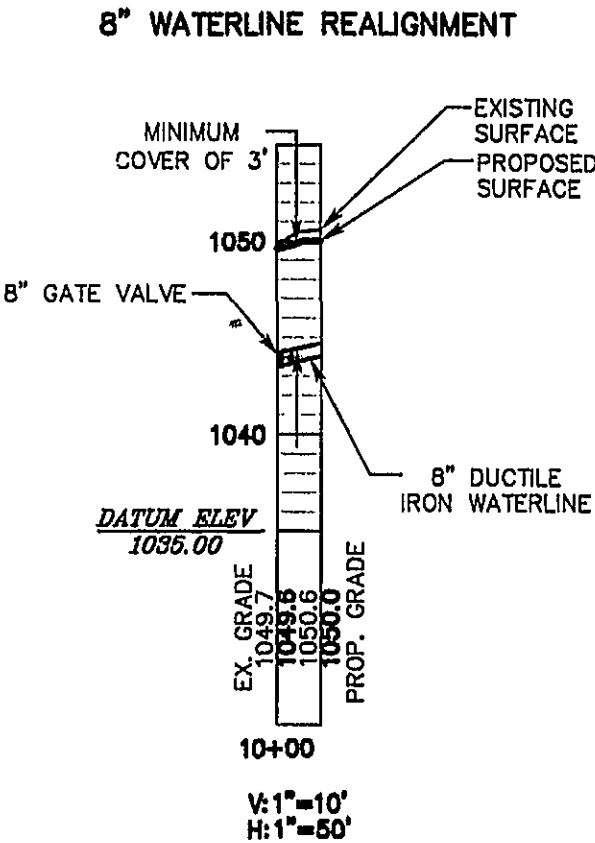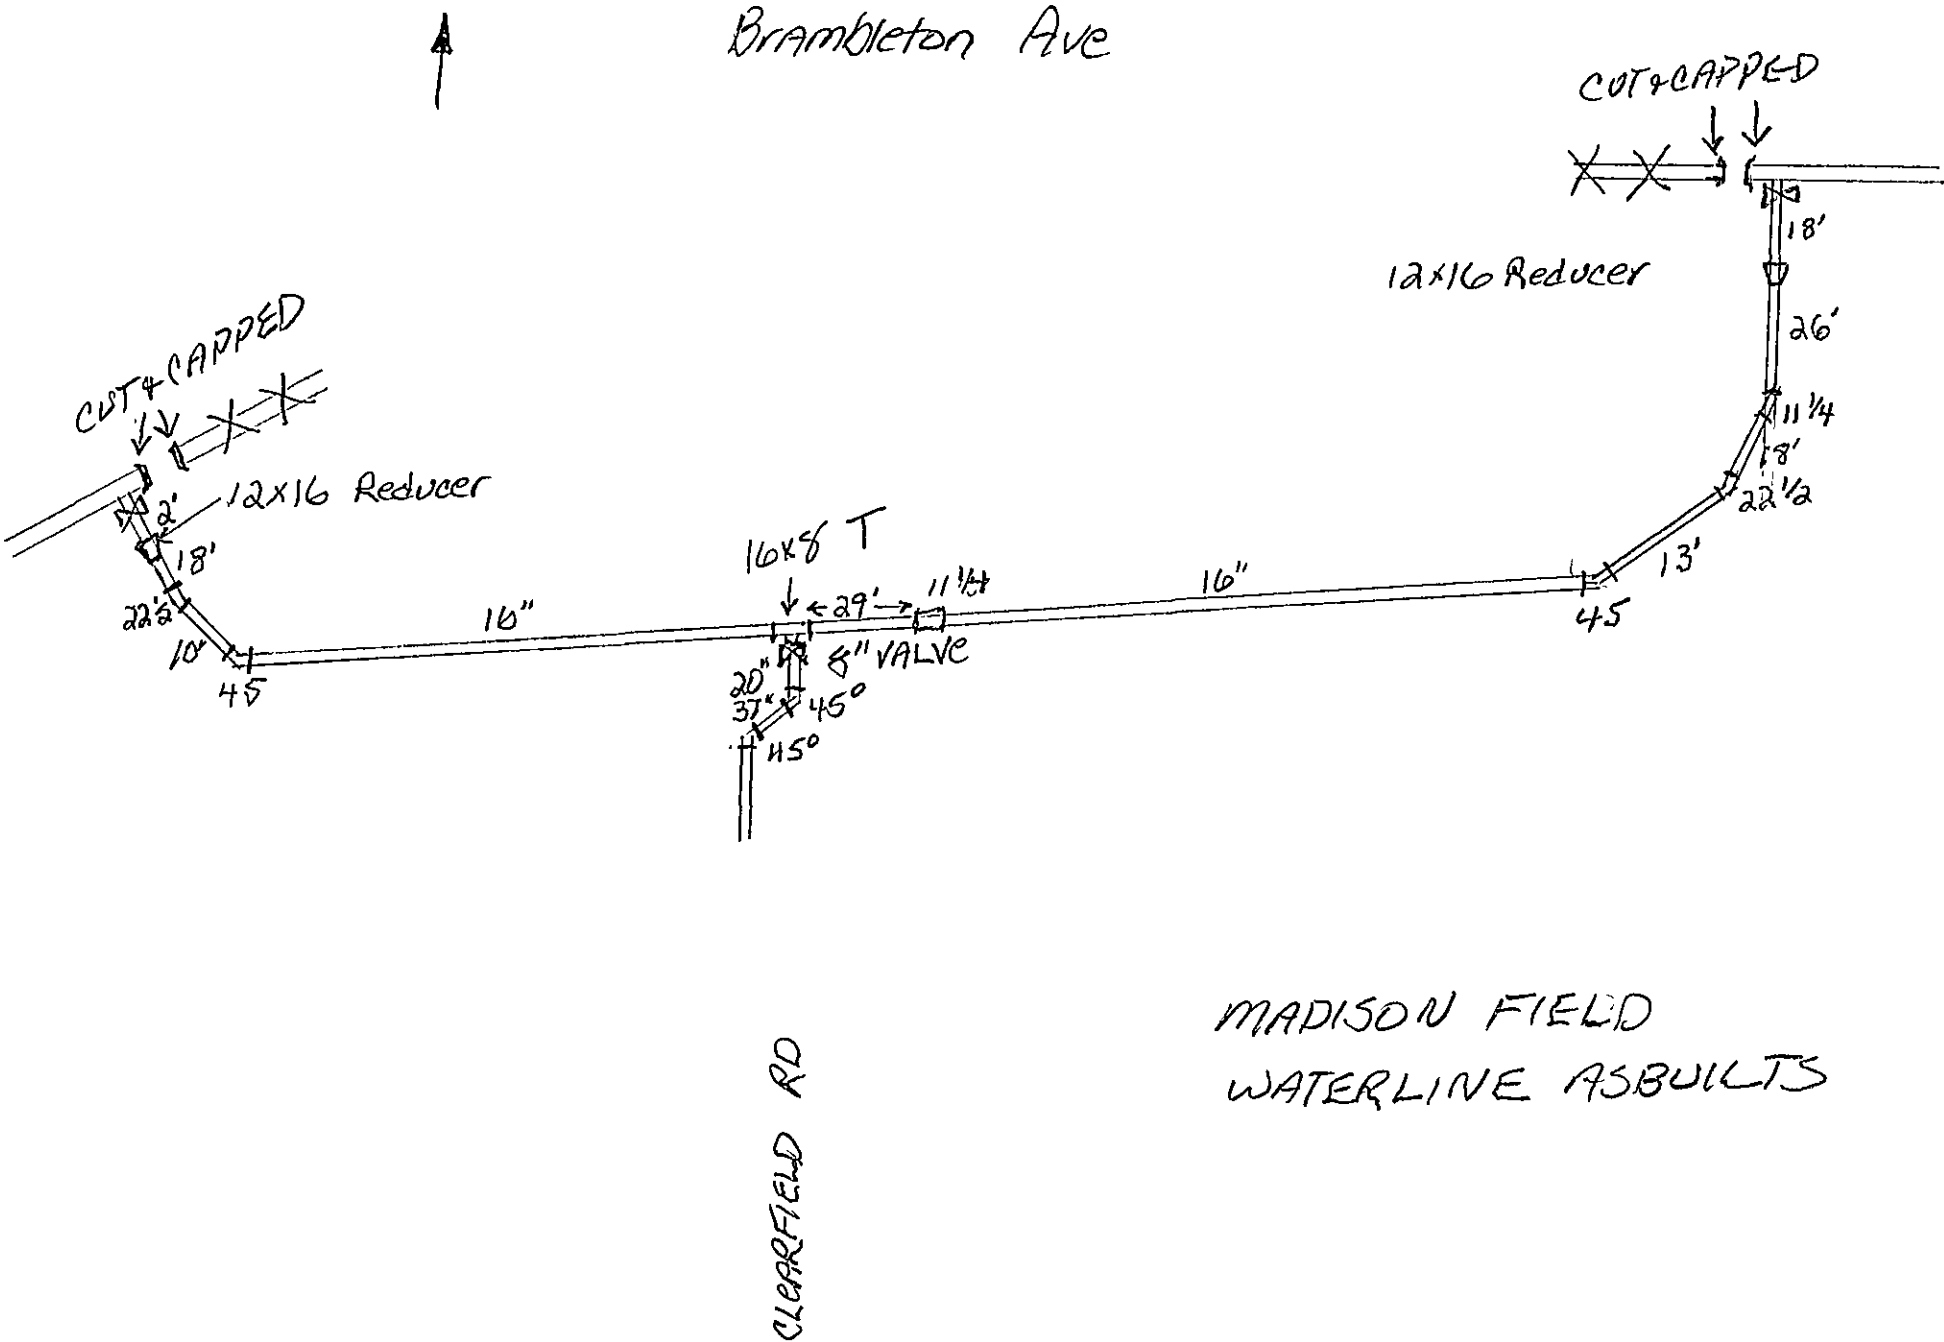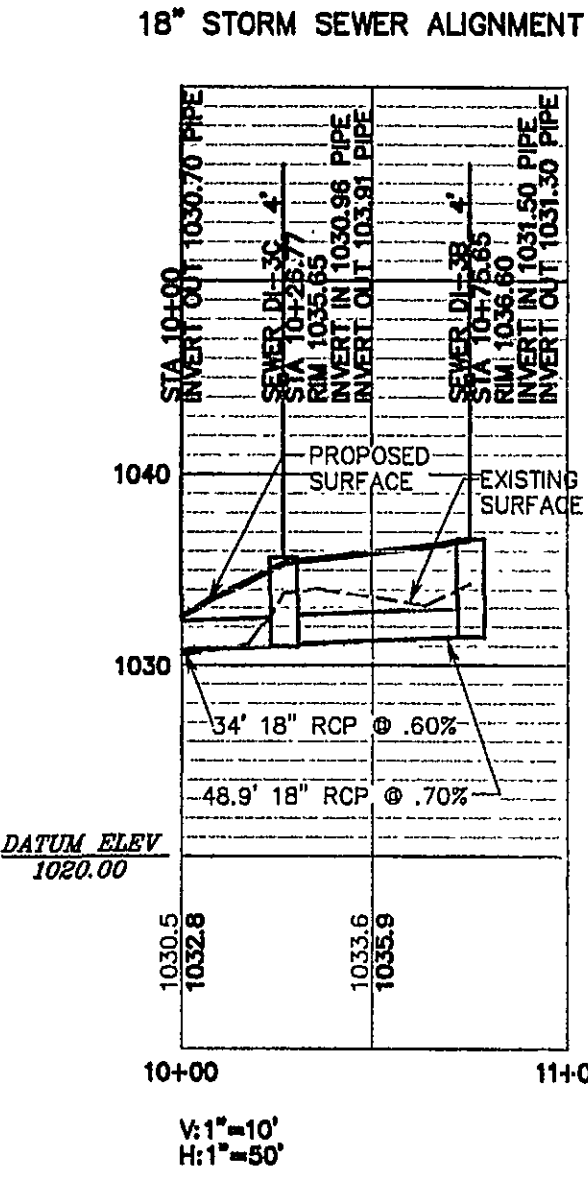


MATERIALS AND INSTALLATION SHALL BE IN CONFORMANCE WITH THE WESTERN VIRGINIA WATER AUTHORITY STANDARDS

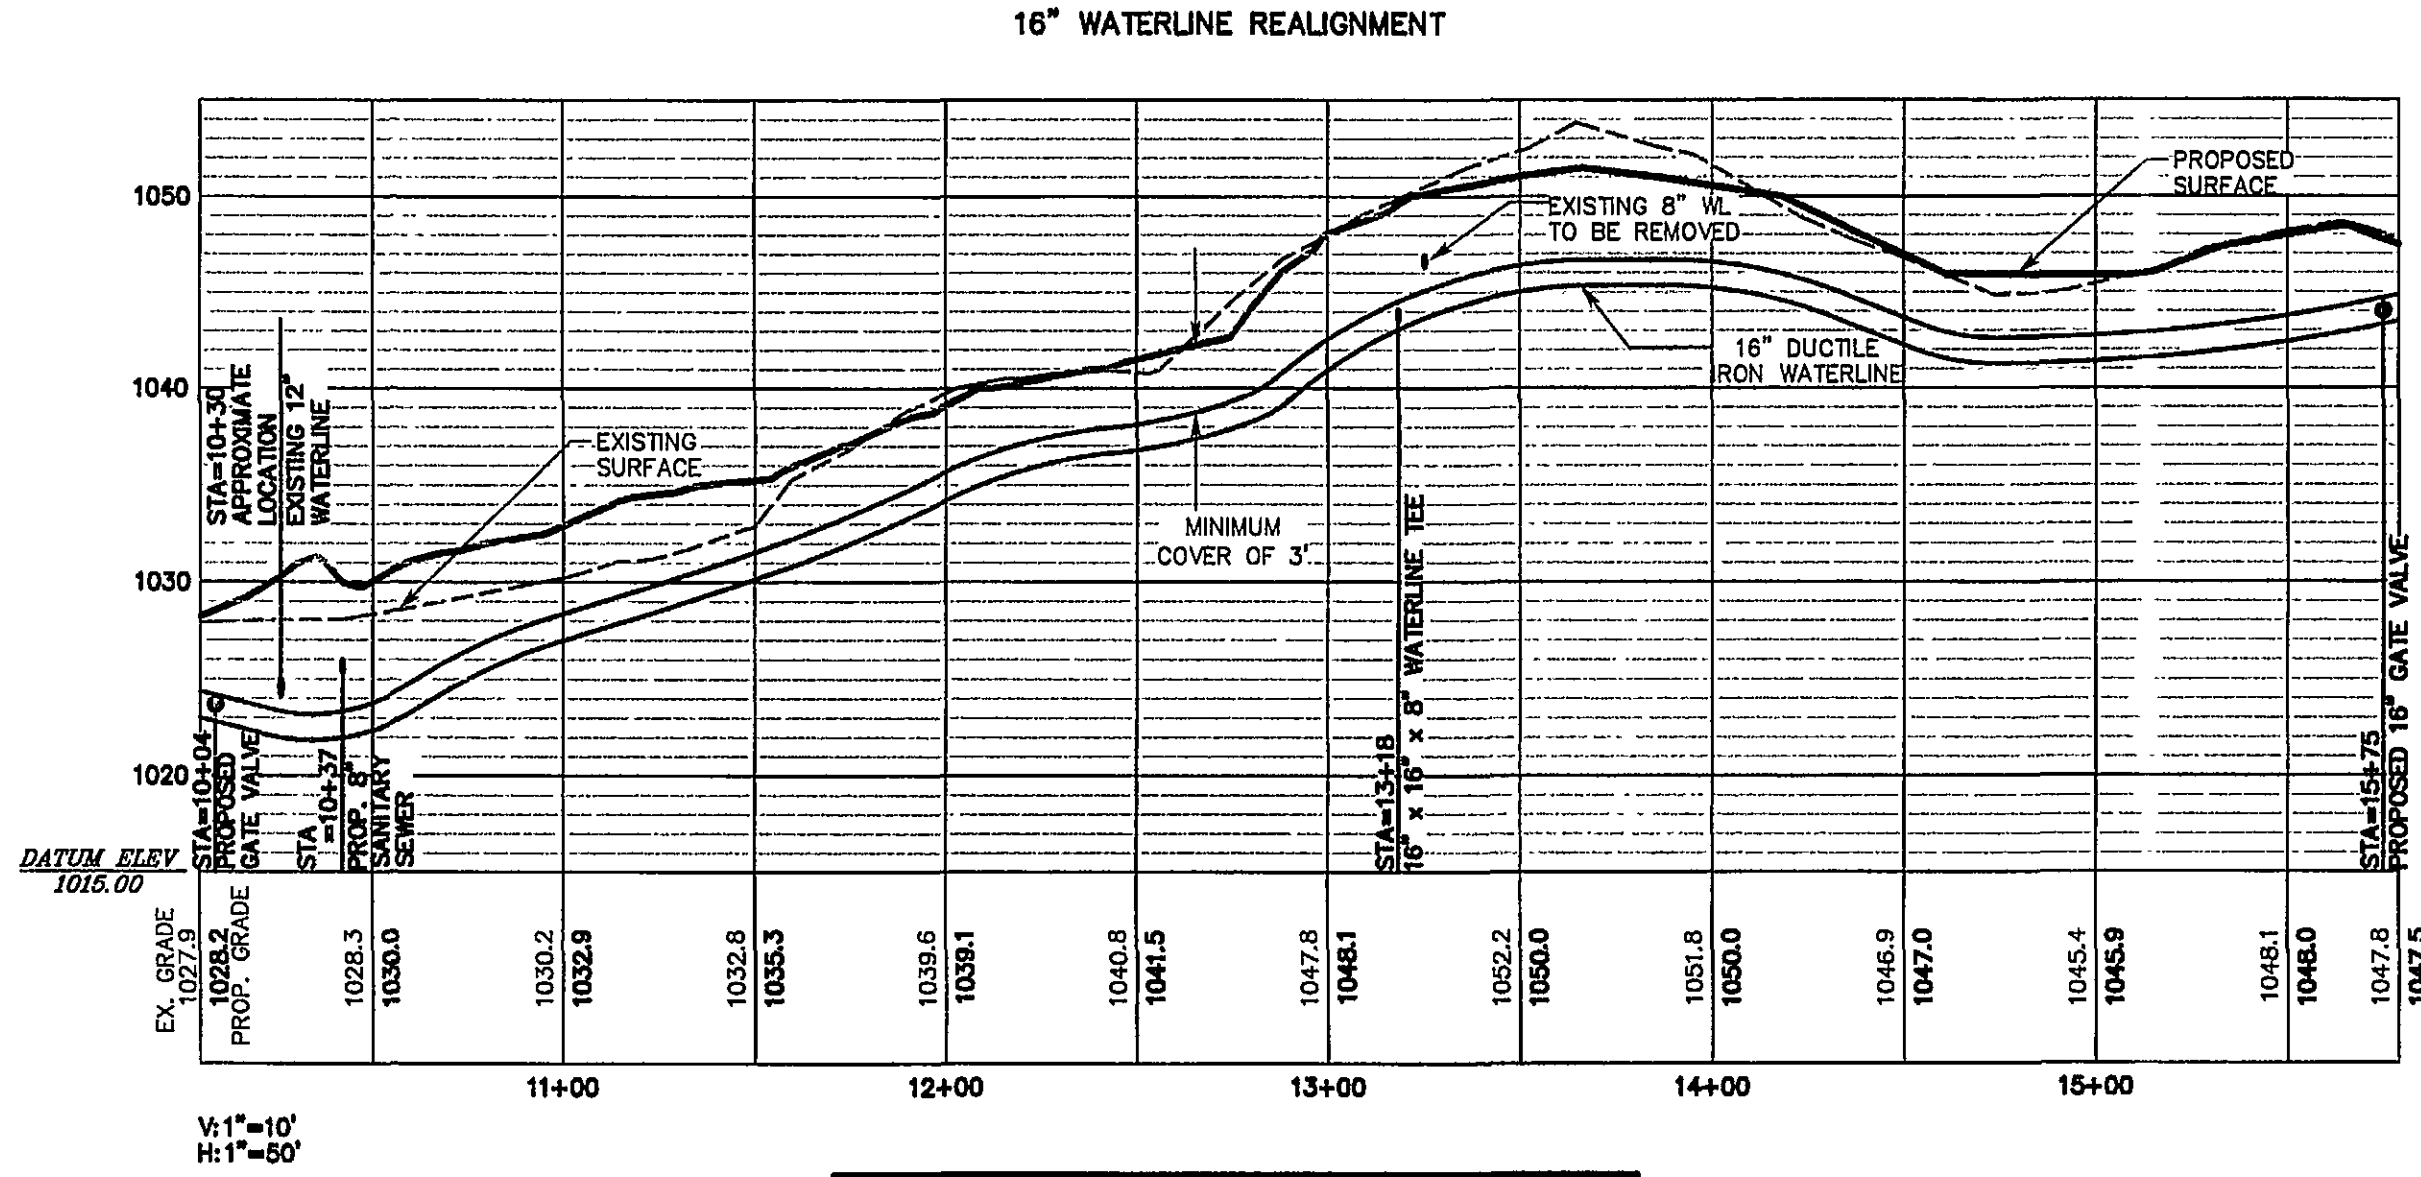

MATERIALS AND INSTALLATION SHALL BE IN CONFORMANCE WITH THE WESTERN VIRGINIA WATER AUTHORITY STANDARDS

Madison Field Subdivision
Utility Profiles
Located on Brambleton Avenue in the City of Roanoke, Virginia
1647.1

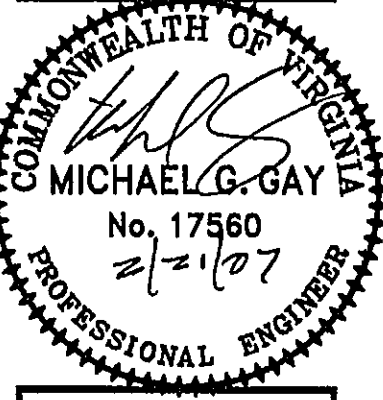

MICHAEL G. GAY
No. 17580
2/15/07
PROFESSIONAL ENGINEER

Date: 12/21/06
Scale: AS SHOWN
Revisions: 2/15/07

Drawn By: PLJ
Review By: [Signature]
Project No. 1647.1