


*DEVELOPMENT PLAN*  
*FOR*

*SITUATED IN  
CAVE SPRING MAGISTERIAL DISTRICT  
ROANOKE COUNTY, VIRGINIA*

DATE: 14 NOVEMBER 2002  
 "AS-BUILT" - 9 MAY 2003  
 PREPARED FOR

STEPHEN A. STILWELL AND JEFFREY S. TODD

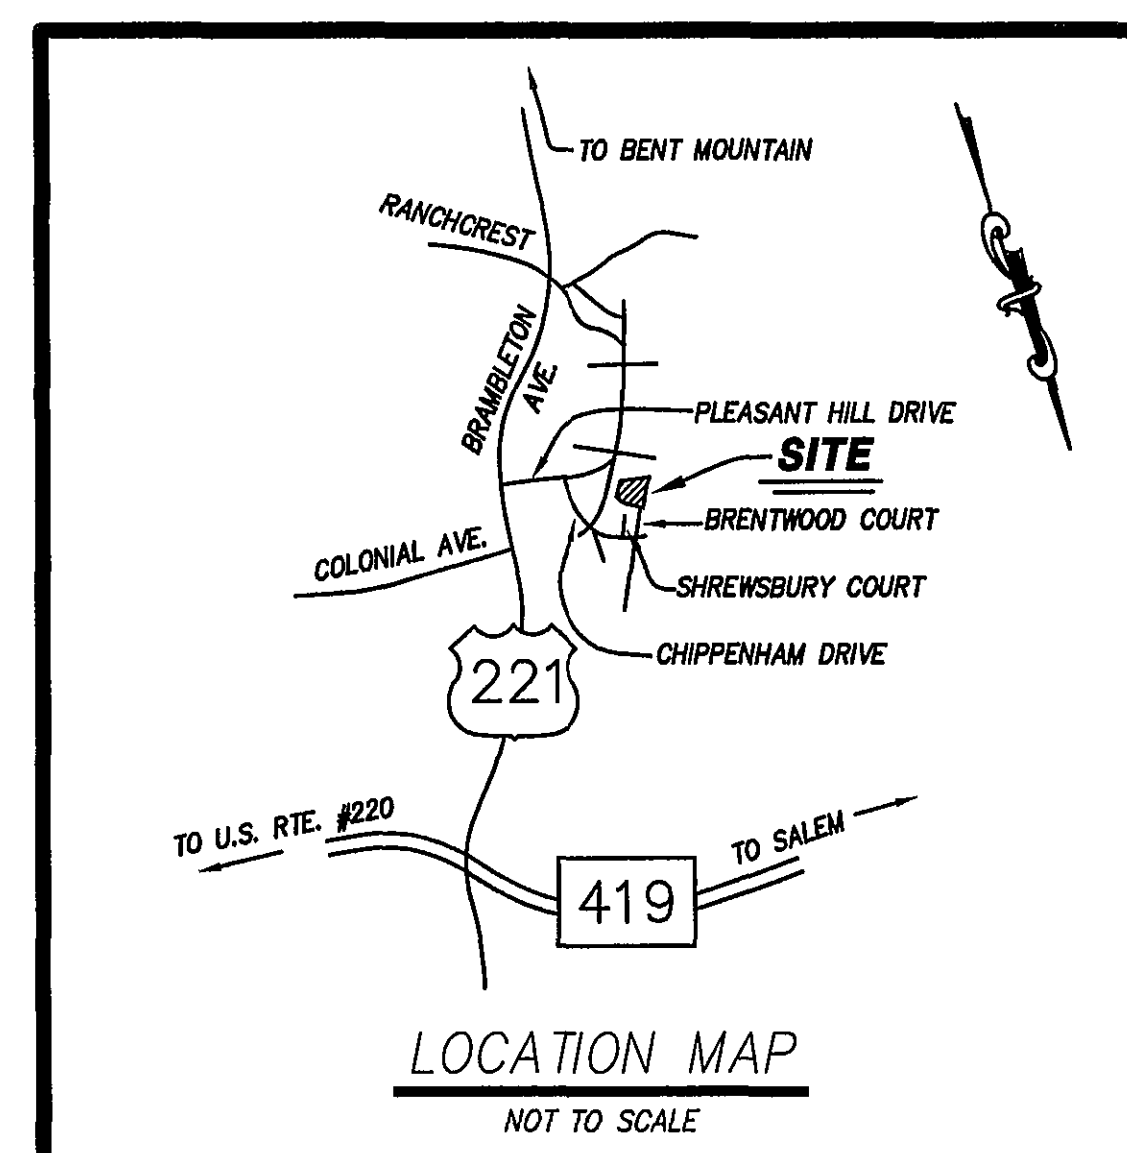

**--INDEX OF DRAWINGS--**

<b>SHEET No.</b>	<b>DESCRIPTION</b>
------------------	--------------------

1. . . . . LUMSDEN ASSOCIATES COVER SHEET
2. . . . . ROANOKE COUNTY STANDARD COVER SHEET
3. . . . . RECORD PLAT
4. . . . . NOTES AND DETAILS
5. . . . . DIMENSIONAL LAYOUT
6. . . . . GRADING PLAN
7. . . . . PROFILES
8. . . . . EROSION AND SEDIMENT CONTROL PLAN
9. . . . . EROSION AND SEDIMENT CONTROL DETAILS

I AM CERTIFIED BY THE STATE OF VIRGINIA AS A "RESPONSIBLE LAND DISTURBER". I SHALL BE RESPONSIBLE FOR THE IMPLEMENTATION OF THE EROSION AND SEDIMENT CONTROL PLAN AS SHOWN.

SIGNATURE: . . . \_\_\_\_\_  
 PRINTED NAME: . . . \_\_\_\_\_  
 CERTIFICATE No.: . . . \_\_\_\_\_  
 EXPIRATION DATE: \_\_\_\_\_  
 TELEPHONE No.: . . . \_\_\_\_\_  
 ADDRESS: . . . . . \_\_\_\_\_



LUMSDEN ASSOCIATES, P.C.  
ENGINEERS-SURVEYORS-PLANNERS

4664 BRAMBLETON AVENUE, SW  
P.O. BOX 20669  
ROANOKE, VIRGINIA 24018

PHONE: (540) 774-4411  
FAX: (540) 772-9445  
E-MAIL: MAIL@LUMSDENPC.COM

## “AS-BUILT”

NOTE:

1. "AS BUILT" INFORMATION TAKEN FROM  
PLAN FURNISHED BY J. P. TURNER &  
BROTHERS, INC., GENERAL CONTRACTOR.
2. "AS-BUILT" DIMENSIONS SHOWN IN BRACKETS.

REVISONS	
DATE	SHEETS
12/18/02	1 - 8
2/28/03	1, 3 - 6
5/09/13	"AS-BUILT" SCHEDULE SCHEDULE NUMBER
COMMISSION NO: 2002-015	
SHEET 1 OF 9	