
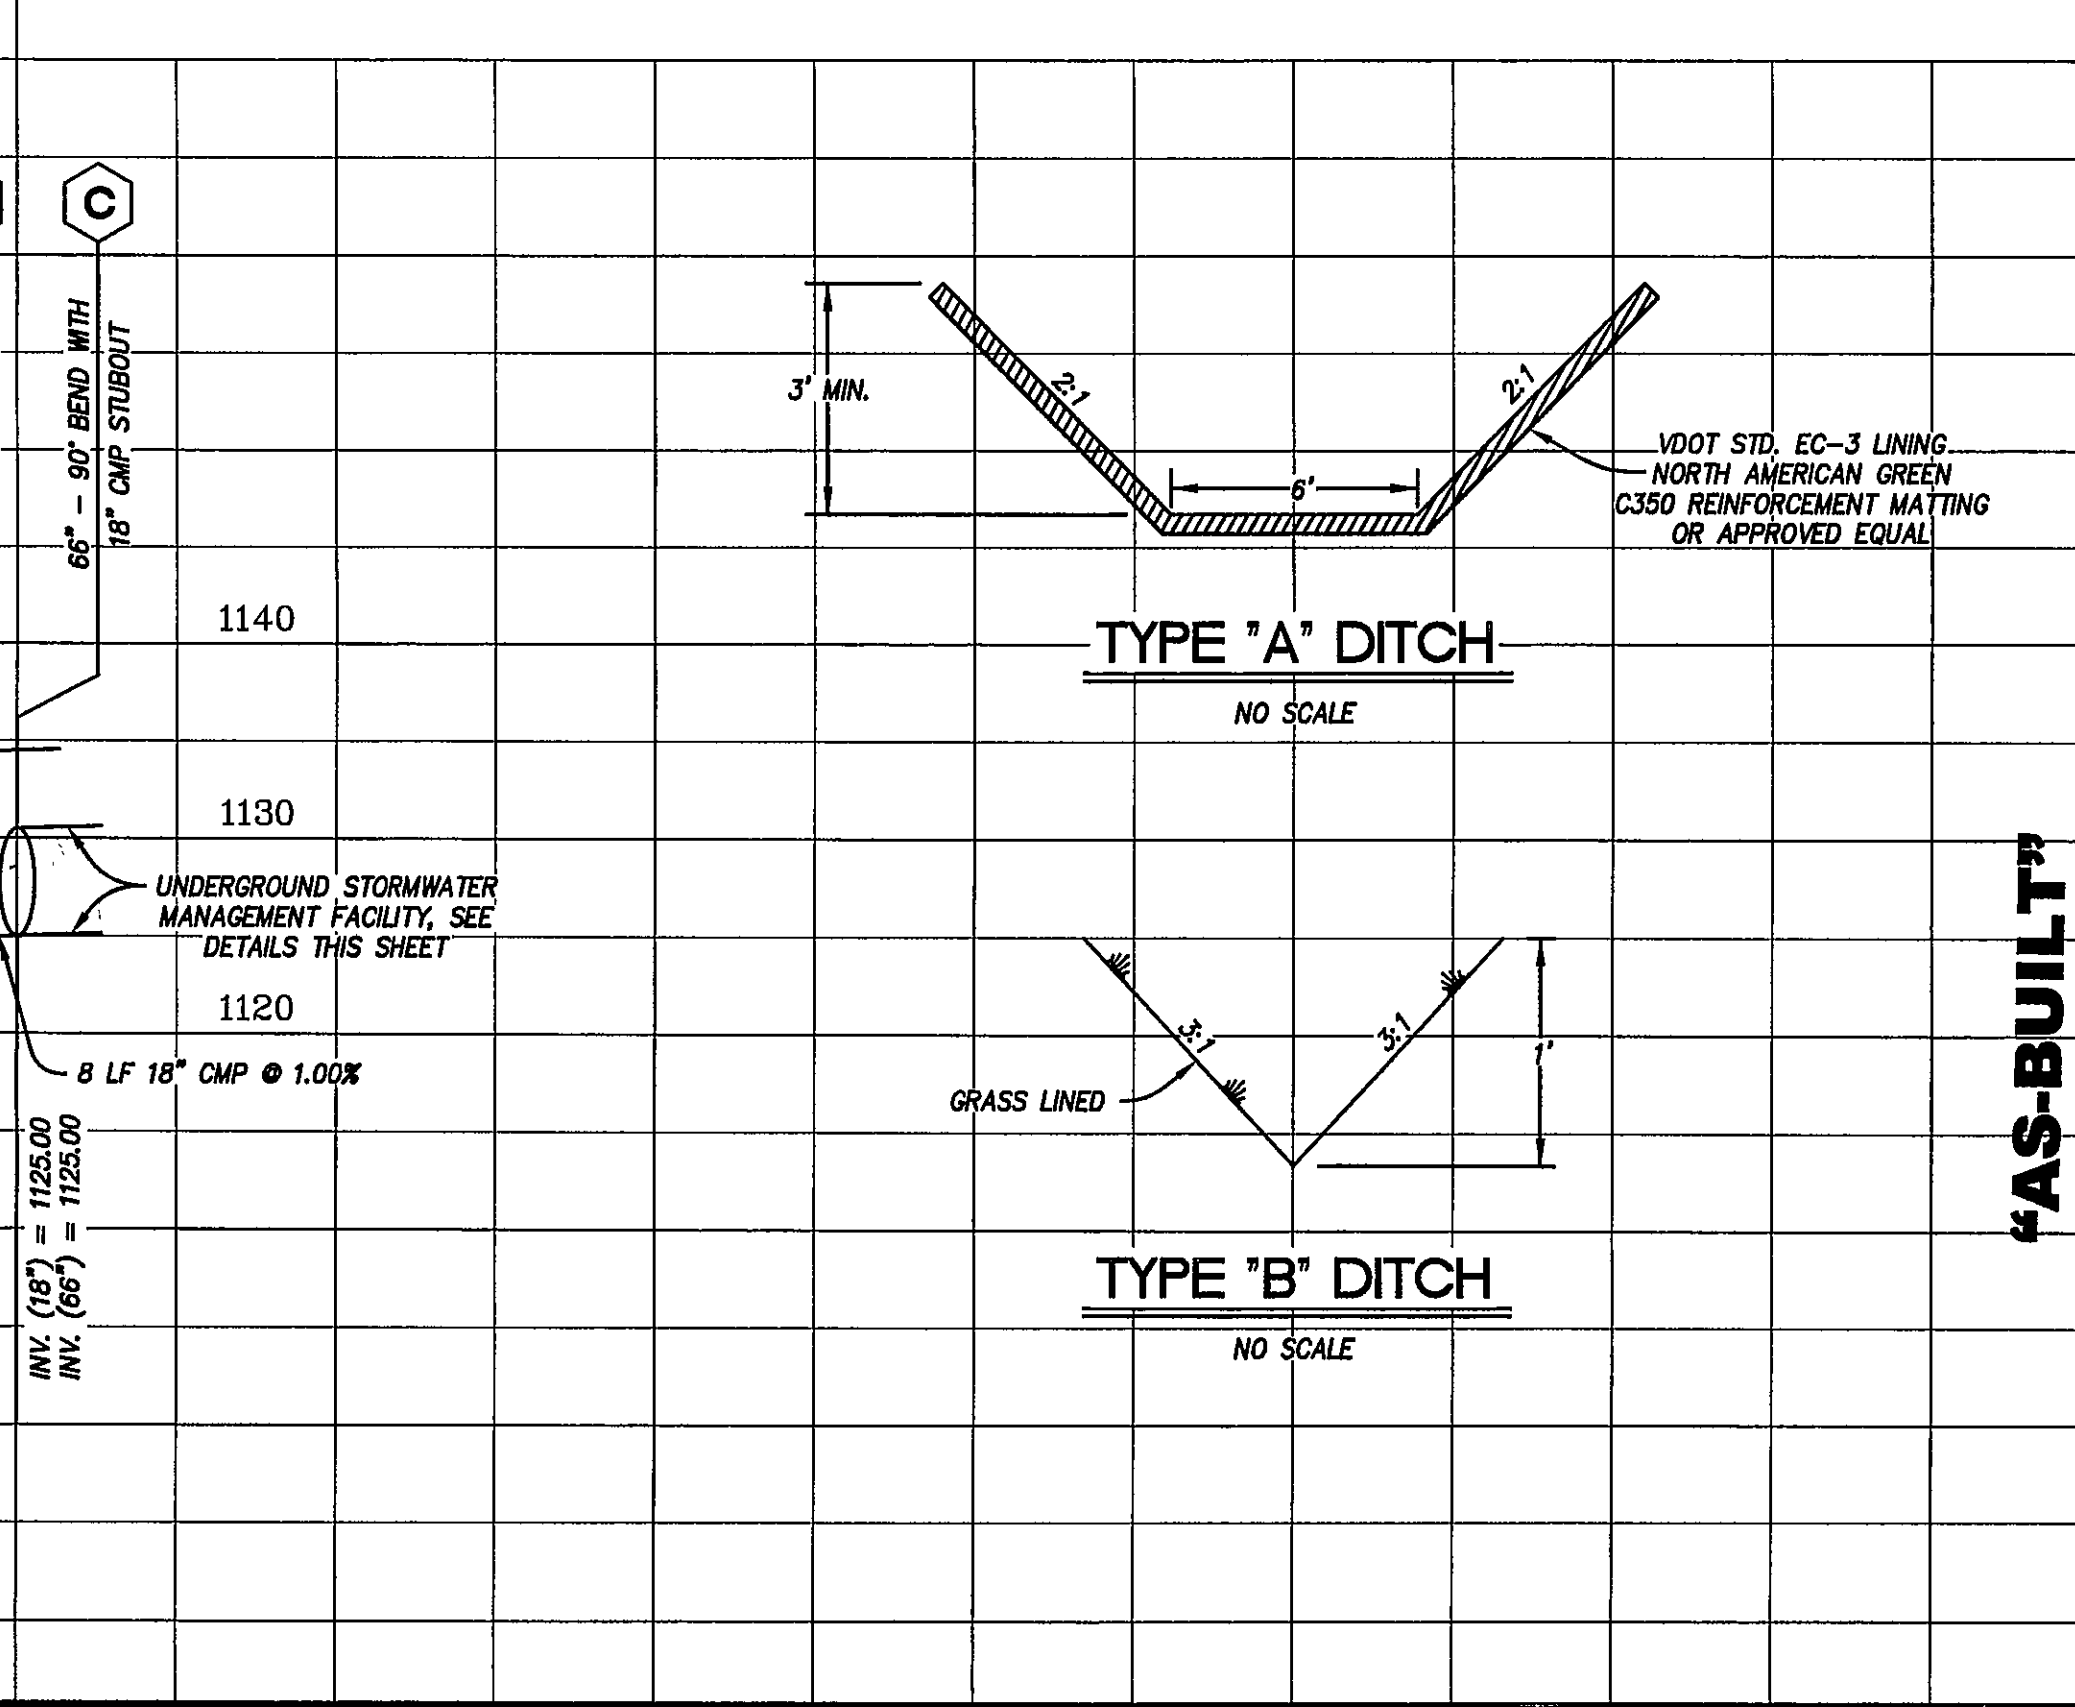
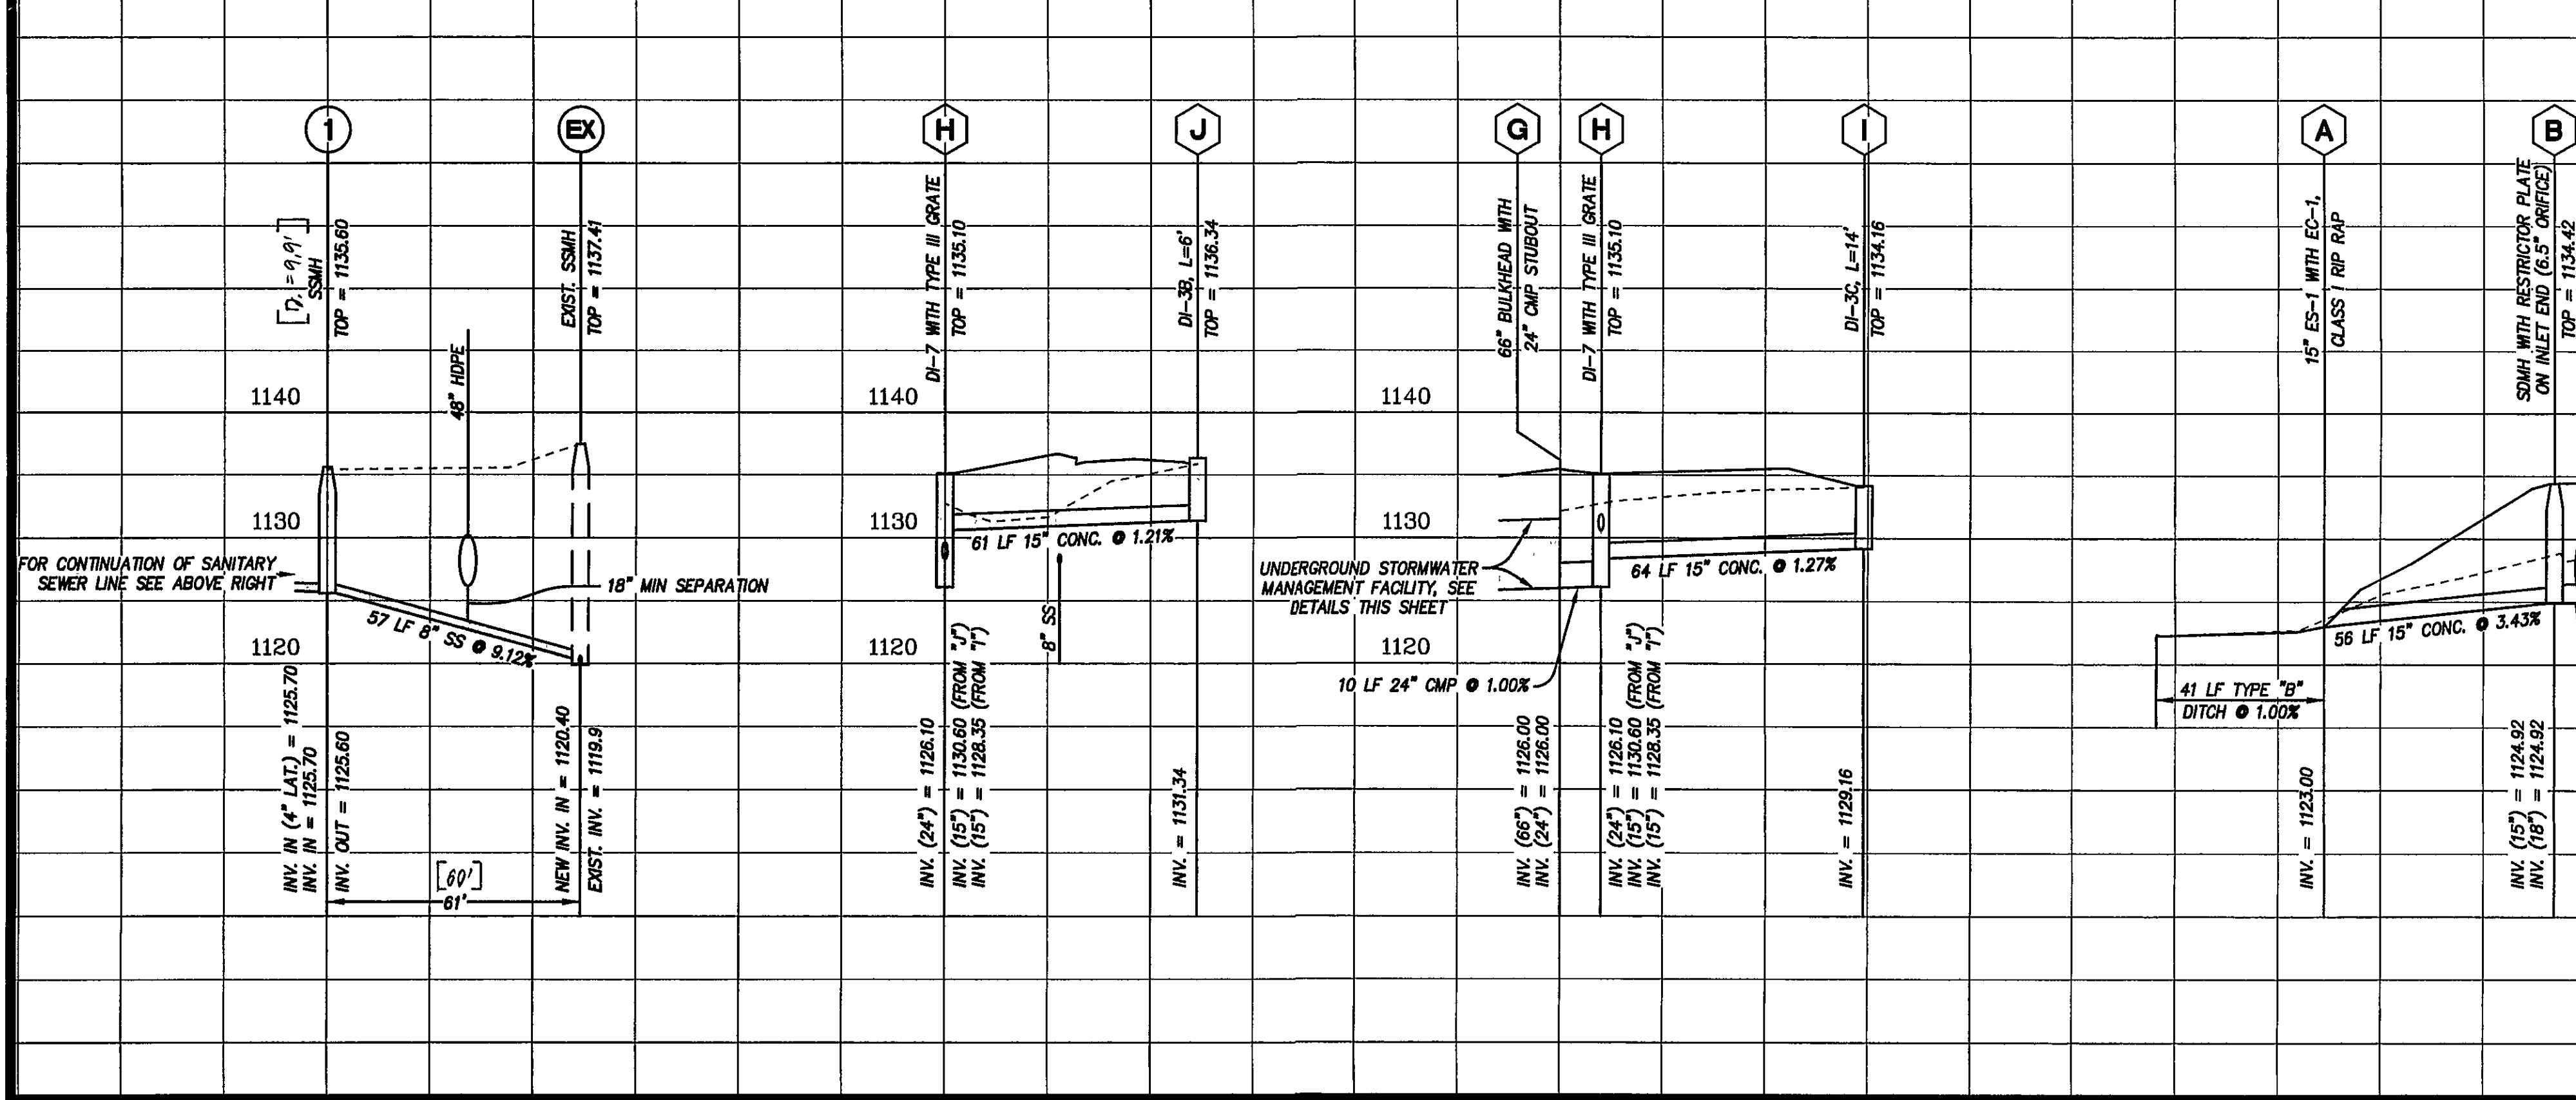
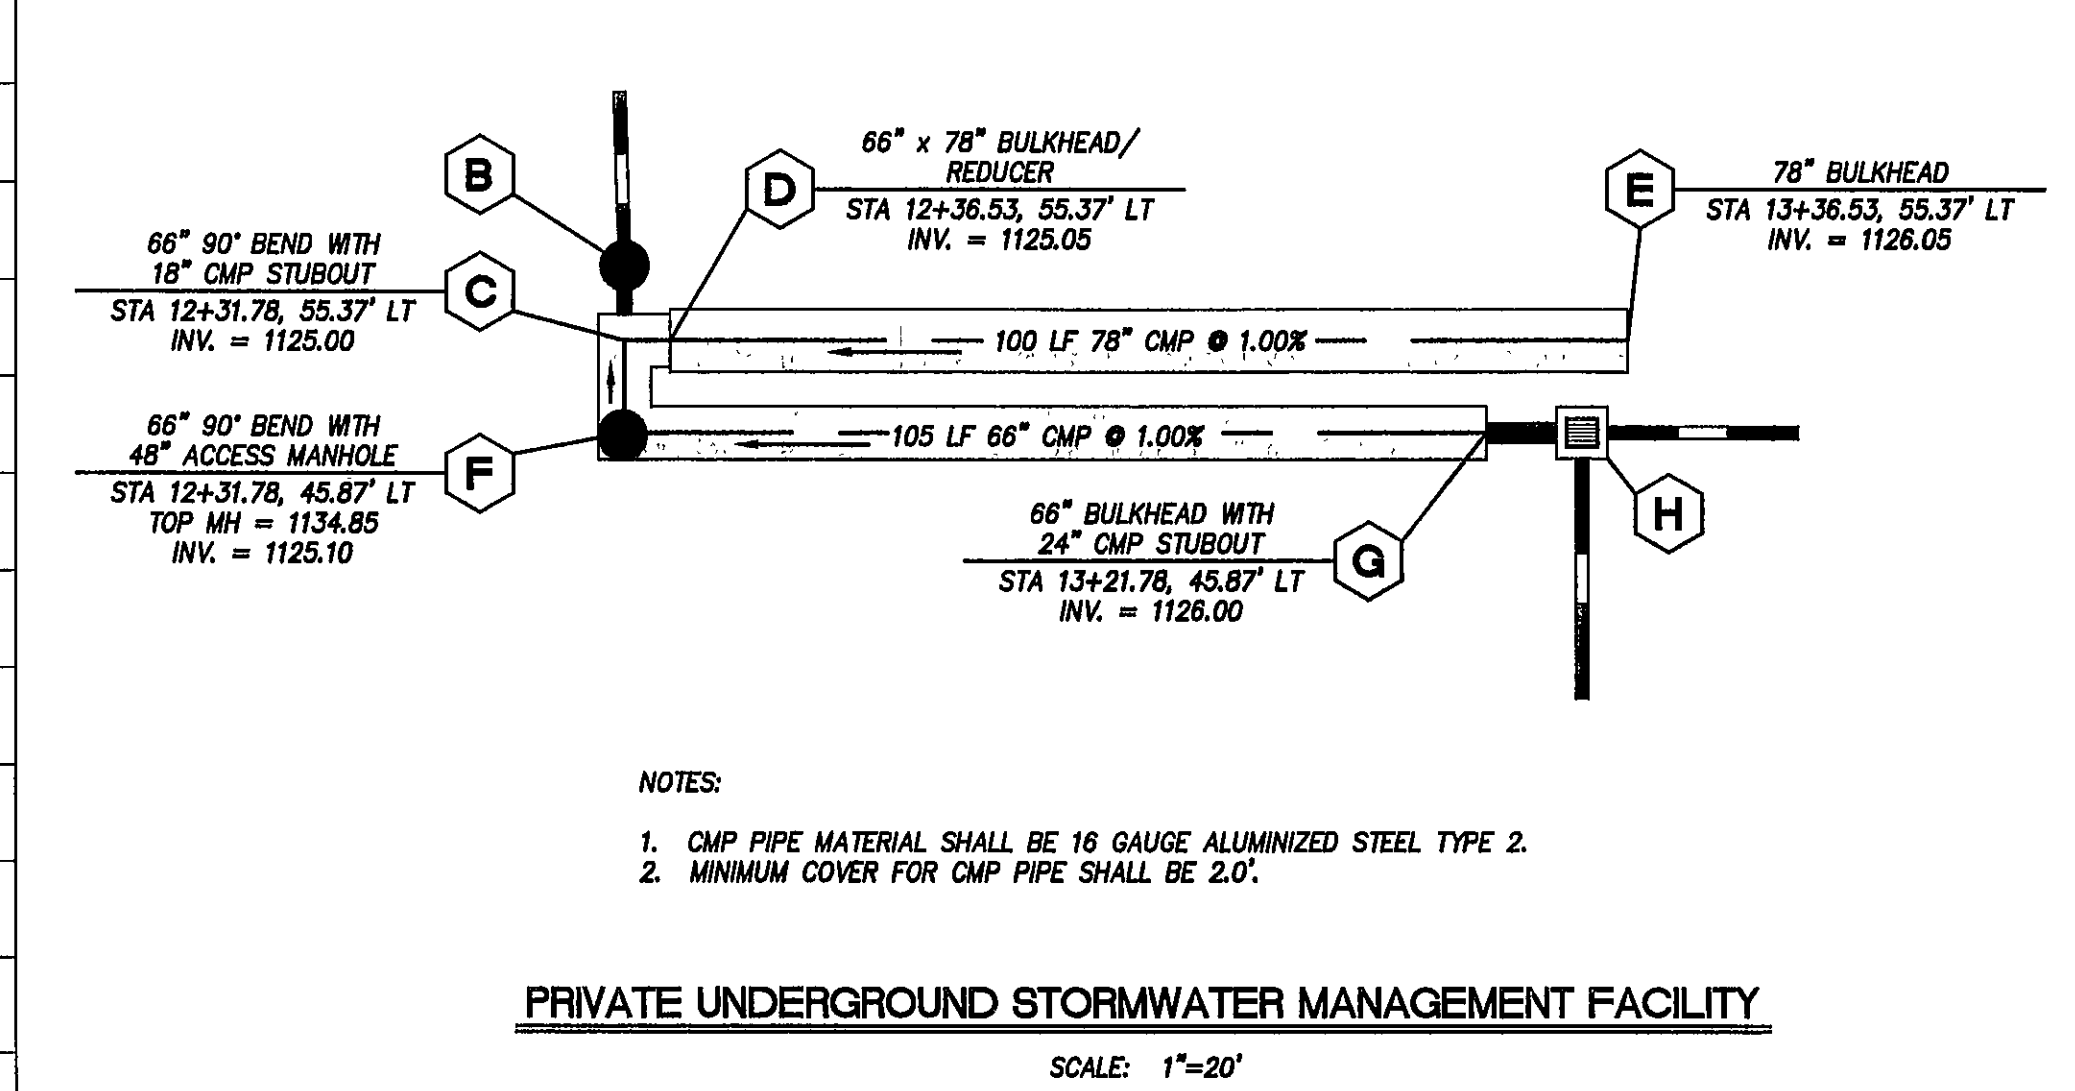
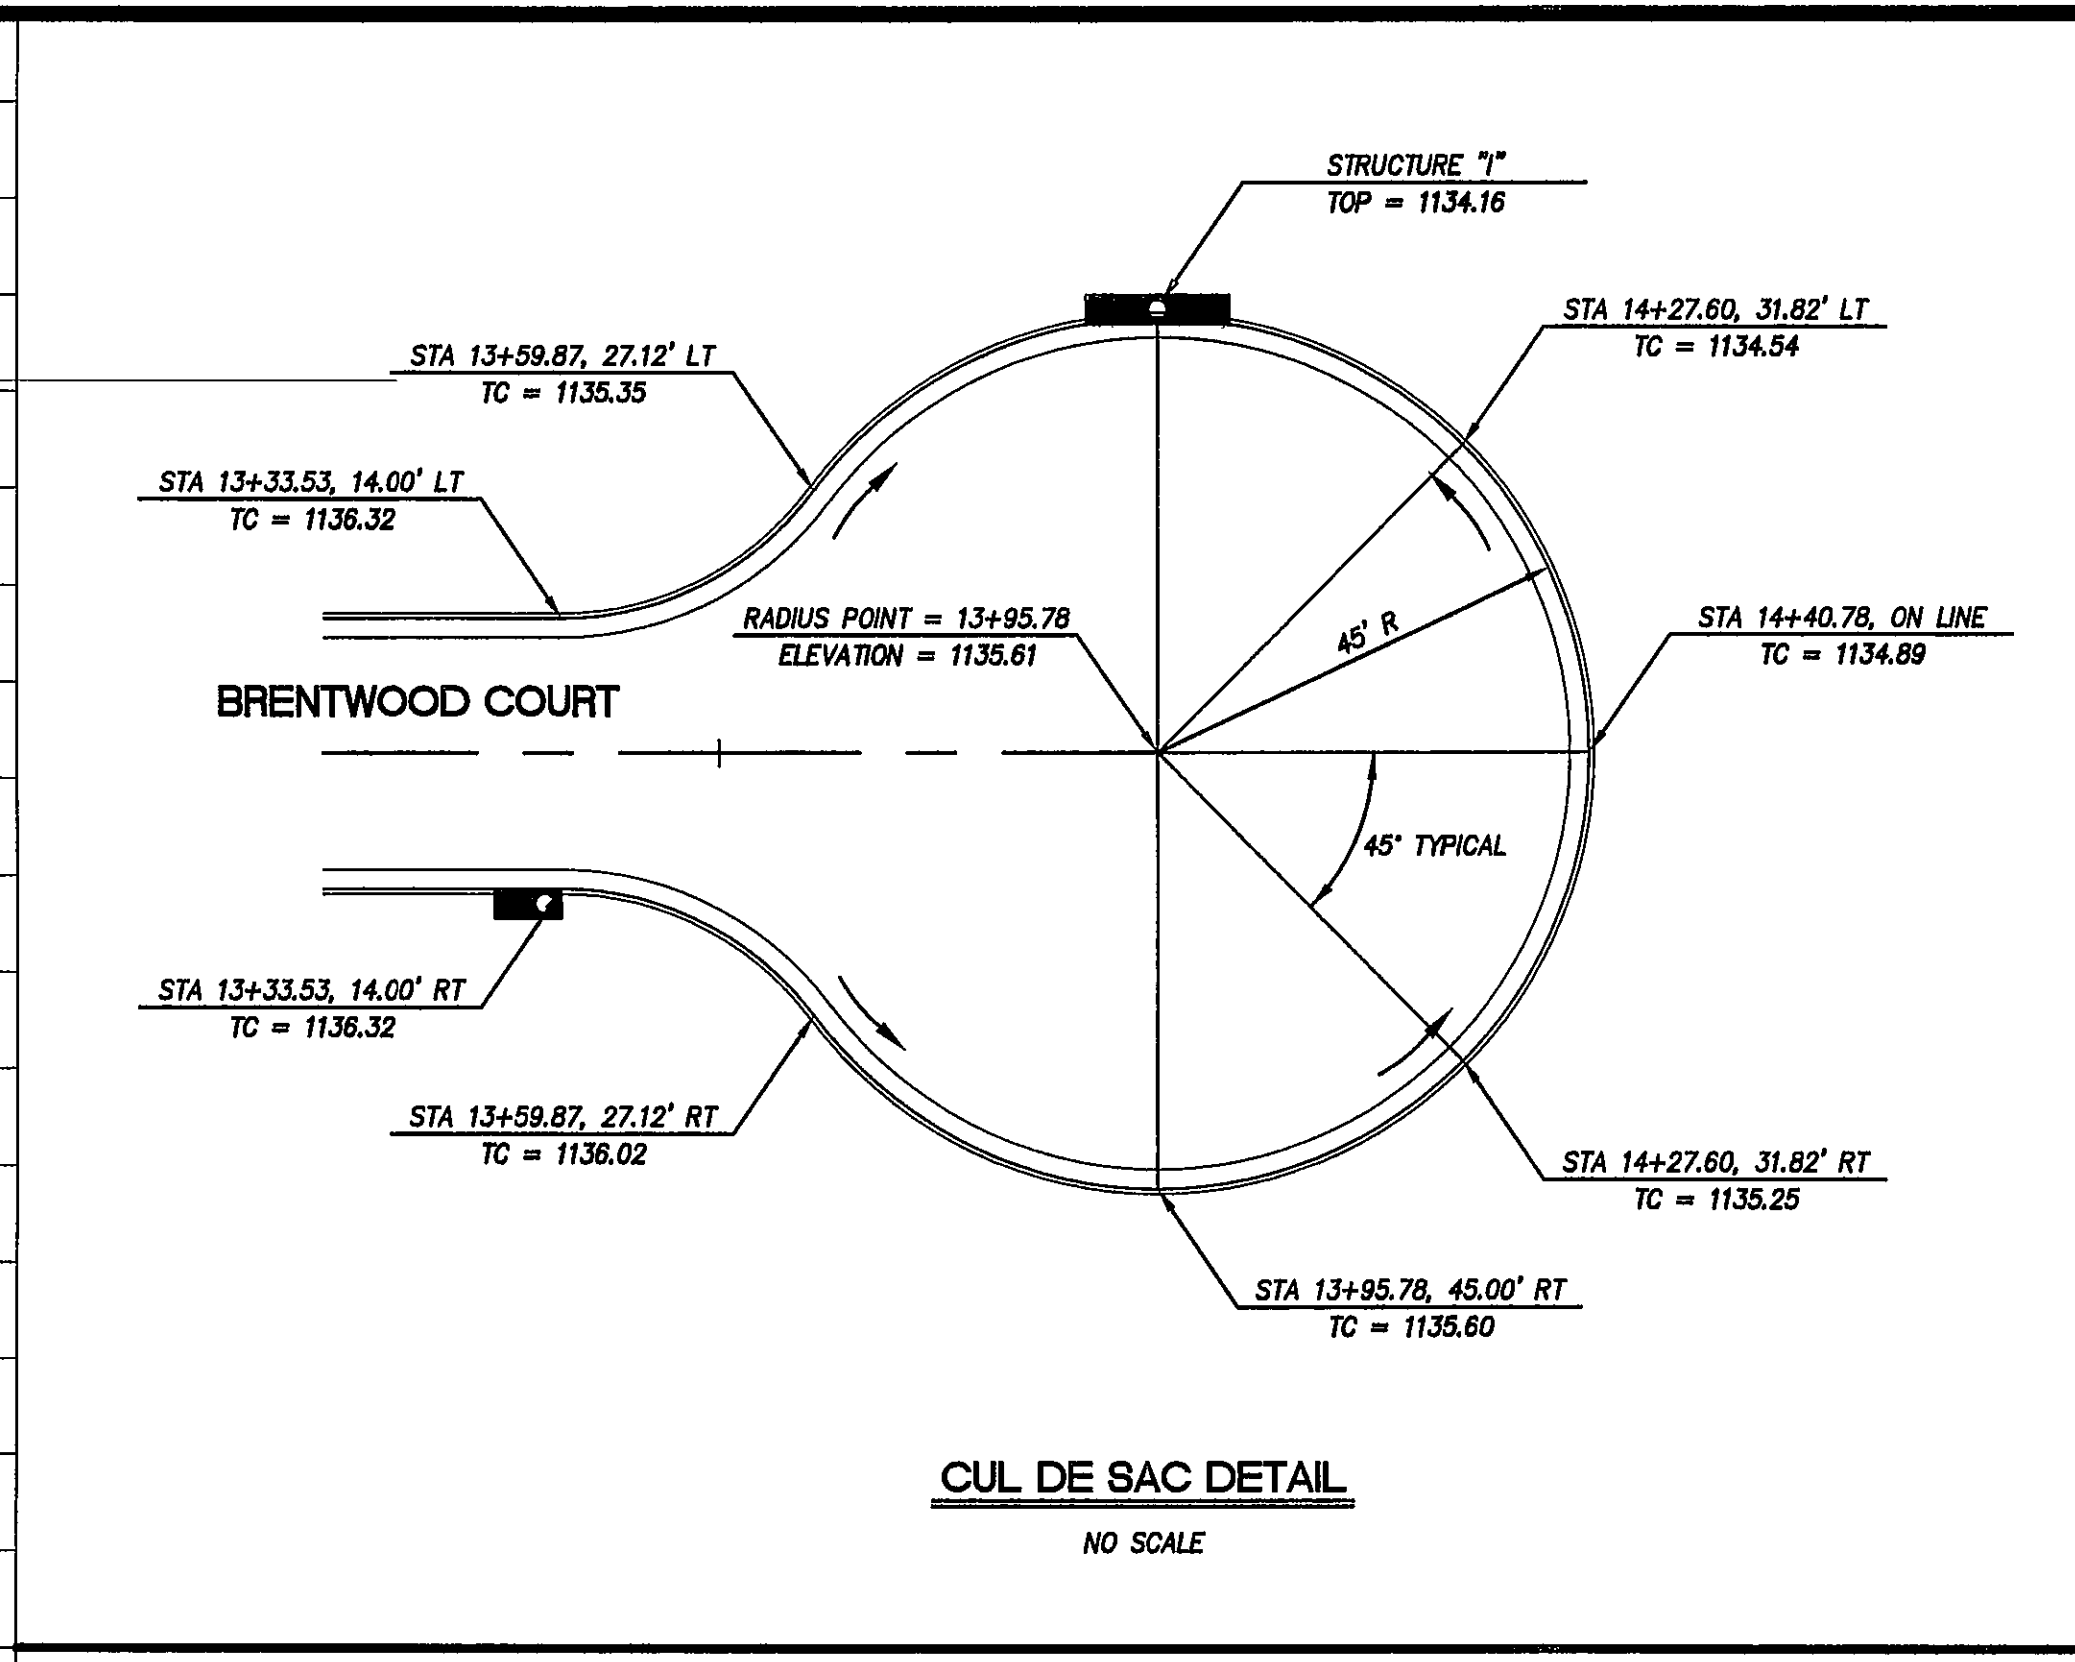


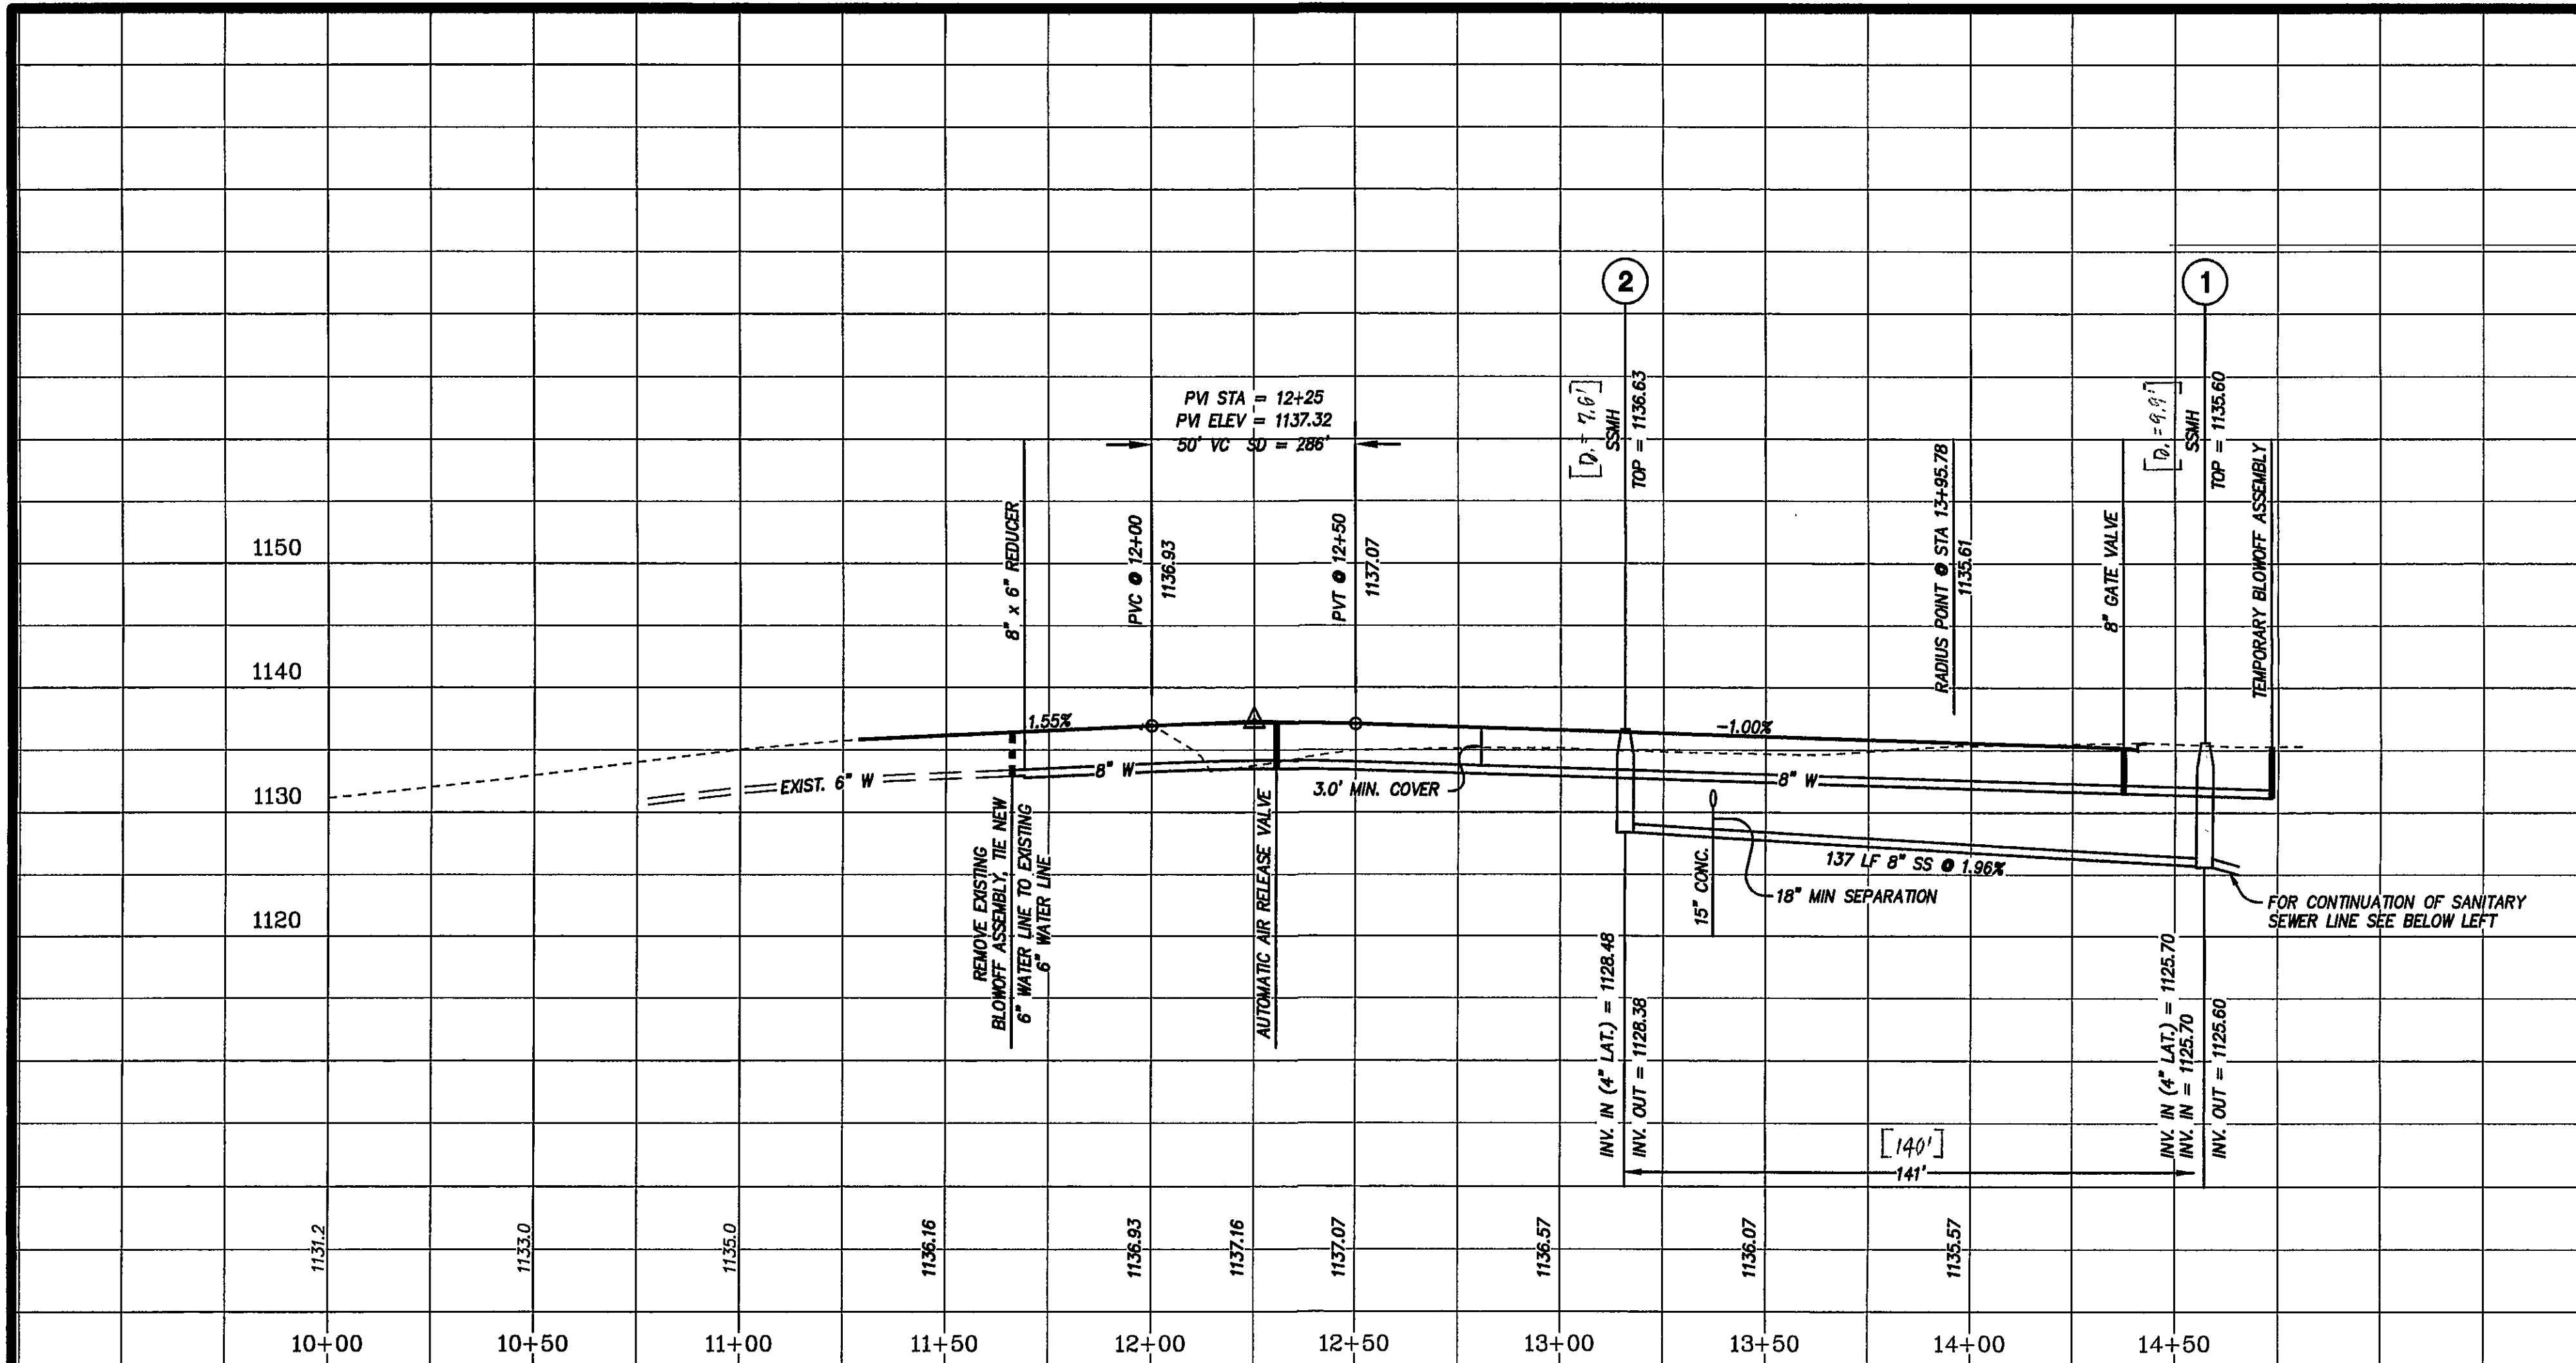

LA

LUMSDEN ASSOCIATES, P.C.
ENGINEERS-SURVEYORS-PLANNERS
ROANOKE, VIRGINIA

PHONE: (540) 774-4411
FAX: (540) 772-9445
E-MAIL: MAIL@LUMSDENPC.COM

4664 BRAMBLETON AVENUE
P.O. BOX 20669
ROANOKE, VIRGINIA 24018

COMMONWEALTH OF VIRGINIA
THOMAS C. DALE
No. 033002
12/16/02
PROFESSIONAL ENGINEER

PROFILES

"THE MANOR AT KINGSTON COURT"
PREPARED FOR
STEPHEN A. STILWELL AND
JEFFREY S. TODD
CAVE SPRING MAGISTERIAL DISTRICT
ROANOKE COUNTY, VIRGINIA

REVISIONS

NO.	DATE	DESCRIPTION
1	12/16/02	REVISED DEVELOPMENT NAME
2	9/1/03	AS-BUILT SANITARY SEWER & WATER
3		
4		
5		

DATE:
NOVEMBER 14, 2002
SCALE:
(H) 1"=30' (V) 1"=10'
COMMISSION NO.:
2002-015
CADD FILE:
P:\2002\02015\ENGIN\015COMP.DWG

"AS-BUILT"

SHEET 7 OF 9