




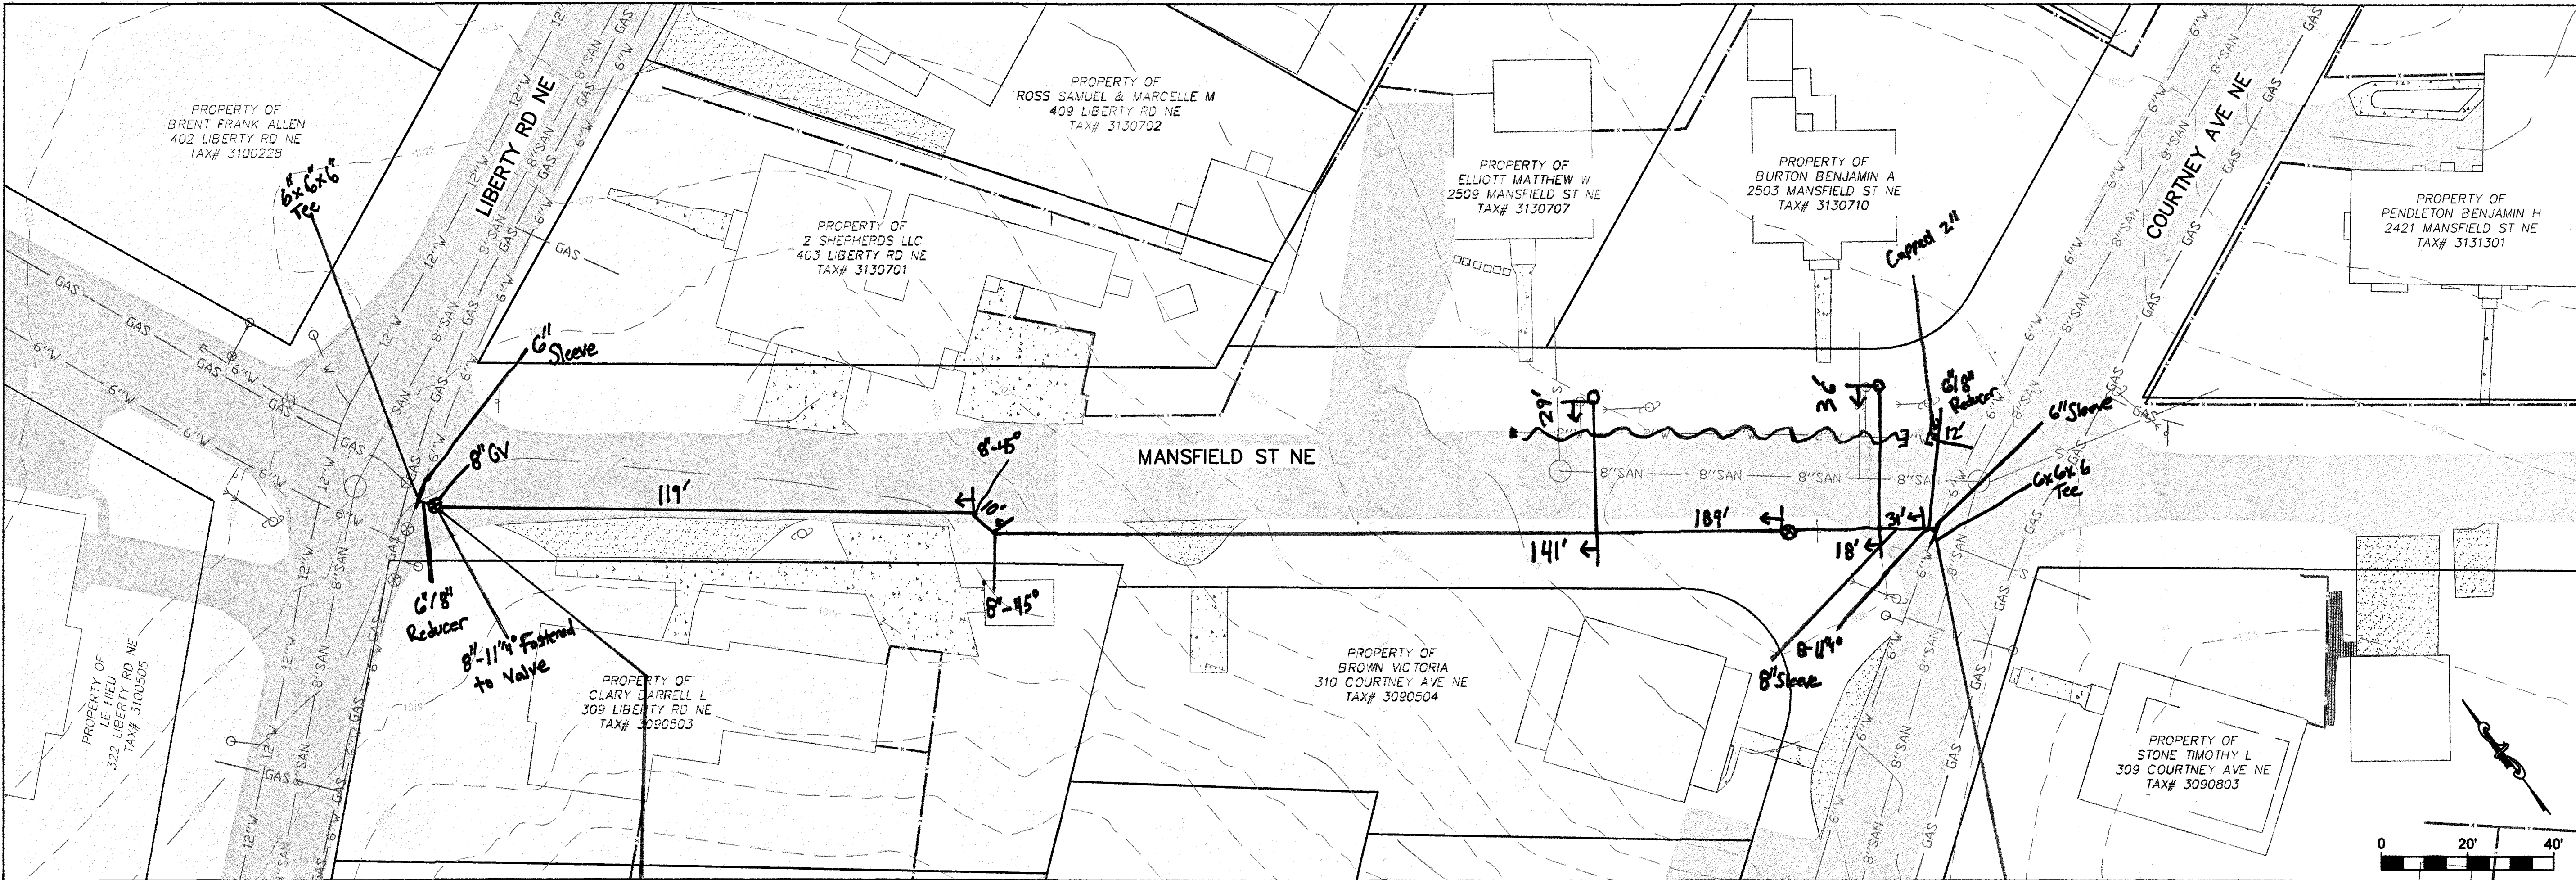

Install Contractor	WVWA	
Construction Start Date	2/27/24	
Completion Date	3/29/24	
Water Main(s)		
Manufacturer	Griffin	
Diameter	8"	
Pipe Class	C151 Class 350	
Material	Ductile Iron (DIP)	
Comments	362'	
Water Service(s)		
Manufacturer	Endot	
Diameter	1"	
Pipe Class	C151 Class 250	
Material	Poly Vinyl Chloride	
Comments	60'	
Water Valve(s) 1		Water Valve(s) 2
Manufacturer	American Valve	
Valve Type	Gate	
Diameter	8"	
Direction to Open / Turns to Close	Right to Close	
Comments	Placed 2 valves	
Water Valve(s) 3		Water Valve(s) 4
Manufacturer		
Valve Type		
Diameter		
Direction to Close / Turns to Close		
Comments		
Hydrant(s)		
Authority ID #		
Manufacturer		
Model		
Cast Date		
Static Pressure		
Comments		

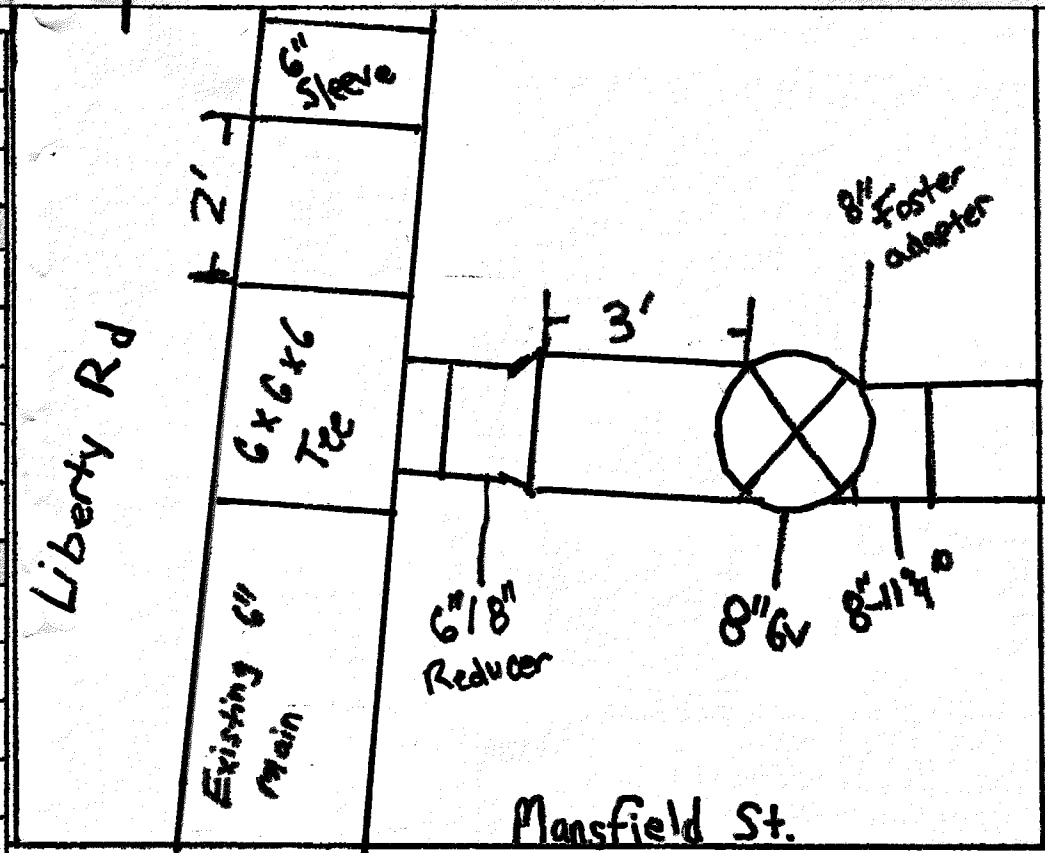

- GENERAL NOTES:
- SEWER LATERALS SHOWN ARE BASED ON CCTV FOOTAGE PROVIDED BY PARKER DESIGN GROUP. ADDITIONAL LATERALS & CONFLICTS SHALL BE INVESTIGATED PRIOR TO EXCAVATION.
 - PROPERTY LINES SHOWN ON THIS PAGE ARE BASED ON GIS DATA AND HAVE NOT BEEN FIELD SURVEYED.

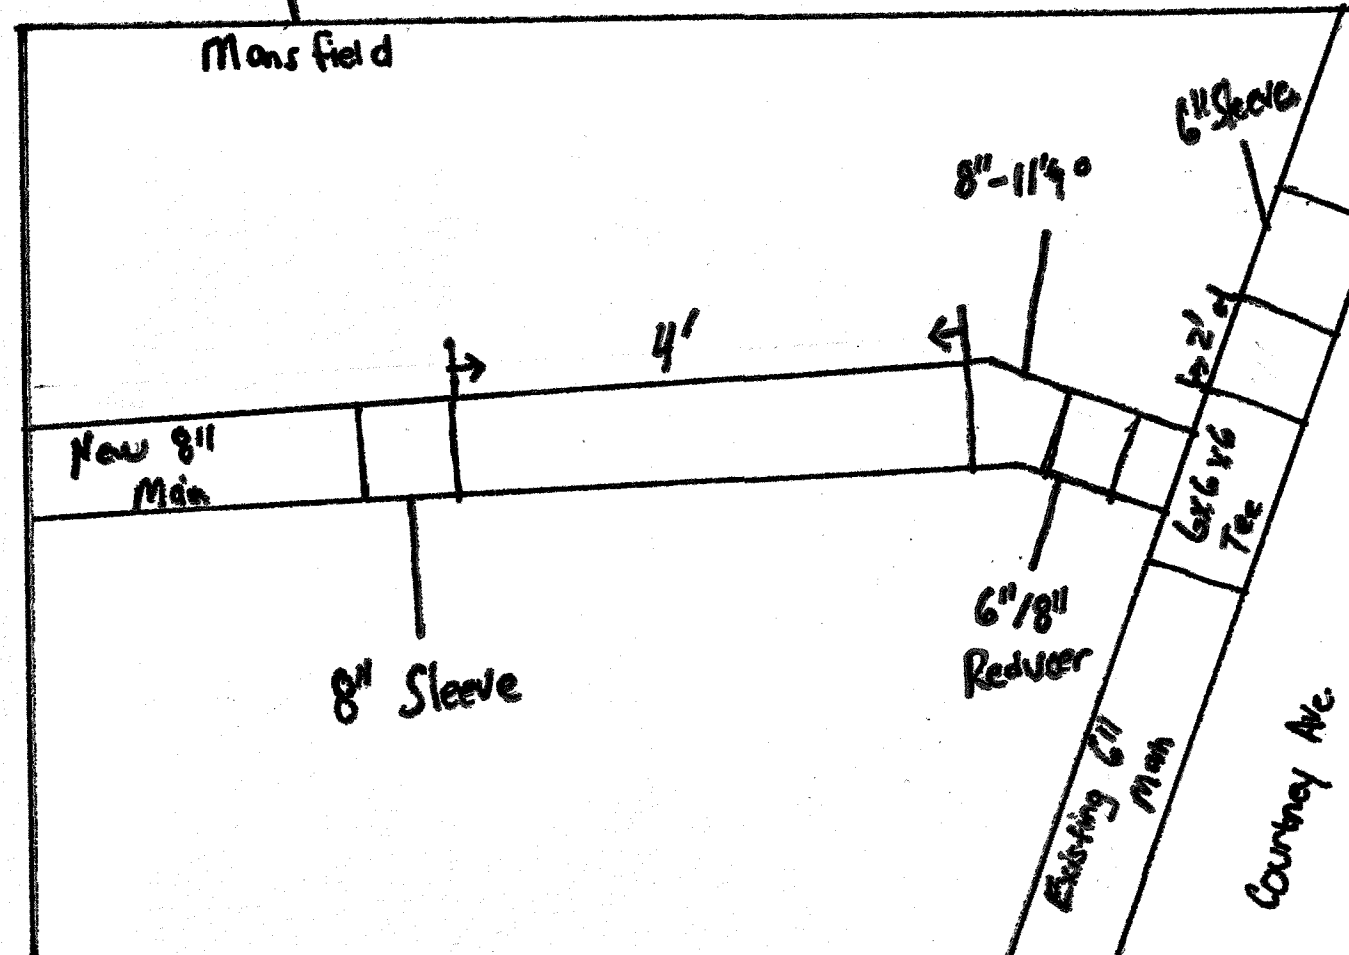

Rev	By	Date	Description
1	MC	4-2-24	As built - Michael Chesley
Designed: WVWA			
Drawn: NSS			
Checked: AJC			
Approved:			
Date: FEB 2024			
Project: WCIP-447			
1			
Sheet 1 of 1			