


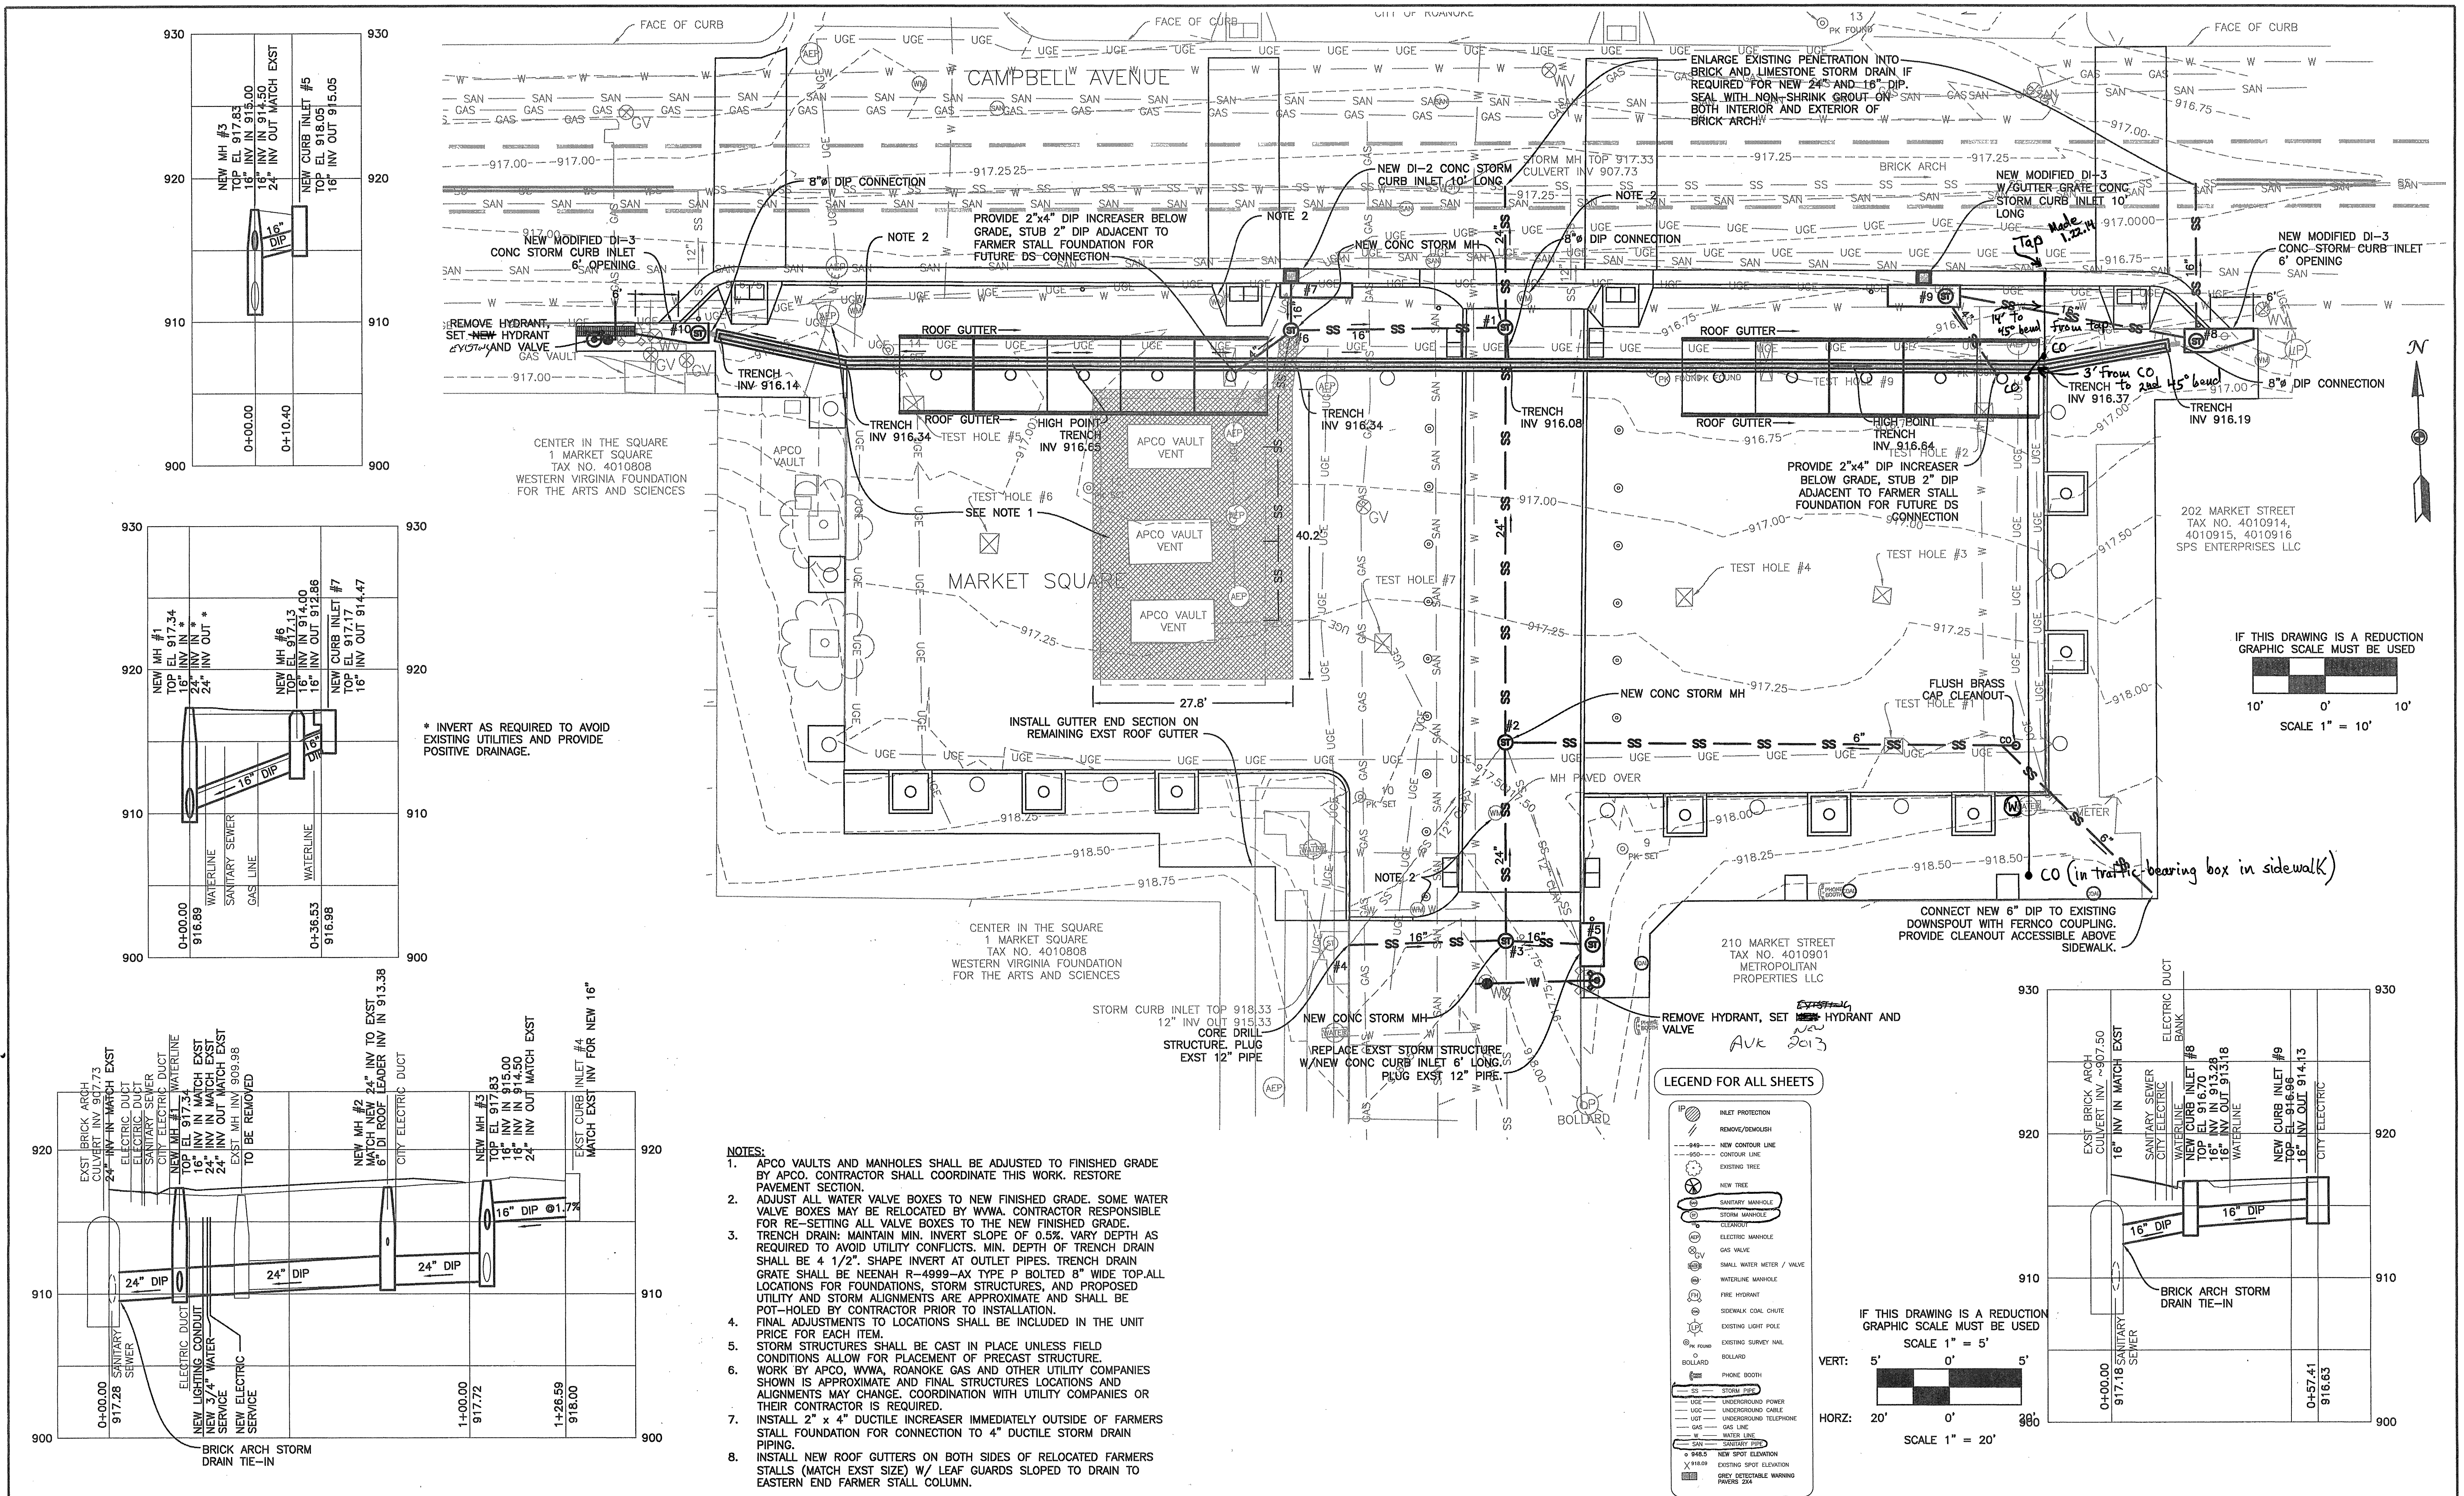

As-Built 2.19.14 K. Winslow