


(540) 966-3027 TEL
(540) 966-5906 FAX
e-mail: rpierse@rbnet.co

SITE PLAN

Asbuit: 03/20/2020

I Herely Certify That The Work Was Done In Accordance With These Documents, With Reasonable Accuracy, And That Any Deviations Have Been Red-Line Annotated Or Otherwise Captured In Change Order Documentatlon.

Contractor's Signature, Date:

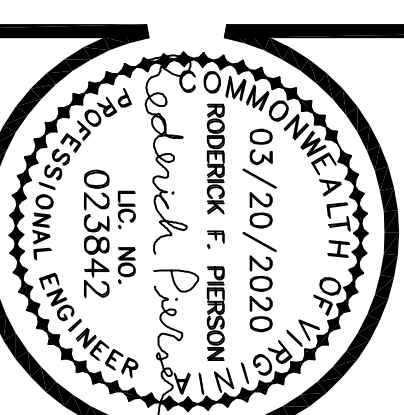

COMMISSION
R2019124
SHEET
1 of 2

