



PROFILE	SURVEYED	BY	DATE
	PLOTTED		
	GRADES CHECKED		
	B.M.'S NOTED		
	STRIKES NOTATION CHECKED		

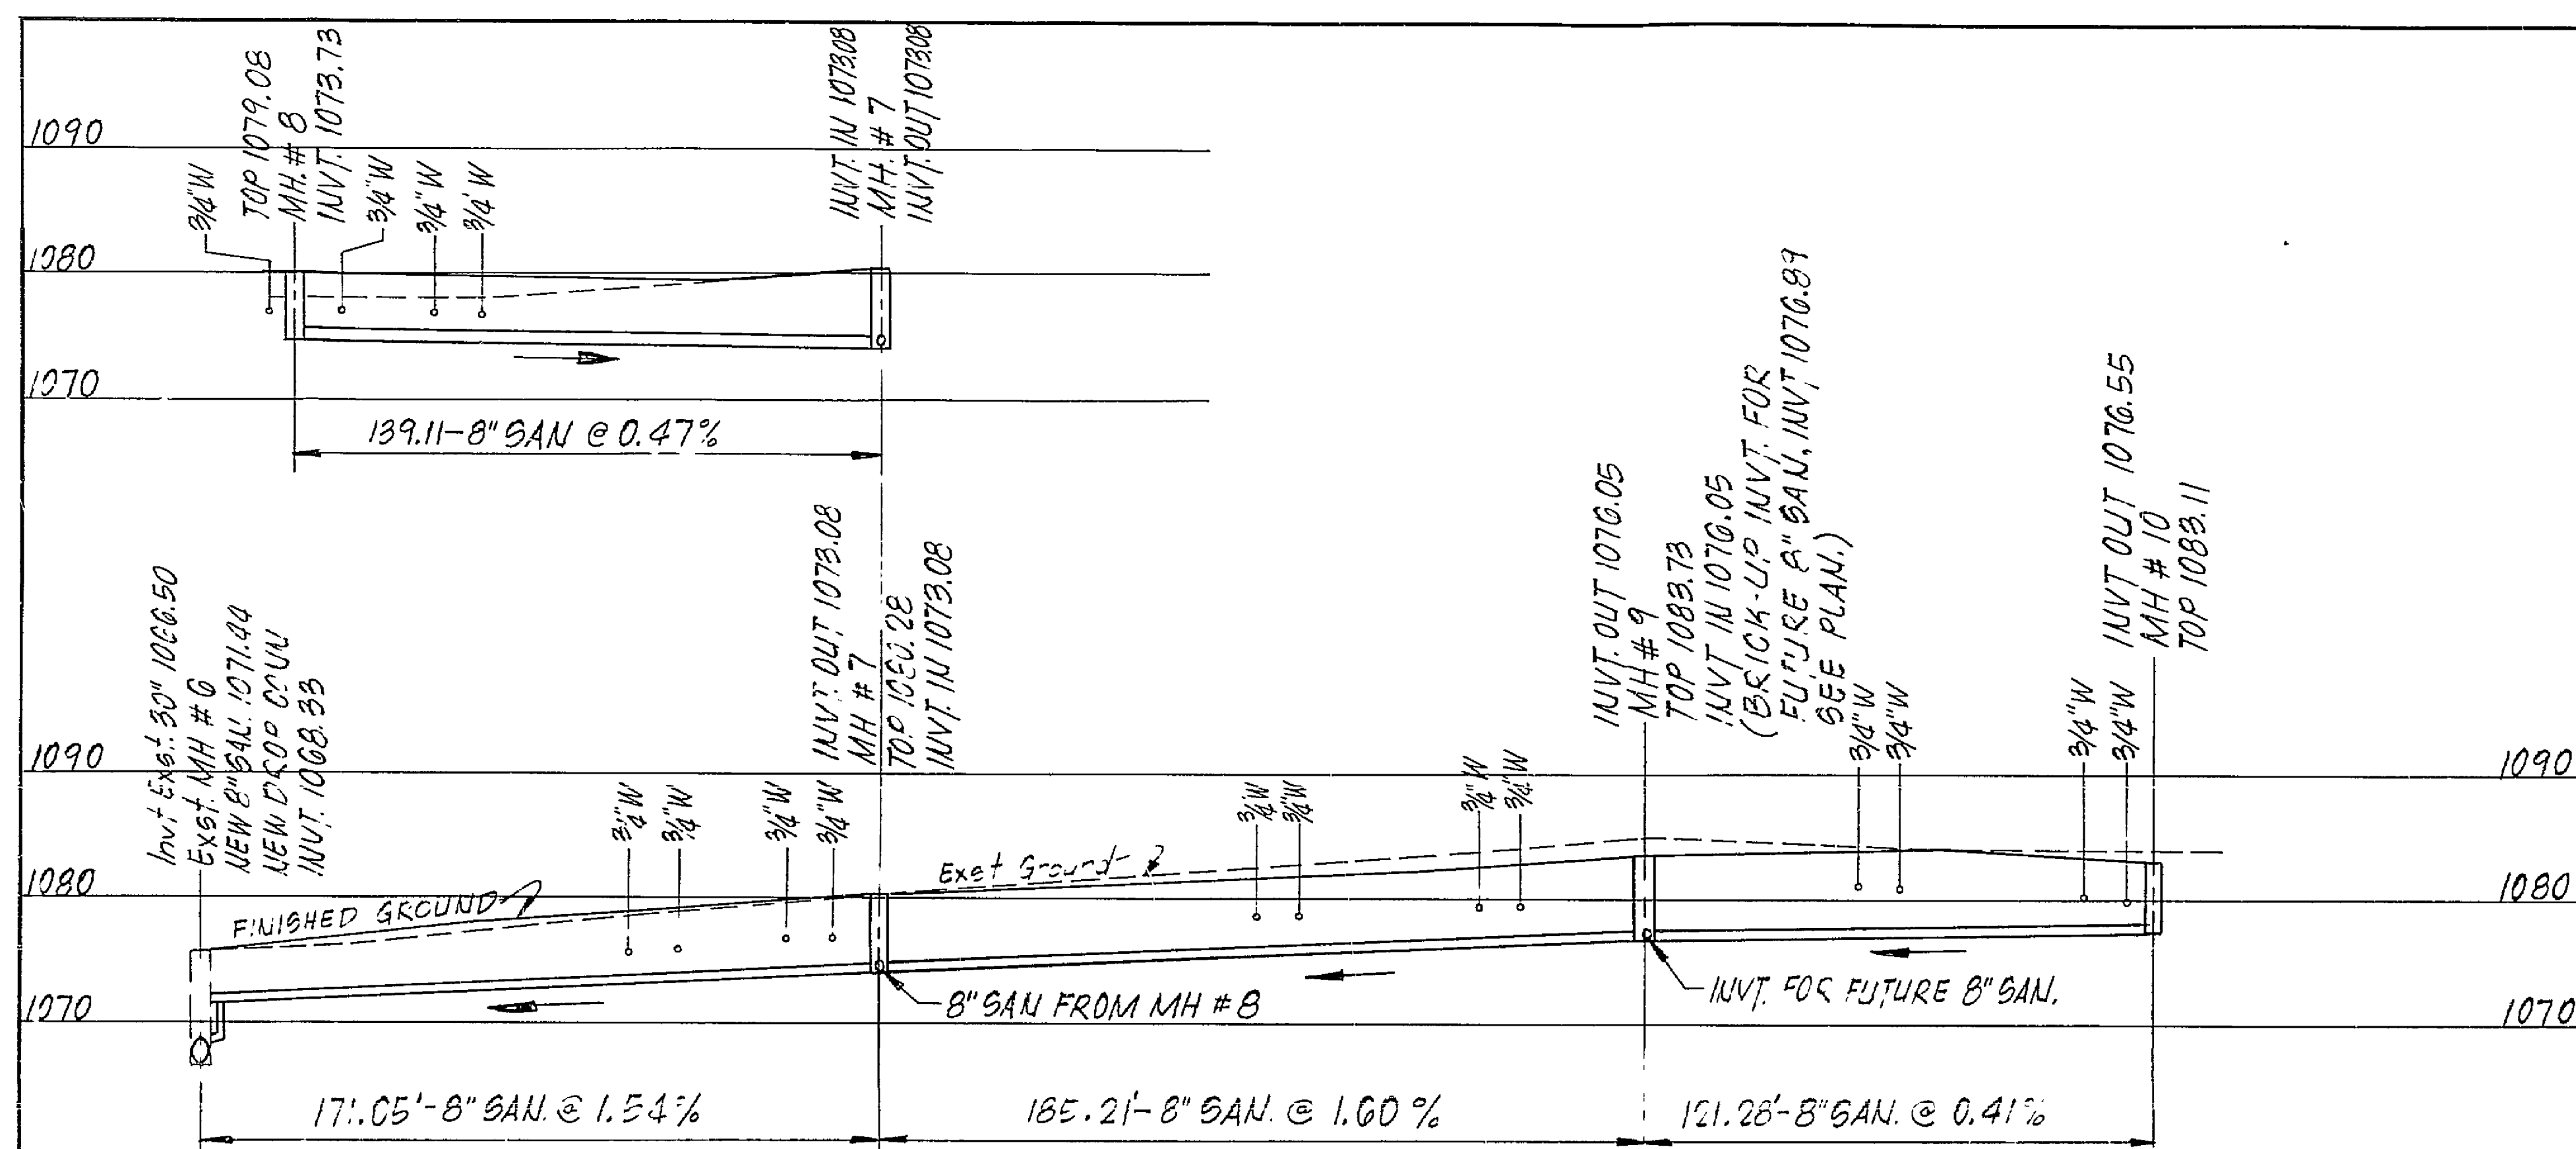

PROFILE-8" SANITARY SEWER (MH#6-10)

Scale. Horiz $1'' = 30'$
Vert. $1'' = 10'$

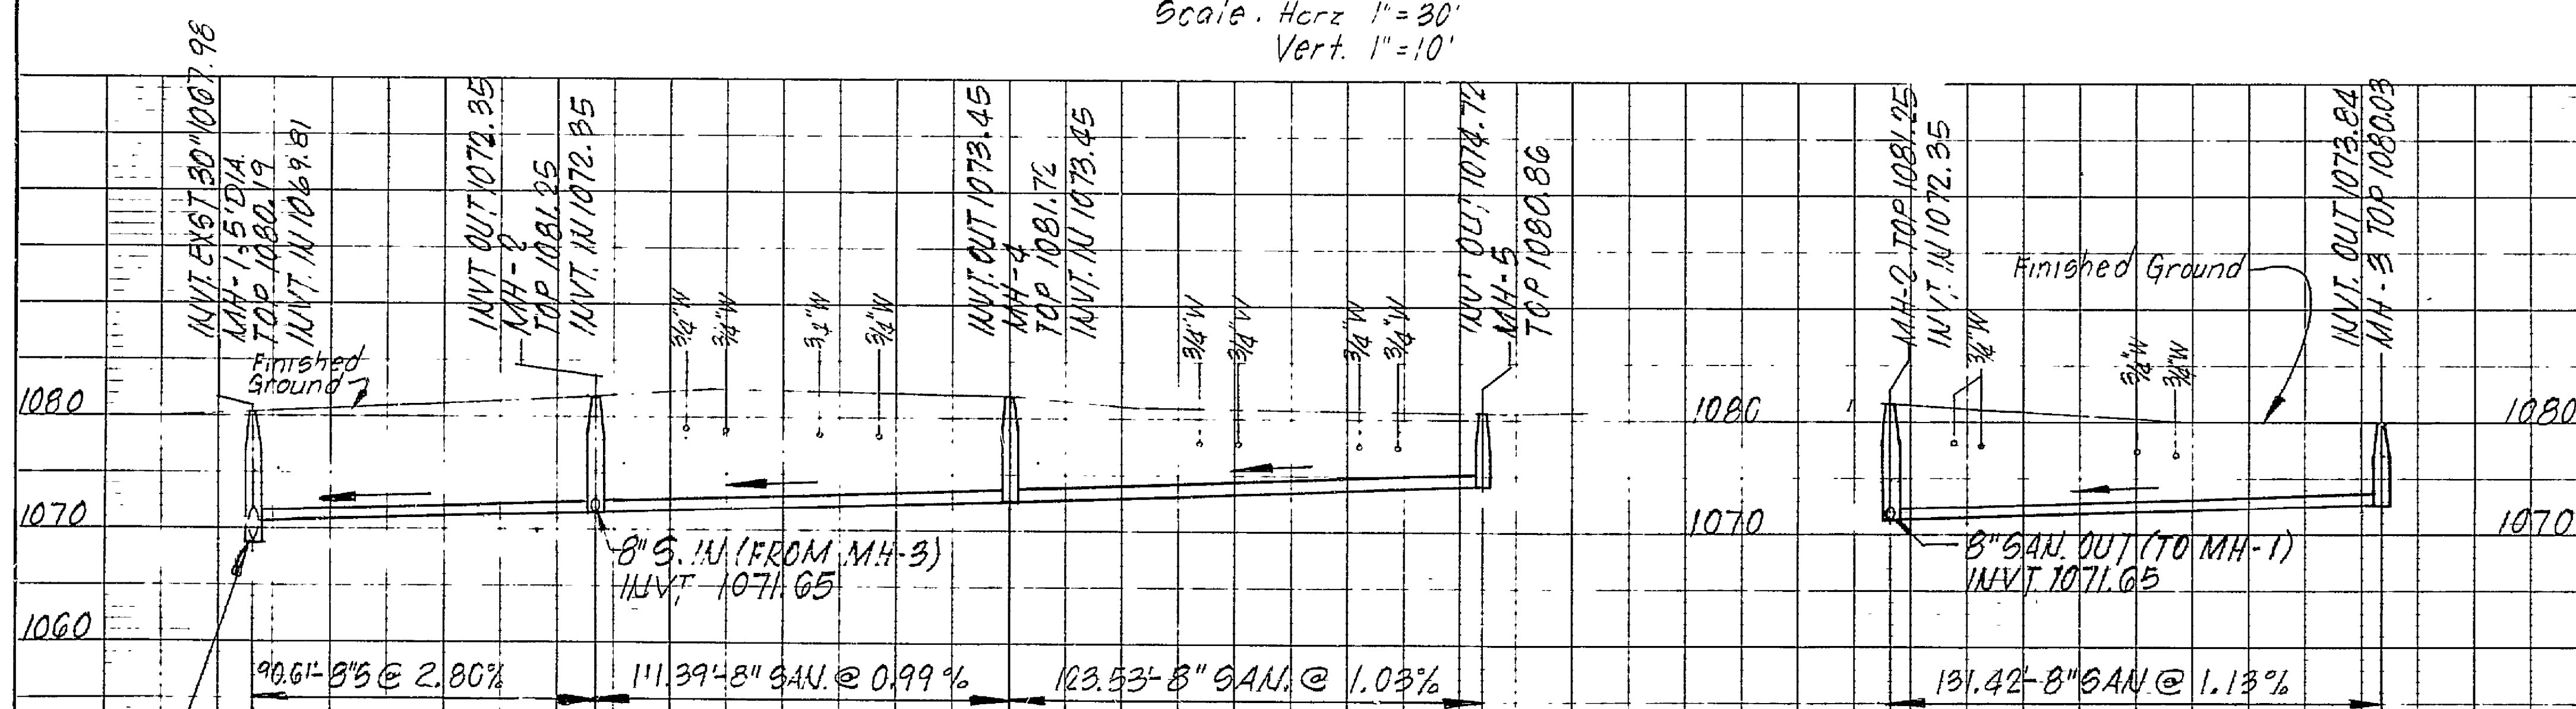

PROFILE 8" SANITARY SEWER

Scale: Horiz: 1" = 30'
Vert: 1" = 10'

2	5-B-87	REVISED 40 BUILD-5	RSV	KDA
1	3-21-84	PRE-FILE MA-G-10	BSM	SAW
REVISION	DATE	DESCRIPTION	BY	APP
DESIGNED		MEADOWBROOK CONDOMINIUMS PHASE I & II		
DRAWN	BSM			
CHECKED	SWH			
APPROVED				
SUBMITTED				
Mattern and Craig CONSULTING ENGINEERS ROANOKE, VIRGINIA			SCALE	NOTED
			DATE	SEPT. 83
			COMM. NO.	380
			SHEET	C-4

Mattern and Craig
CONSULTING ENGINEERS
ROANOKE, VIRGINIA

SCALE <i>NOTED</i>	COMM. NO. <i>380</i>
DATE <i>SEPT. 83</i>	SHEET <i>C-4</i>

RECORD DRAWING RC-2458

RECORD DRAWING RC-2458