



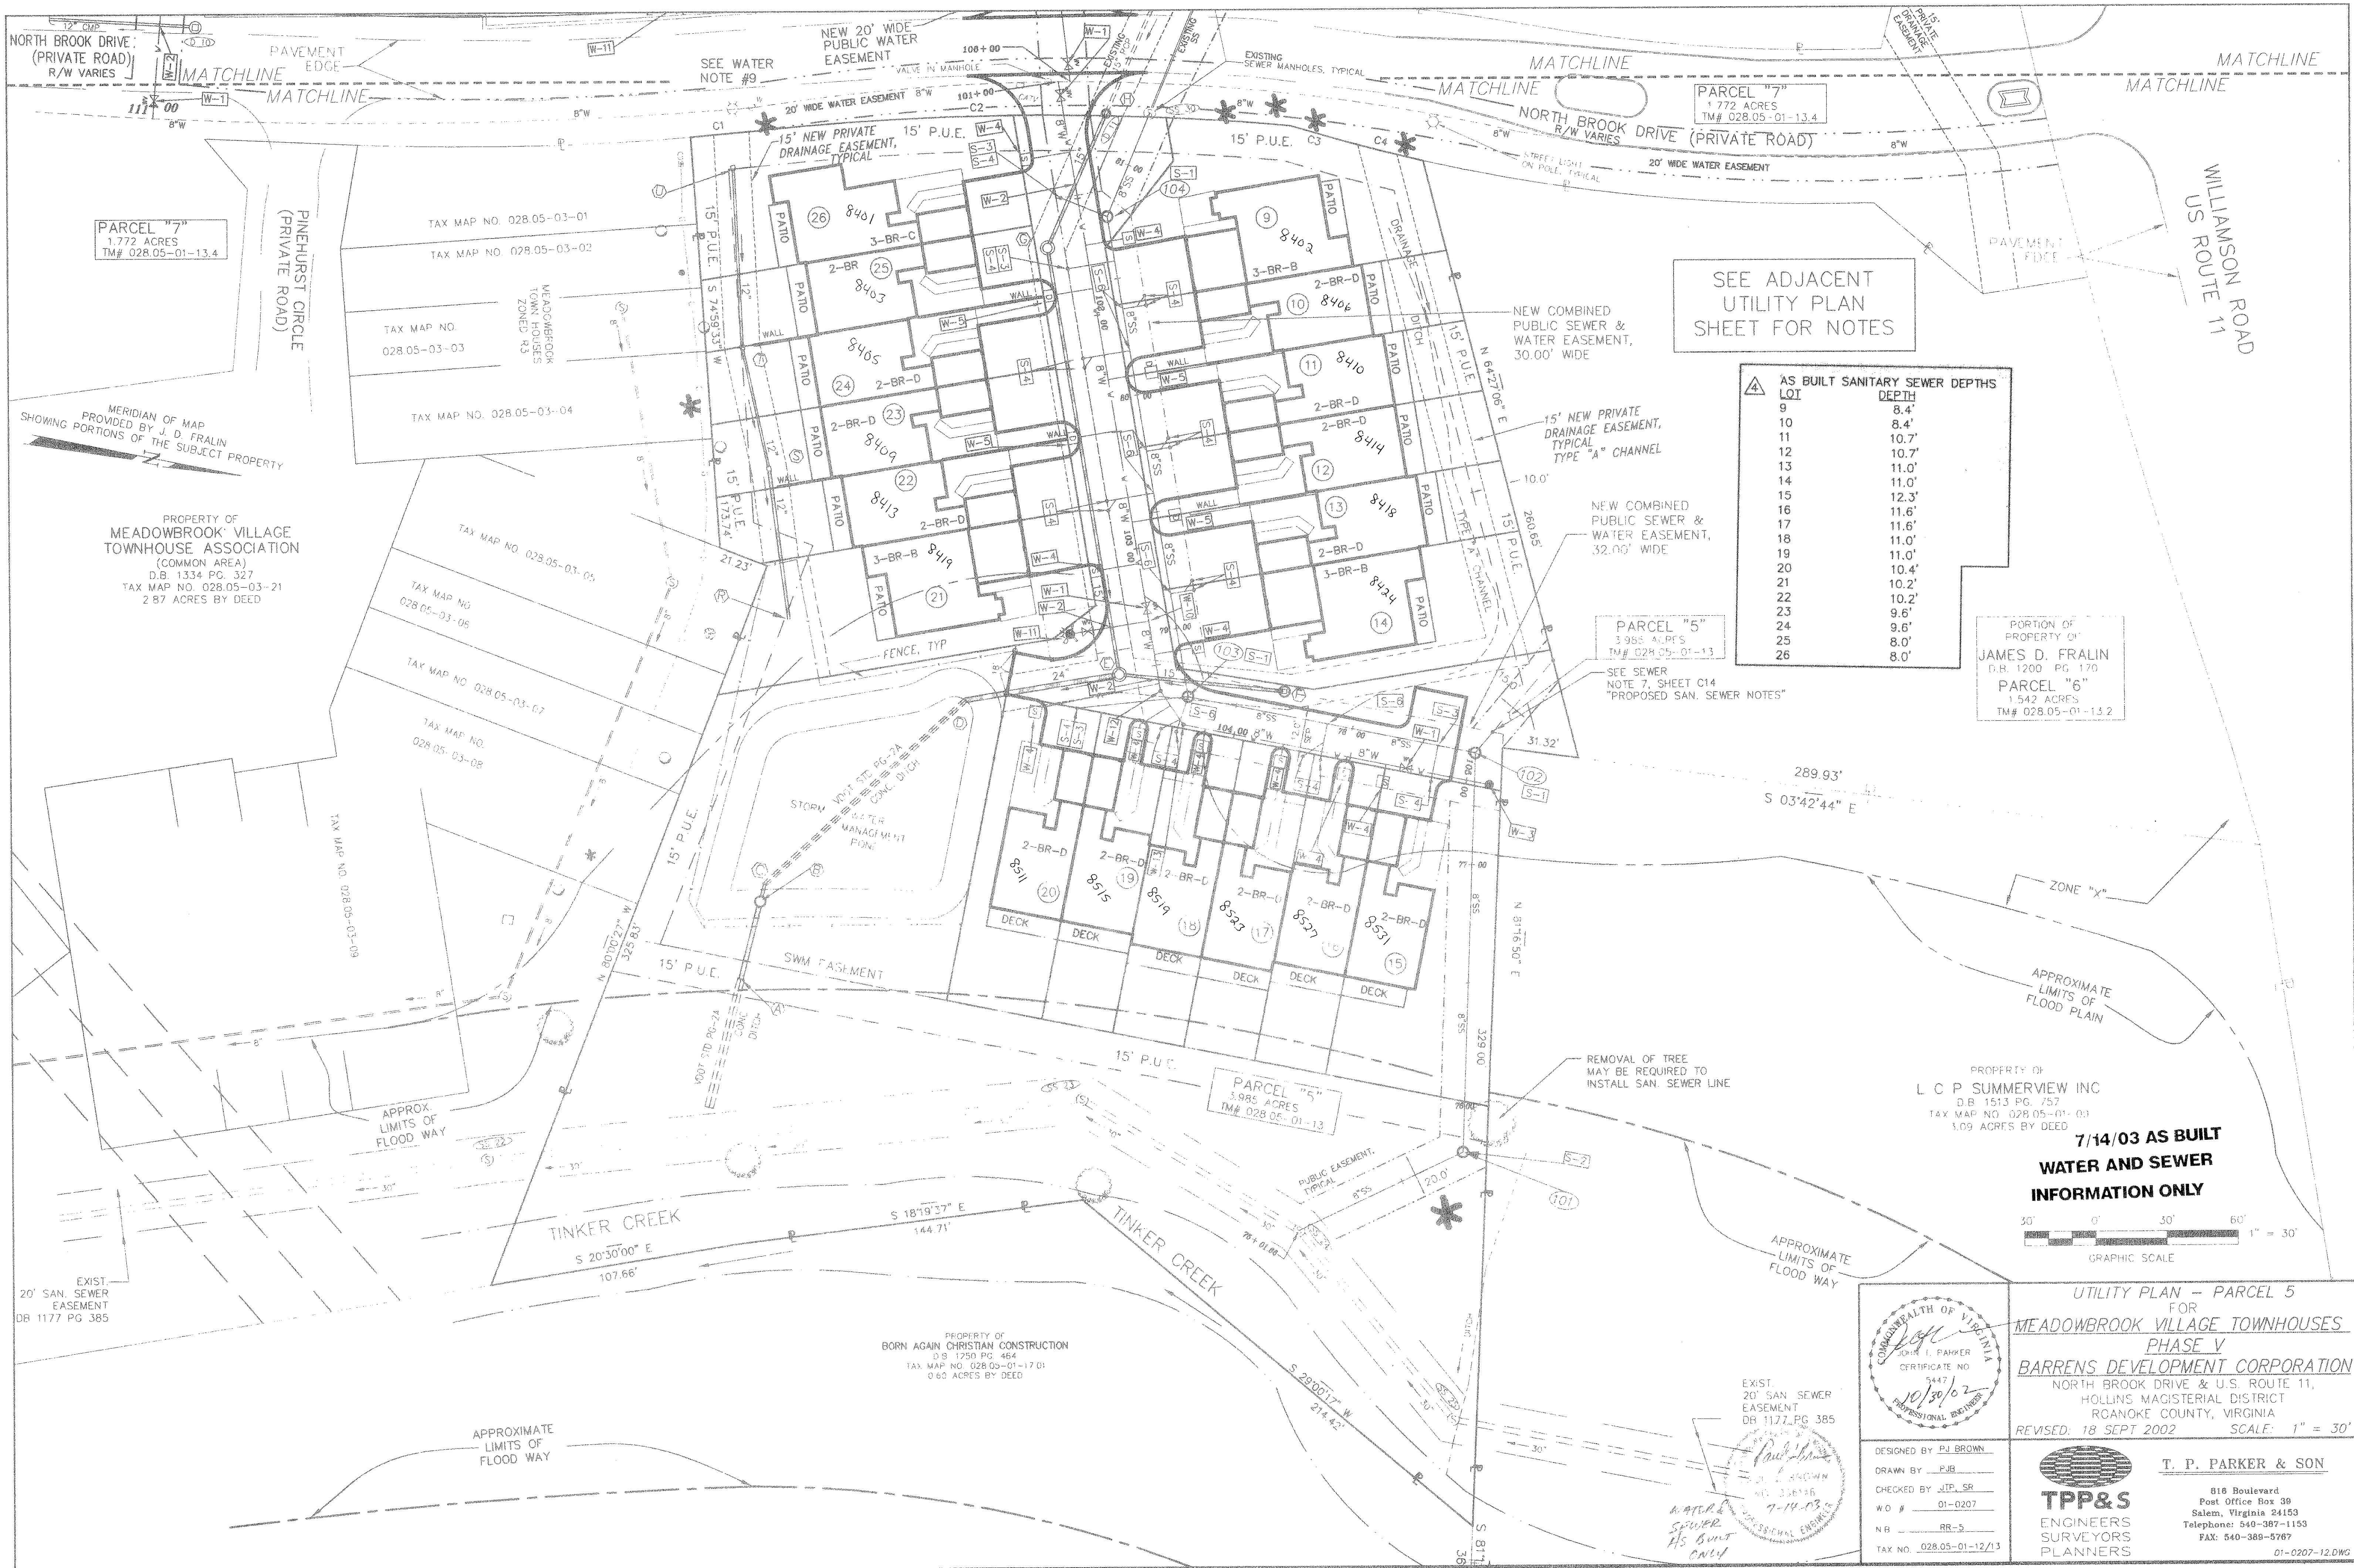


SEE ADJACENT
UTILITY PLAN
SHEET FOR NOTES

AS BUILT SANITARY SEWER DEPTHS	LOT	DEPTH
	9	8.4'
	10	8.4'
	11	10.7'
	12	10.7'
	13	11.0'
	14	11.0'
	15	12.3'
	16	11.6'
	17	11.6'
	18	11.0'
	19	11.0'
	20	10.4'
	21	10.2'
	22	10.2'
	23	9.6'
	24	9.6'
	25	8.0'
	26	8.0'

PORTION OF
PROPERTY OF
JAMES D. FRALIN
D.B. 1200 PG. 170
PARCEL "6"
1.542 ACRES
TM# 028.05-01-13.2

7/14/03 AS BUILT
WATER AND SEWER
INFORMATION ONLY

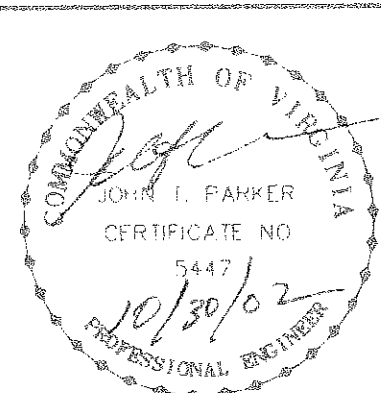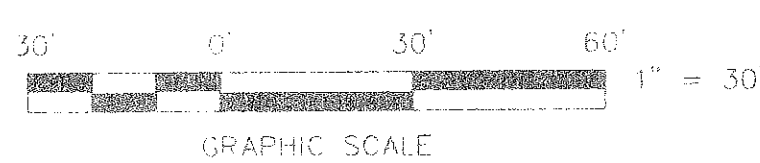

DESIGNED BY: P.J. BROWN
DRAWN BY: PJB
CHECKED BY: JIF, SR.
W.O.#: 01-0207
N.B.: RR-5
TAX NO.: 028.05-01-12/13

UTILITY PLAN - PARCEL 5
FOR
MEADOWBROOK VILLAGE TOWNHOUSES
PHASE V
BARRENS DEVELOPMENT CORPORATION
NORTH BROOK DRIVE & U.S. ROUTE 11,
HOLLINS MAGISTERIAL DISTRICT
ROANOKE COUNTY, VIRGINIA
REVISED: 18 SEPT 2002 SCALE: 1" = 30'

T. P. PARKER & SON
818 Boulevard
Post Office Box 39
Salem, Virginia 24153
Telephone: 540-387-1153
FAX: 540-388-5767
01-0207-12.DWG