


5407

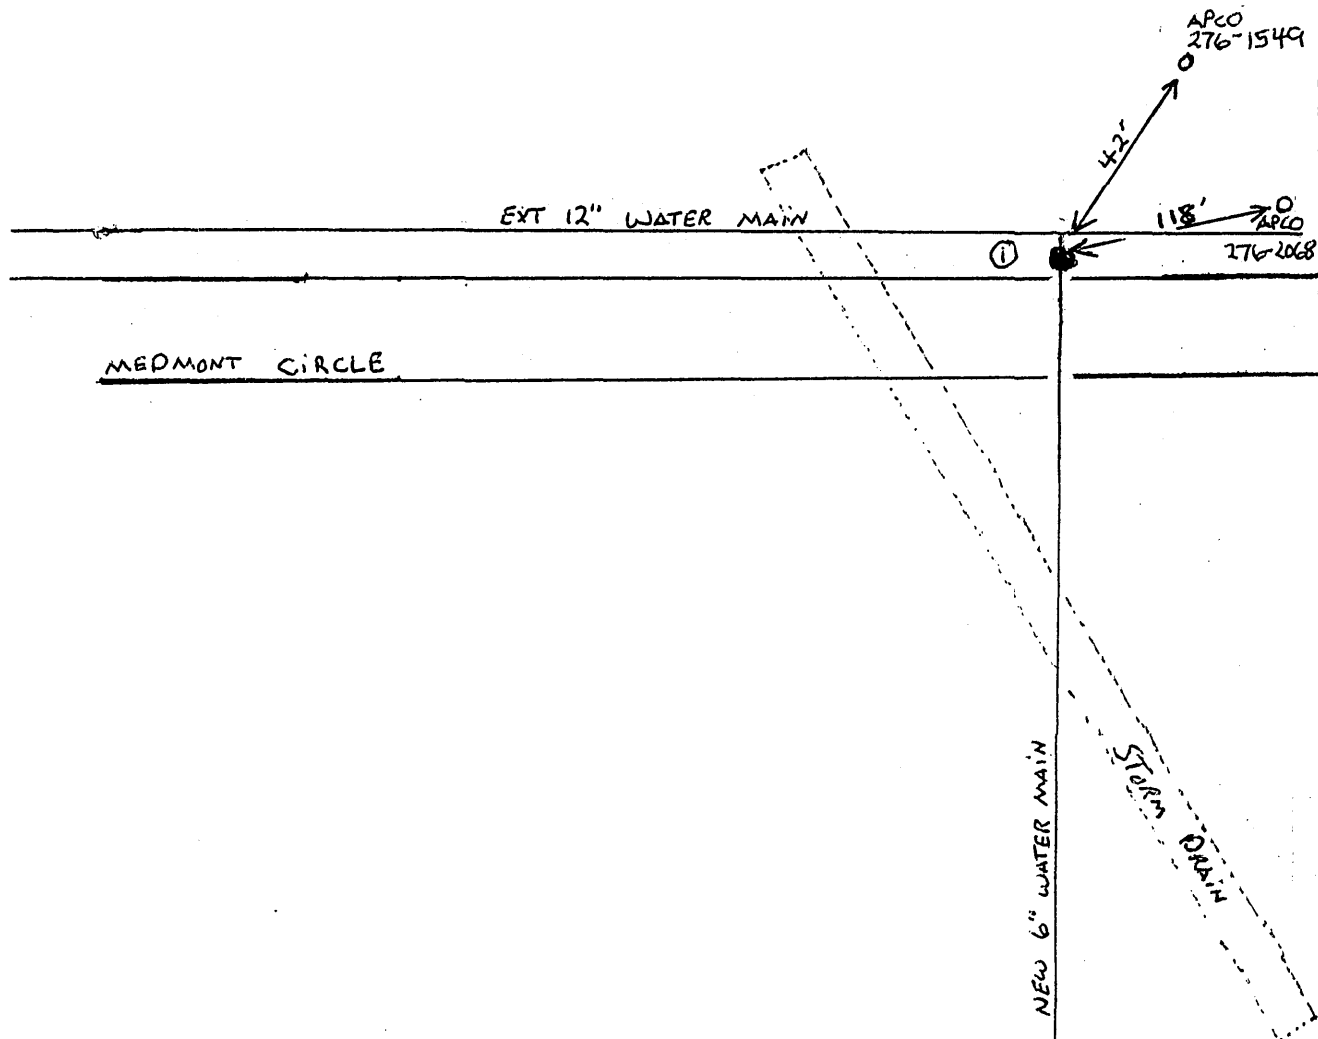

DATE	NO.	SIZE	MAKE	OPEN	TURNS
3-16-99	1	6"	AWWA	R	21

P. L. Measurements

No.	Distance	Direction

To RT. 419 →

CITY OF ROANOKE - WATER DEPT.

VALVE DIAGRAM

5400 BLOCK OF MEDMONT CIRCLE

SW

Sec. Map 513

Date 3-16-99 Page No.

MEDMONT CIRCLE

N