


AS-BUILT SURVEY

## CREATIVE STRUCTURES, INC.

SHOWING WATERLINE AND SANITARY SEWER AS-BUILTS NEW O'REILLY STORE MELROSE AVENUE, N.W.

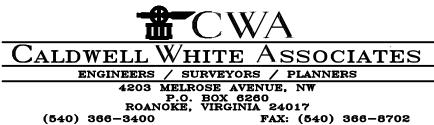

(540) 366-3400

DATE: NOVEMBER 3, 2022

W.O.: 22-0023

SCALE: 1"= 30' N.B.: CH-27



SEE PLANS FOR NEW O'REILLY AUTO PARTS STORE MELROSE AVENUE, N.W. ROANOKE, VIRGINIA #1 BY CRAIG A. SCHNEIDER, AIA DATED FEBRUARY 1, 2019 AND REVISED MARCH 14, 2022.

THIS AS-BUILT SURVEY IS BASED ON FIELD SURVEY OF VISIBLE WATERLINE IMPROVEMENTS AND AS-BUILT SKETCHES FROM CONTRACTOR FOR UNDERGROUND IMPROVEMENTS. THE FIELD SURVEY WAS COMPLETED BY CALDWELL WHITE ASSOCIATES, ON NOVEMBER 2, 2022.

THIS AS—BUILT SURVEY WAS COMPLETED UNDER THE DIRECT AND RESPONSIBLE CHARGE OF, FRANK B. CALDWELL III, L.S. FROM AN ACTUAL GROUND SURVEY MADE UNDER MY SUPERVISION; THE ORIGINAL DATA WAS OBTAINED ON NOVEMBER 2, 2022; AND THIS MAP MEETS MINIMUM ACCURACY STANDARDS UNLESS OTHERWISE NOTED.

