
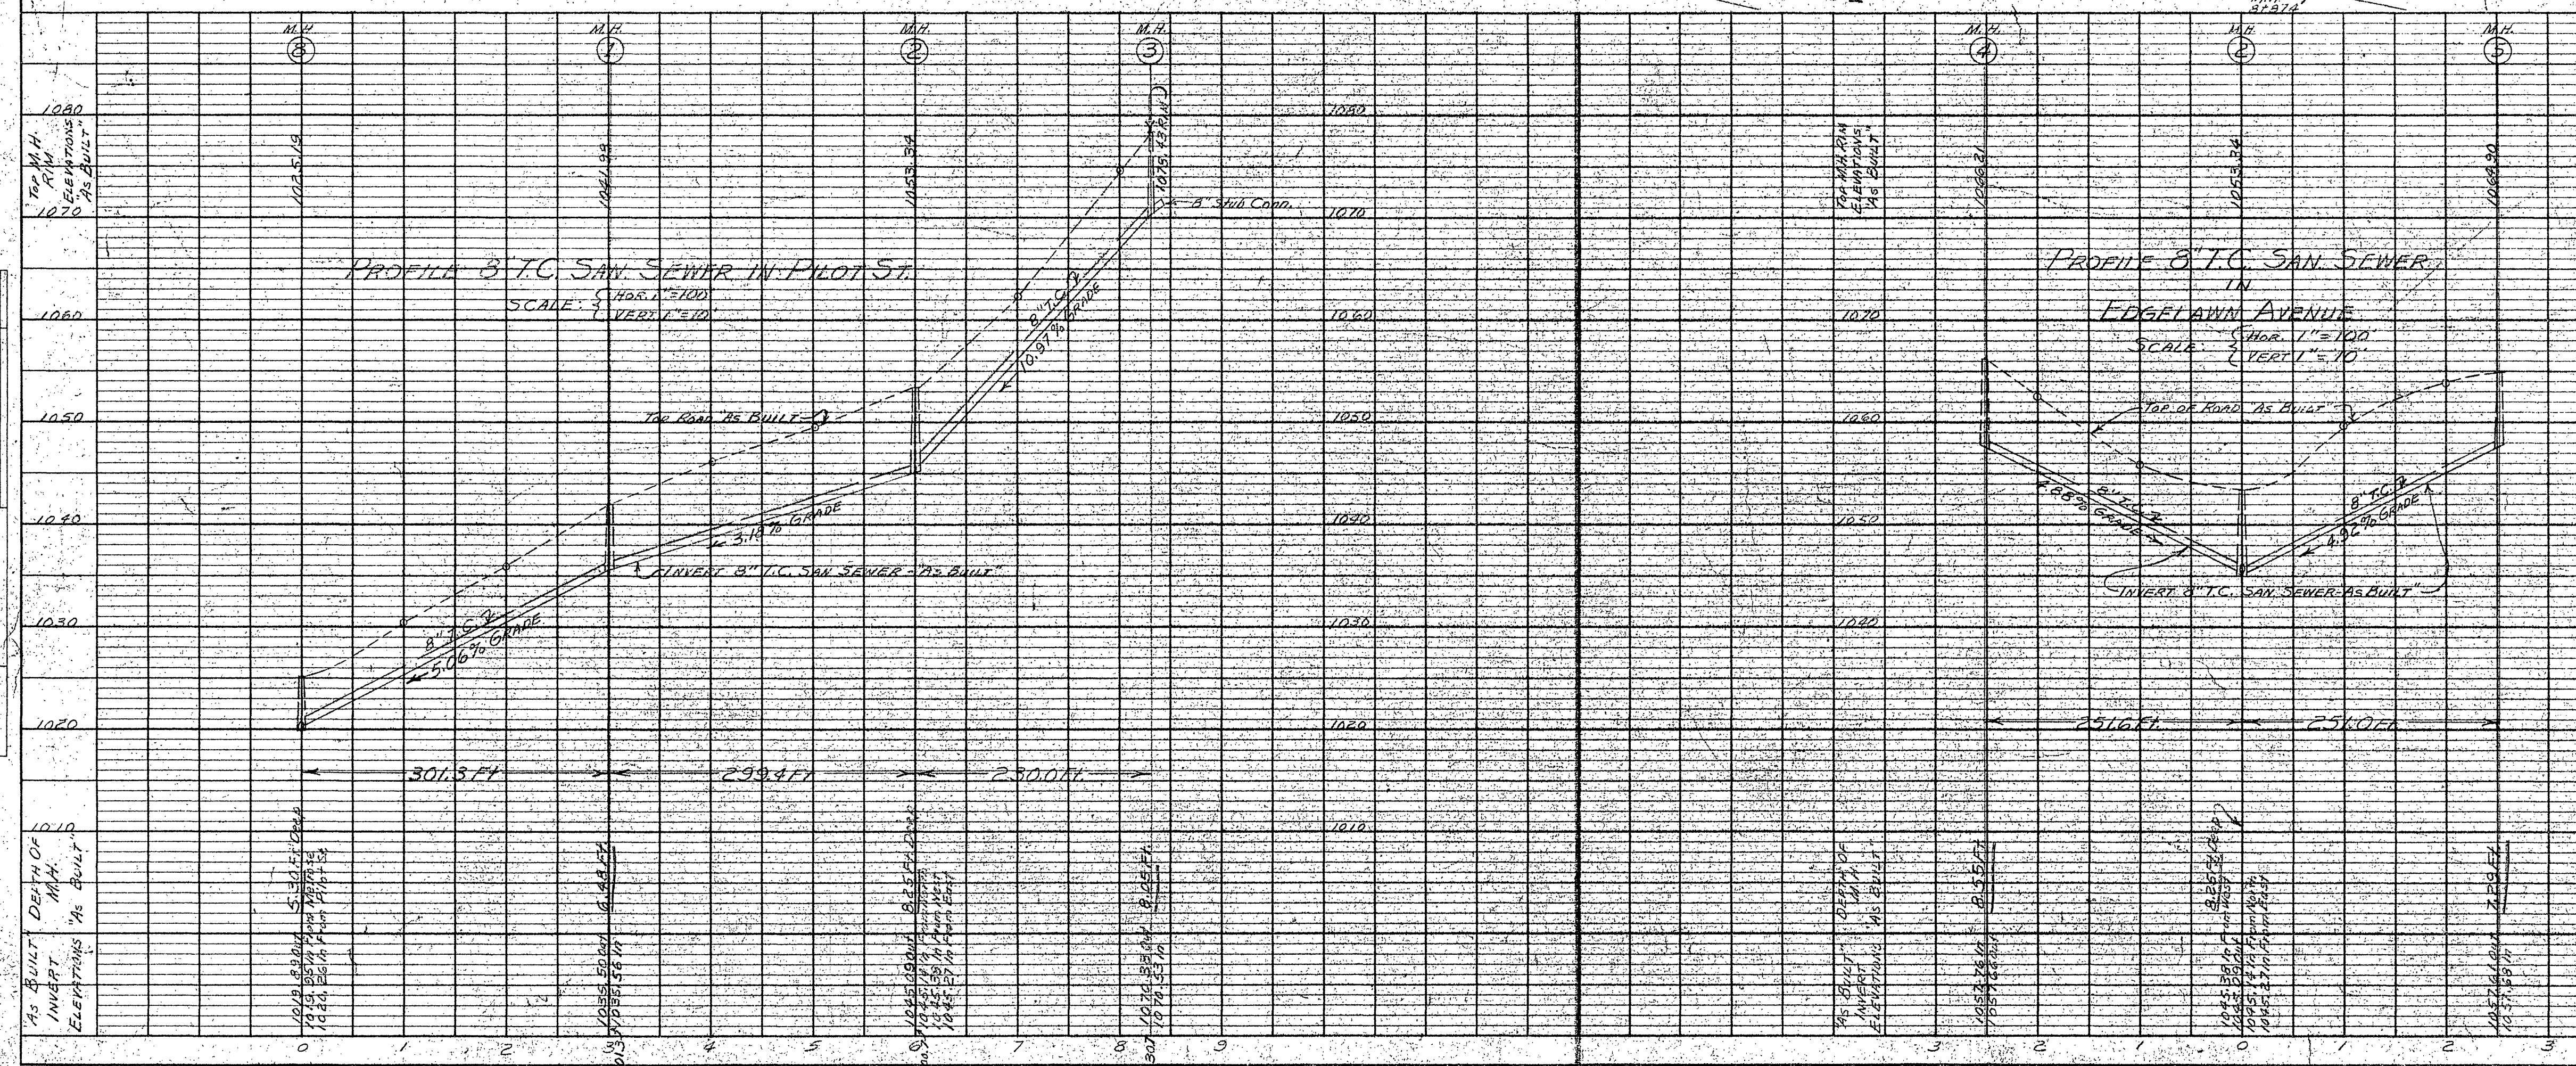
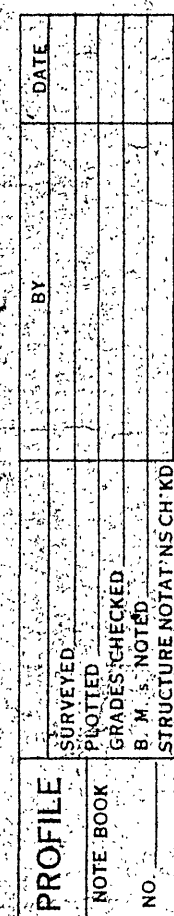
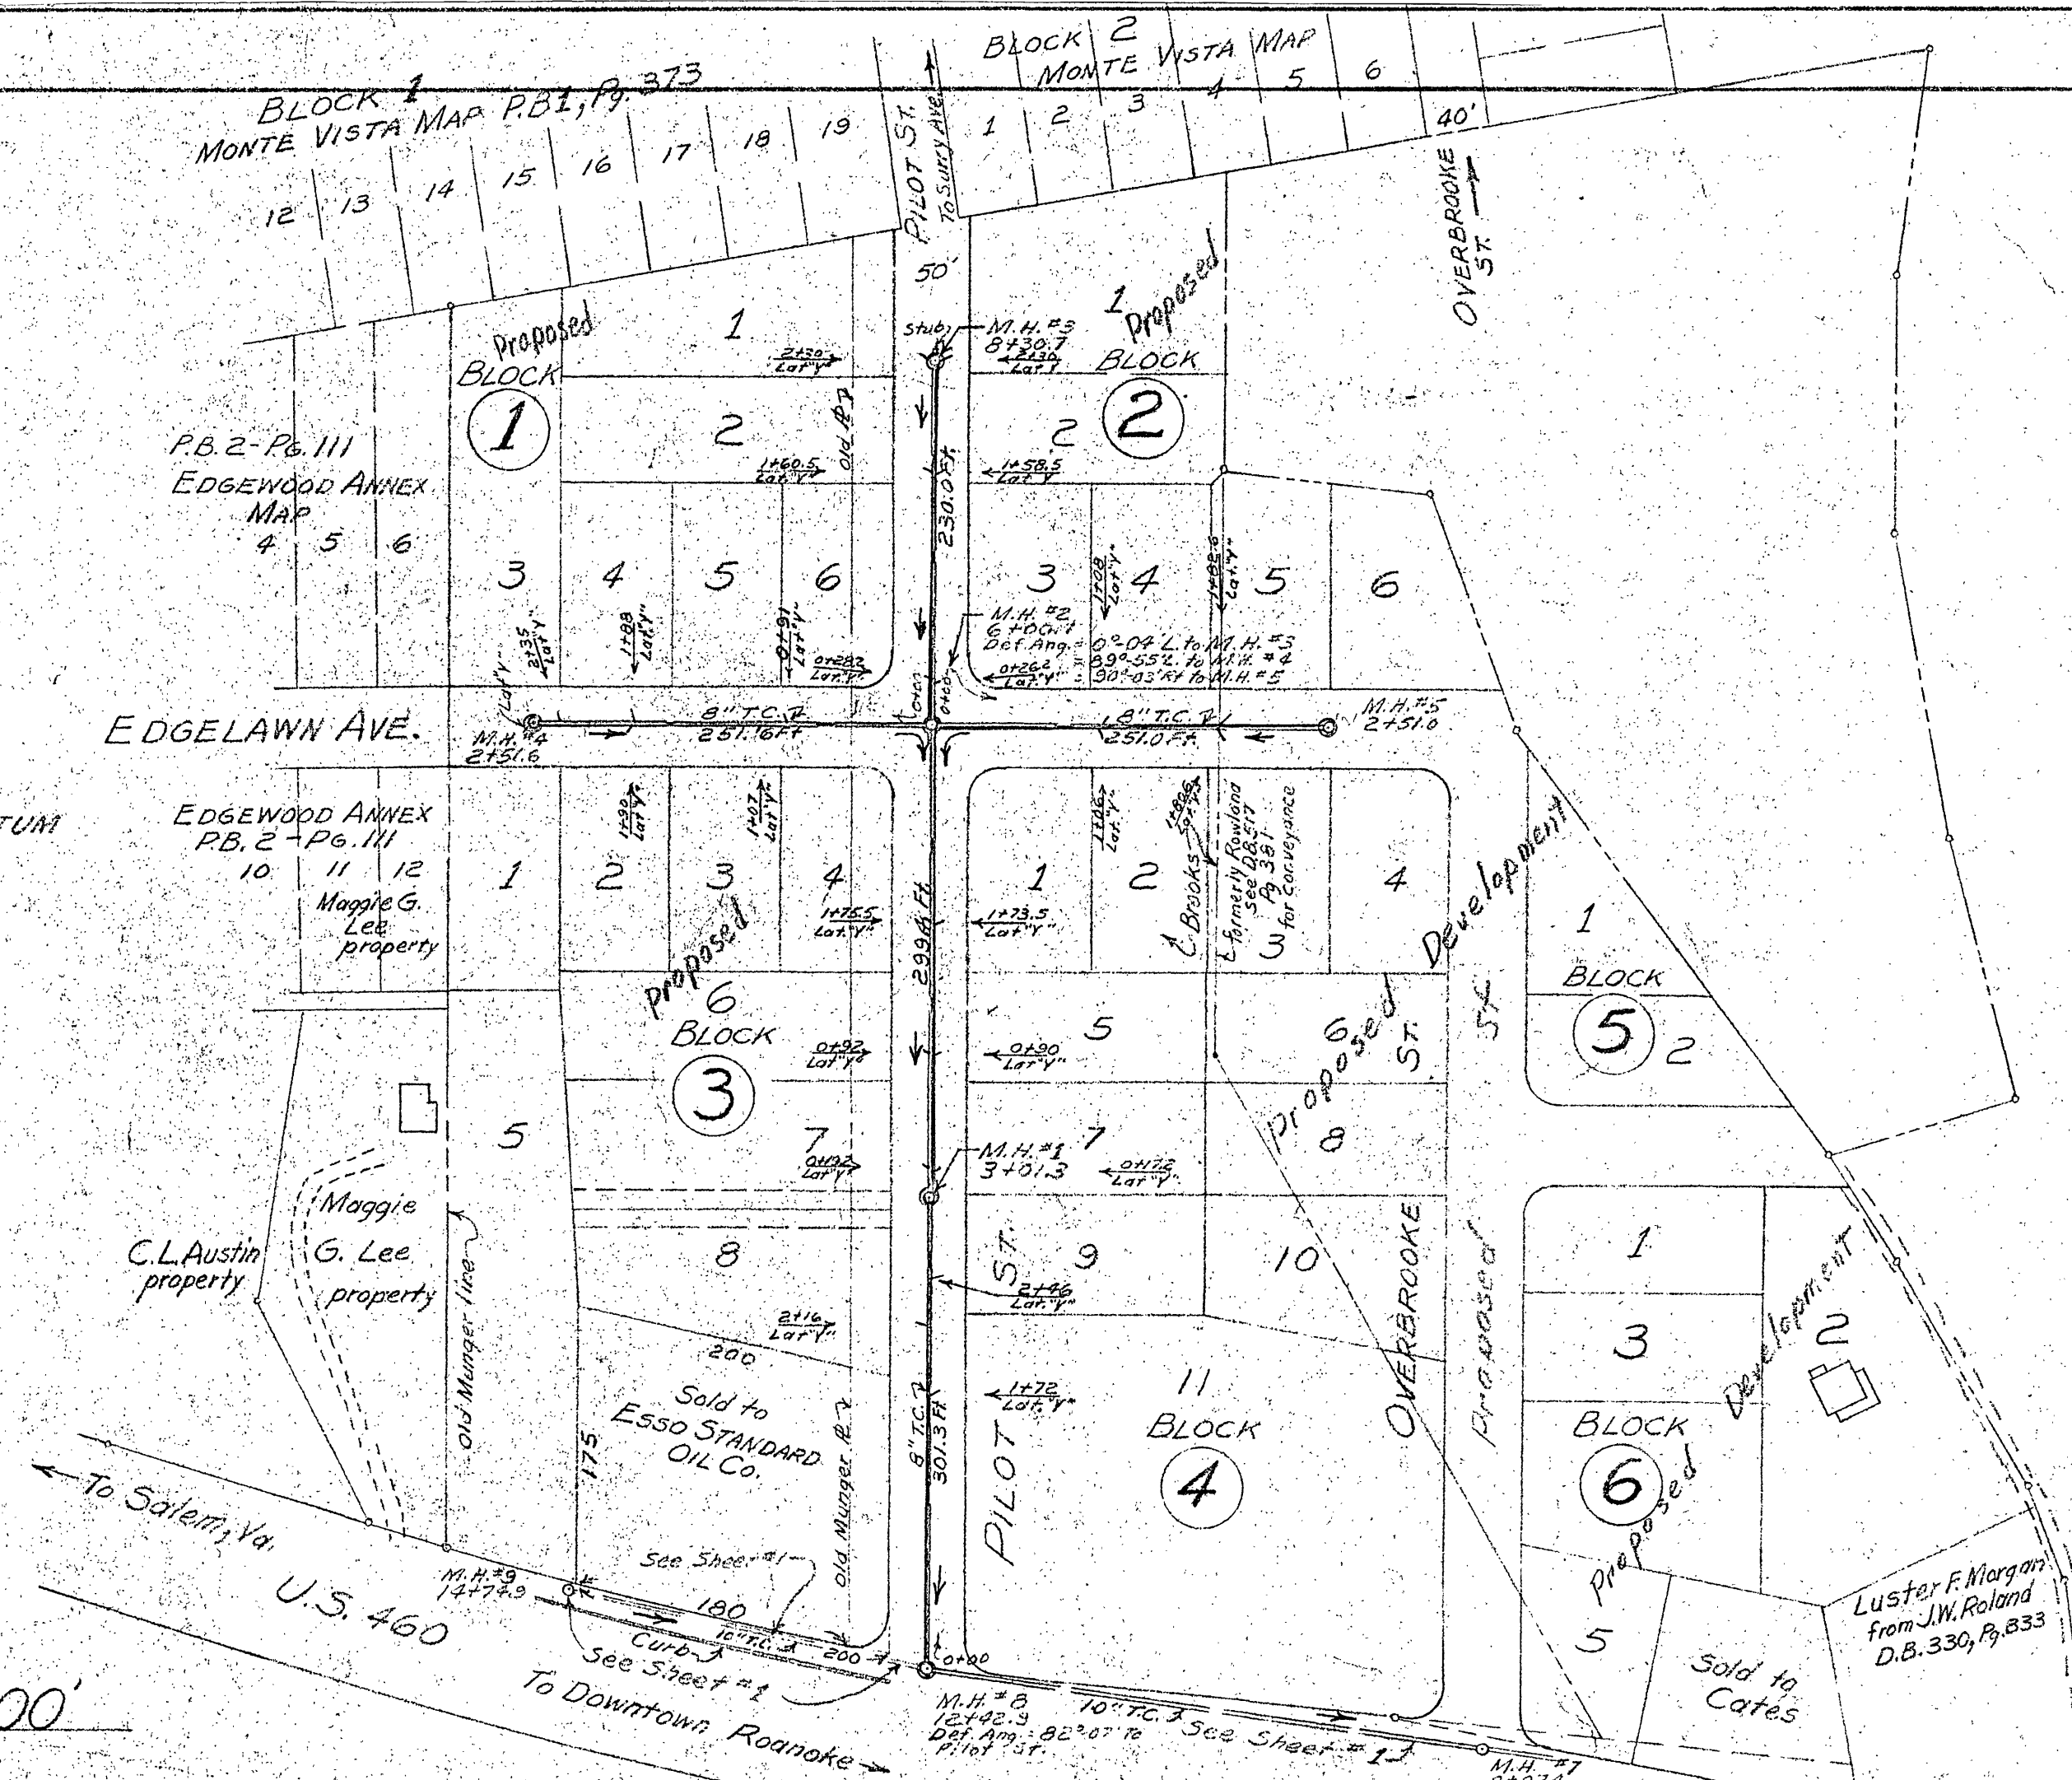


NOTES: For original proposed Plan & Profile
See Sheet 2 of 2 Plan & Profile Made for
R.I. Brooks By C.B. Malcolm - Dated Nov. 14, 1955.
All laterals shown are "Y" Type connections only.
All lateral stations are from last M.H. Back to 1000.

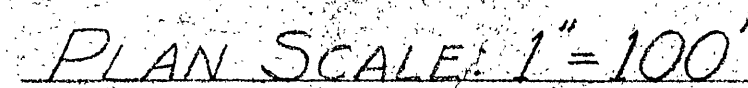

"AS BUILT"
PLAN & PROFILE
OF
8" T.C. SANITARY SEWER
FOR
R. B. BROOKS OF BROOKS & PATTON INC.
ROANOKE COUNTY, VIRGINIA.
BY C. B. MALCOLM & SON
VA. STATE CERT. ENGRS.
DATE APRIL 3, 1956 SCALAS AS NOTED