
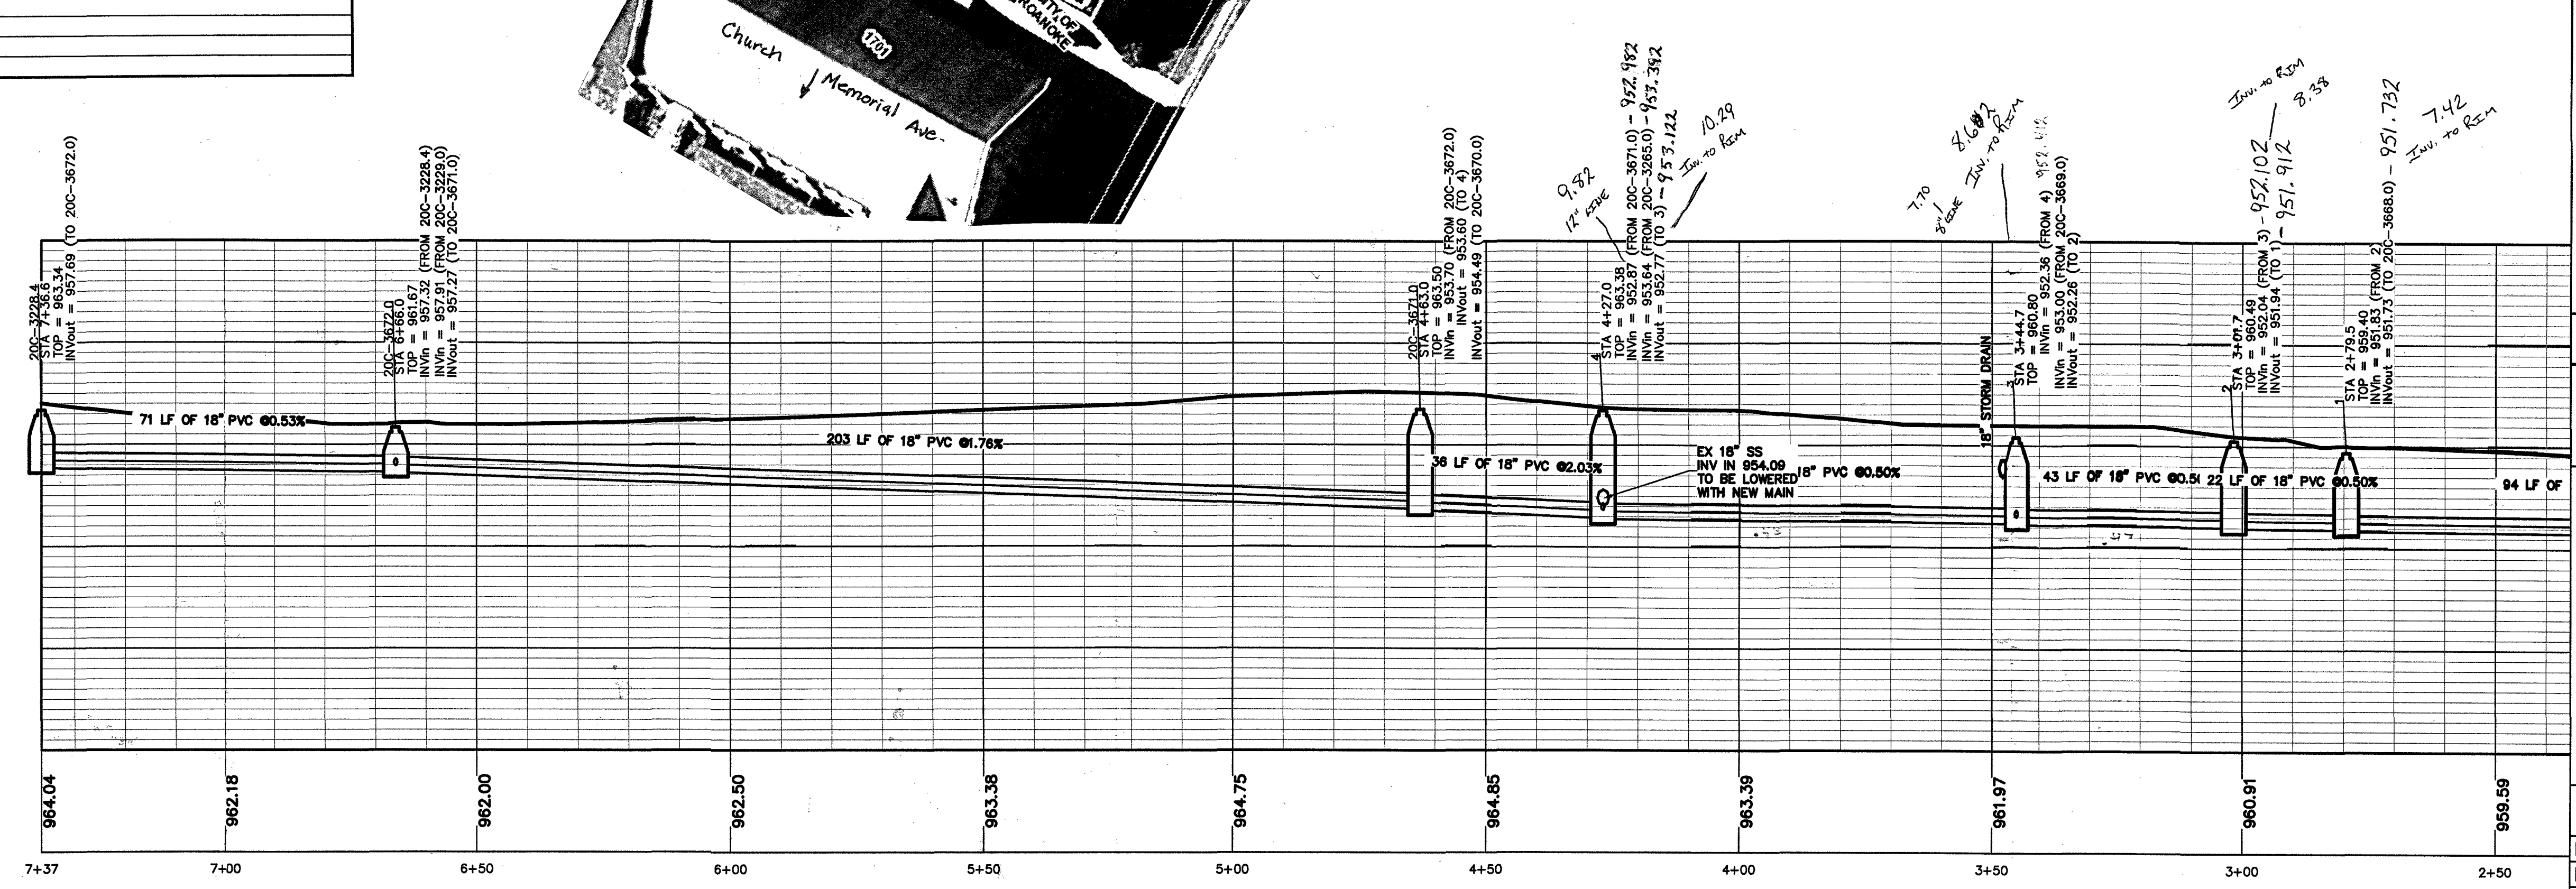


Project Name: Memorial Sewer
Start Date:
Completion Date:
Installer: WVA Field Ops

Manhole	Pipe Type 1	Pipe Type 2	Pipe Type 3	Lateral	Casing Pipe
Manufacturer	CSI	Diamond Plastics	Dura-line	Diamond Plastics	N/A
Material	Re-cast Concrete	PVC	HDPE	PVC	N/A
Class		sdr 26	dr-17	SDR 35	N/A
Diameter	4' DIA M/H	18"	18"	18"	N/A
Lining method & material		N/A	N/A	N/A	
Ring & Cover Manufacturer					
Cover Type	STANDARD				
Wall Thickness					N/A

Notes: All new pipes installed are pipe type 1 unless noted otherwise on As-builts

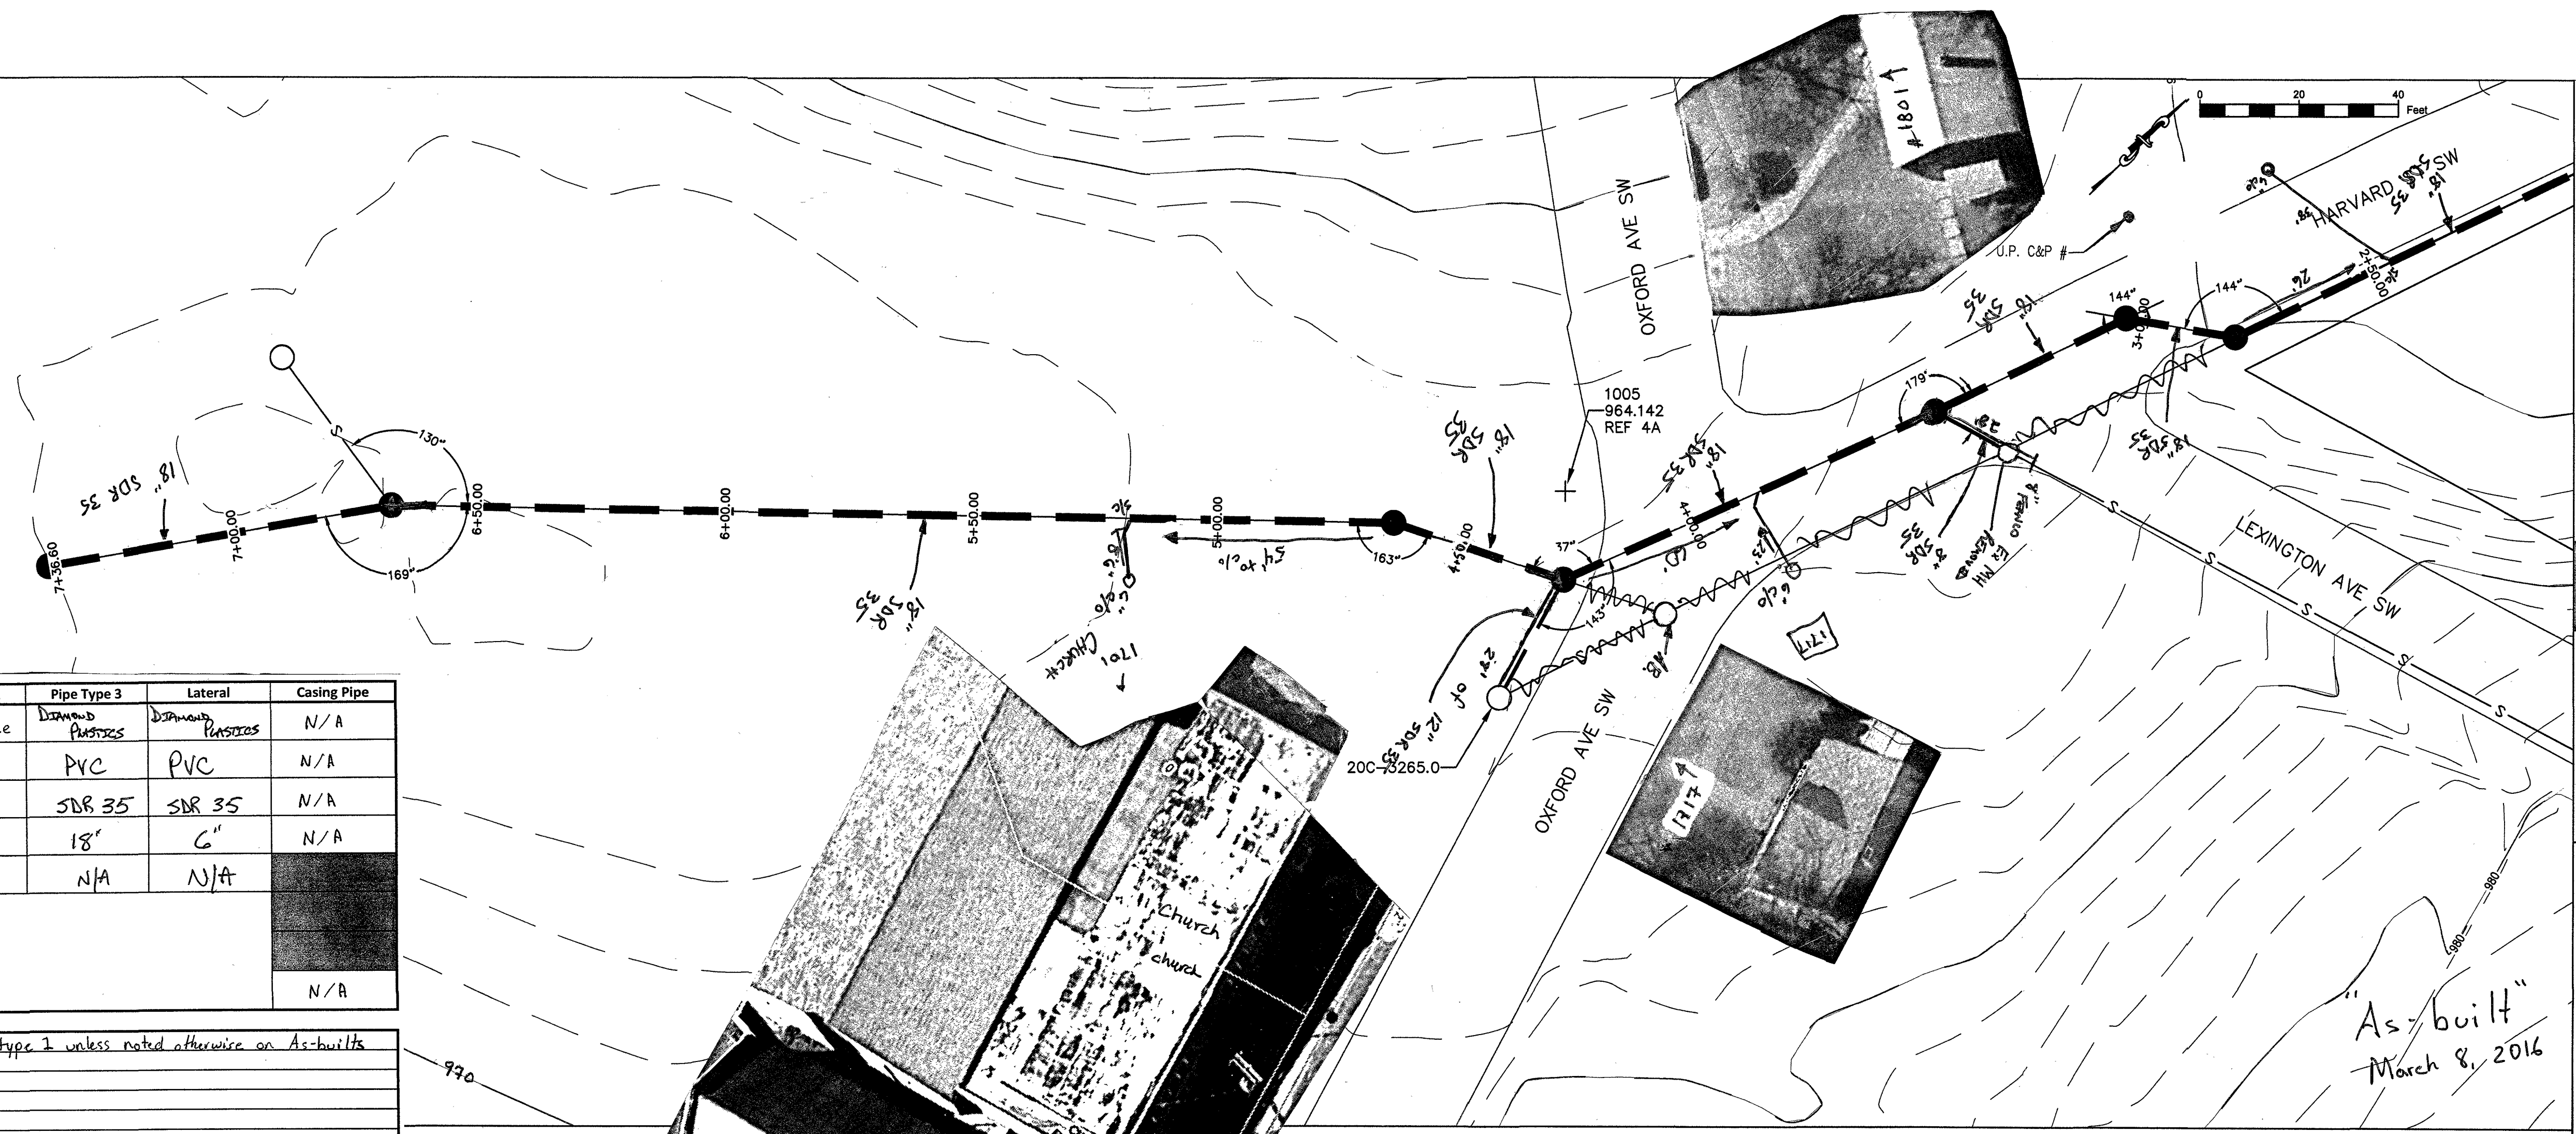

HARVARD SEWER
SCALE
VERTICAL: 1" = 10'
HORIZONTAL: 1" = 20'

WESTERN VIRGINIA
WATER AUTHORITY

ENGINEERING SERVICES
601 S JEFFERSON ST, SUITE 300
ROANOKE, VA 24011
540-853-5641 or 540-853-5770

MEMORIAL SEWER

PLAN & PROFILE

Rev	Description	Date	By
1	NEW ALIGN PER JACK/TAFT	11-5-15	

Designed: AAS
Drawn: DRJ
Checked:
Approved:
Date: 2-20-15
Project:

1
Sheet 1 of 3