


DEPARTMENT OF UTILITIES  
SUITE 200  
2012 S. JEFFERSON STREET  
ROANOKE, VIRGINIA 24014

## INDEX OF SHEETS

- 1 COVER SHEET
- 2 NOT USED
- 3 ABBREVIATIONS AND LEGEND
- 4 SHEET INDEX AND GENERAL NOTES
- 5 PLAN AND PROFILE- 8" WATERLINE
- 6 PLAN AND PROFILE- 8" WATERLINE
- 7 PLAN AND PROFILE- 8" WATERLINE
- 8 PLAN AND PROFILE- 8" WATERLINE
- 9 PLAN AND PROFILE- 8" WATERLINE
- 10 PLAN AND PROFILE- 8" WATERLINE
- 11 PUMP STATION- SITE PLAN
- 12 PUMP STATION- FLOOR PLAN
- 13 PUMP STATION- ELEVATIONS
- 14 PUMP STATION- SECTIONS AND DETAILS
- 15 PUMP STATION- STRUCTURAL DETAILS
- 16 PUMP STATION- ELECTRICAL FLOOR PLAN
- 17 PUMP STATION- ELECTRICAL SCHEDULES & RISER
- 18 PUMP STATION- MECHANICAL
- 19 WATER TANK- SITE PLAN
- 20 WATER TANK- WELDED STEEL
- 21 WATER TANK- BOLTED STEEL
- 22 WATER TANK- DETAILS


## CONSULTING ENGINEERS

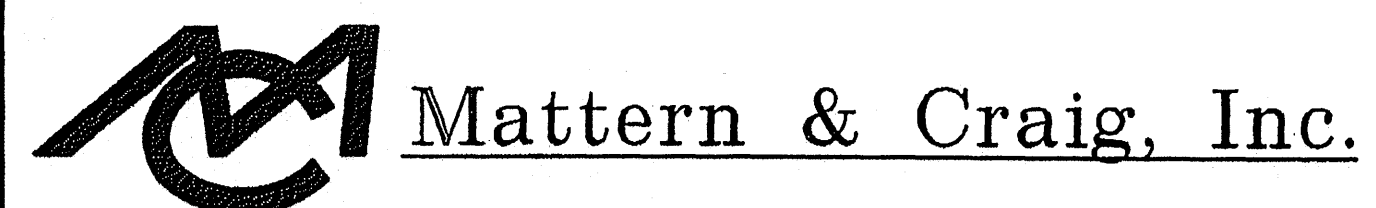

CONSULTING ENGINEERS  
SURVEYORS

701 FIRST STREET, S.W.  
ROANOKE, VIRGINIA 24016  
(540) 345-9342  
(540) 345-7691 FAX

COMMISSION NUMBER: 2120

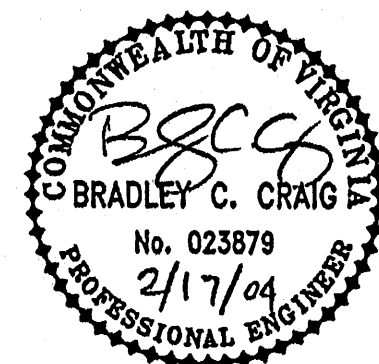

## PROJECT NAME

MILL MOUNTAIN  
WATER PROJECT  
CITY OF ROANOKE, VIRGINIA

PROJECT NUMBER: 6540

## APPROVED FOR CONSTRUCTION

*[Signature]*  
ROANOKE CITY UTILITIES ENGINEER

2-17-04  
DATE

*[Signature]*  
ROANOKE CITY ENGINEER

2-17-04  
DATE

*[Signature]*  
DIRECTOR OF PUBLIC WORKS

02-17-04  
DATE

*[Signature]*  
ASSISTANT CITY MANAGER FOR OPERATIONS

2/17/04  
DATE

DATE

ADVERTISED DATE: \_\_\_\_\_

SET NUMBER: 1

SHEET NUMBER: 1 OF 22

RECORD DRAWING

REVISION BY	DESCRIPTION:	DATE
REVISION BY	DESCRIPTION:	DATE
REVISION BY	DESCRIPTION:	DATE
REVISION BY	DESCRIPTION:	DATE