




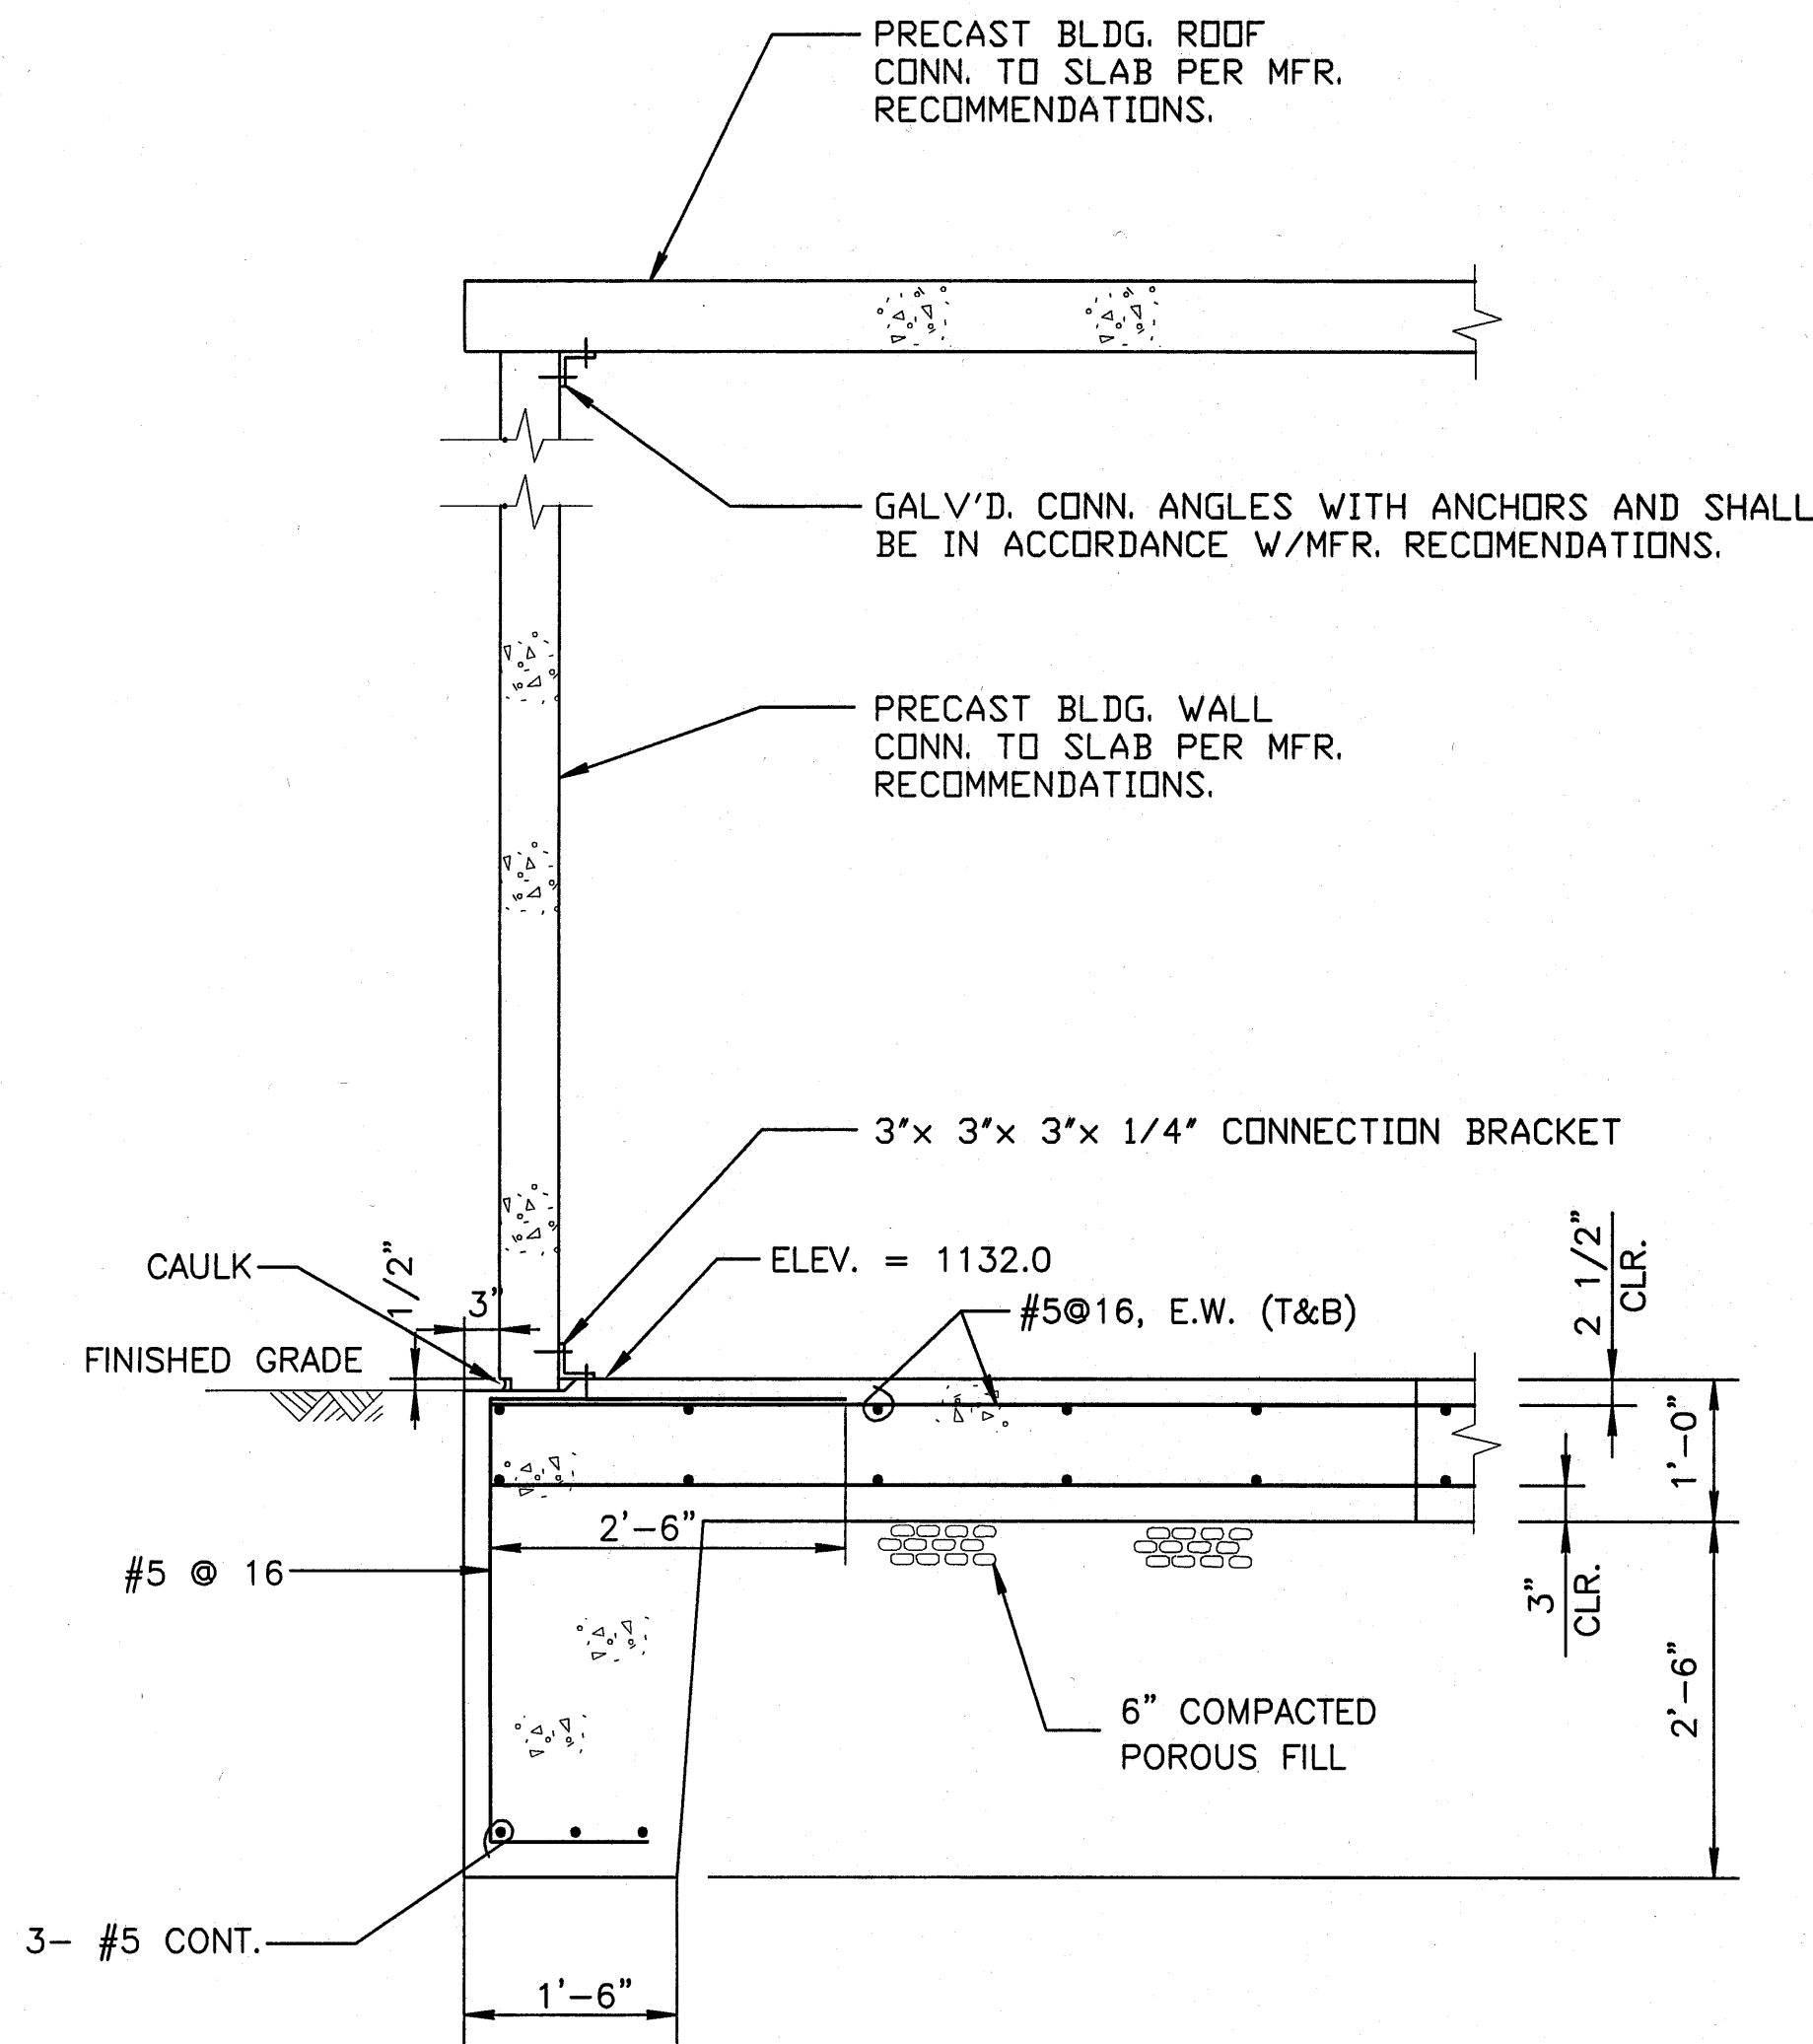


SECTION
SCALE: 3/4" = 1'-0"

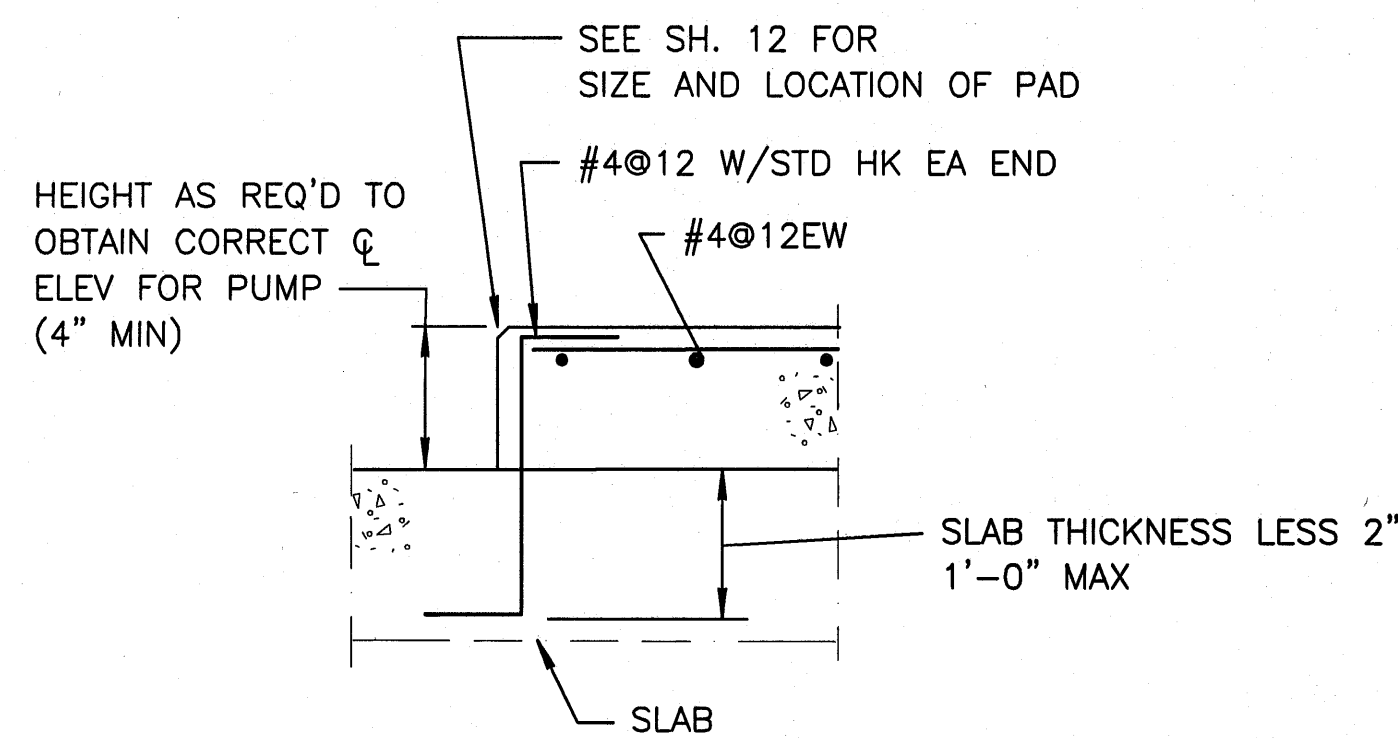

TYPICAL EQUIPMENT PAD
NOT TO SCALE

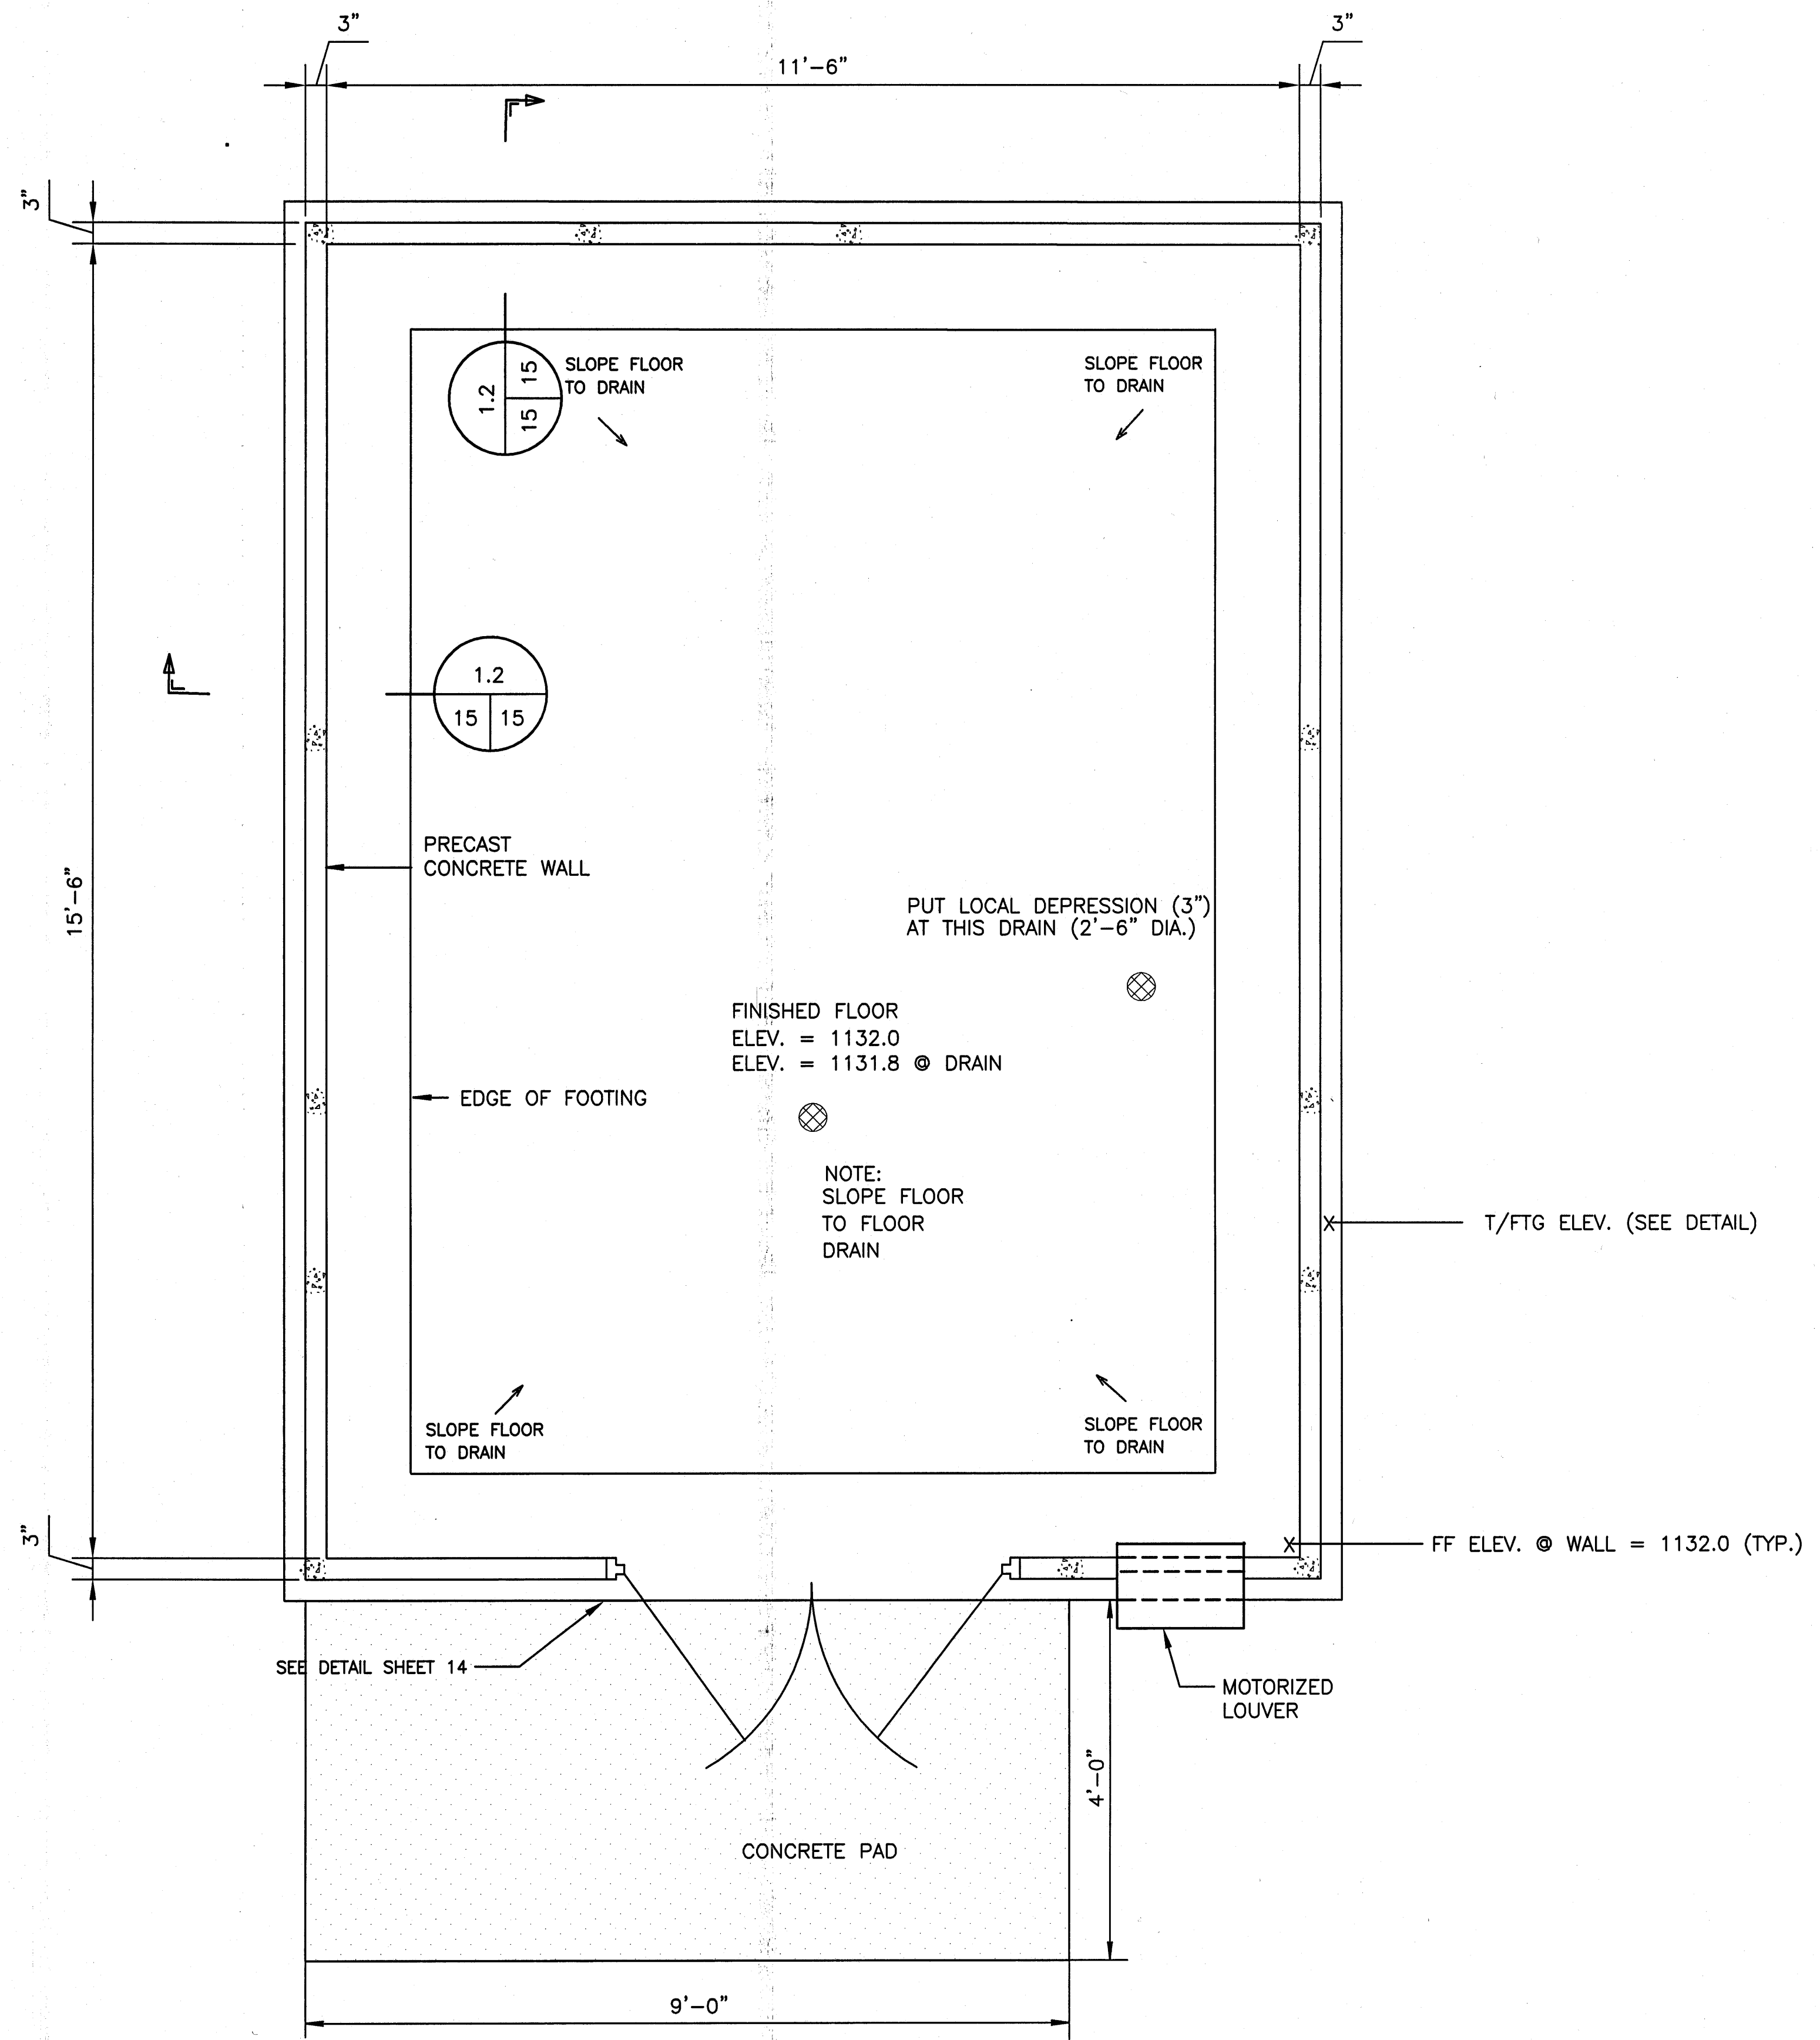

FOOTING AND WALL PLAN
SCALE: 3/4" = 1'-0"

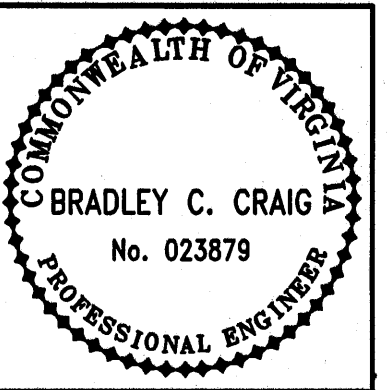

Date	
Revisions	

Issue Date:	02/17/04
Drawn By:	ARB
Designed By:	BCC
Checked By:	BCC
Date:	02/17/04

Mattem & Craig
CONSULTING ENGINEERS • SURVEYORS
701 FIRST STREET, S.W.
ROANOKE, VIRGINIA 24016
(540) 345-3602
FAX (540) 345-7691

MILL MOUNTAIN WATER PROJECT
**PUMP STATION -
STRUCTURAL DETAILS**
CITY OF ROANOKE, VIRGINIA

Vertical Scale:
N/A

Horizontal Scale:
AS NOTED

Commission Number:
2120

Sheet No.:

15

RECORD DRAWINGS