MON./ROANOKE CITY ALUM. DISC

SURVEY CONTROL MAP SCALE : 1"=50'


- 1. CLEAR AND GRUB TREES AND VEGETATION WITHIN PROPERTY LINE ONLY AS REQUIRED FOR CONSTRUCTION. CONSULT WITH CITY PRIOR TO CUTTING DOWN ANY TREES 12" IN DIAMETER OR LARGER DISPOSE OF MATERIAL OFF THE PROJECT SITE.
- 2. CONTRACTOR SHALL ADJUST CONTOURS OF FILL AREA TO ALLOW DISPOSAL OF ALL EXCAVATED TANK SITE MATERIAL ON THE TANK PROPERTY.
- 3. TANK IS 84,000 GALLONS WITH OVERFLOW @ 1776.50, HEIGHT IS 38'-0" AND DIAMETER IS 20'-0". TOP RINGWALL EL. IS 1739.50.
- 4. VALVE VAULT FOR 4" VALVE SHALL BE A STANDARD PRECAST CONCRETE MANHOLE CONE SECTION WITH 24" DIAMETER FRAME AND COVER AND GRAVEL BOTTOM. TANK CONTRACTOR SHALL PROVIDE 3/4" CORPORATION STOP ON TANK SIDE OF 4' VALVE. PRESSURE TRANSDUCER SHALL BE MOUNTED BY PIPELINE CONTRACTOR ON CORPORATION STOP ON TANK SIDE OF 4" VALVE.
- 5. AFTER CONSTRUCTION OF NEW TANK, EXISTING WATER TANKS SHALL BE DEMOLISHED AND DISPOSED OF BY THE CONTRACTOR AT HIS EXPENSE. TANK FOUNDATIONS MAY BE LEFT IN PLACE. HOWEVER, WATERLINES TO THE TANKS SHALL BE ADEQUATELY PLUGGED/CAPPED. VALVE BOXES ON ABANDONED. WATERLINES SHALL BE REMOVED.

3618501.7210

COORDINATE LIST

CP#	NORTH	EAST	DESC	
1002	3618276.1968	11066982.2843	CENTER OF TANK	
	SURVEY	CONTROL POINTS		
CP#	NORTH	EAST	DESC	
1	3618337.3553	11066862.7444	PI IRON ROD CONTRO	

11067182.3700

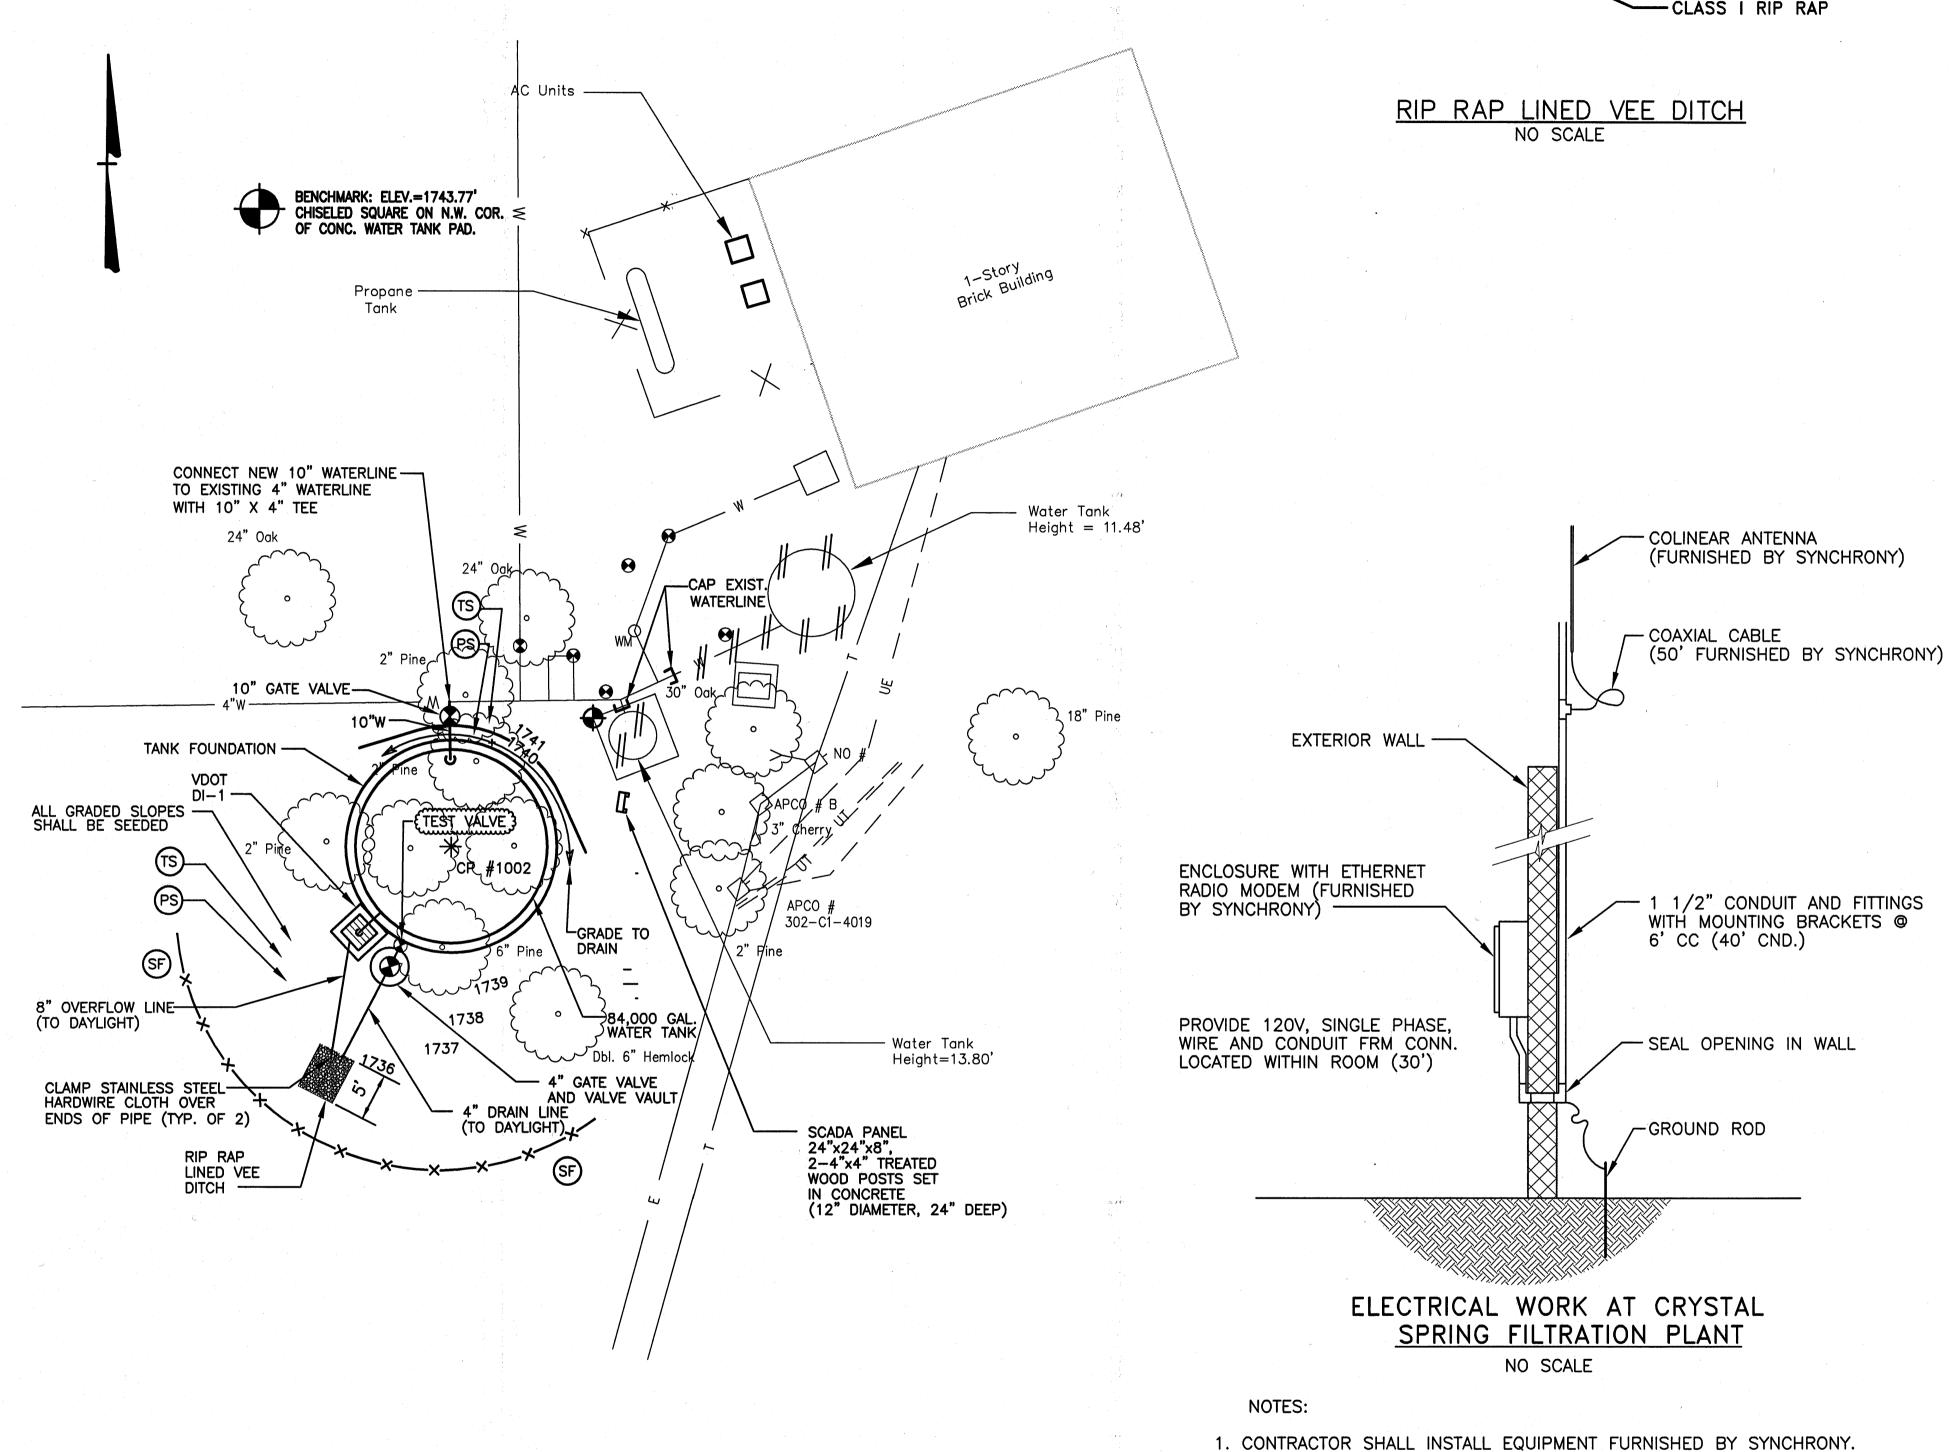

-FILTER FABRIC CLASS I RIP RAP

RIP RAP LINED VEE DITCH

BRADLEY C. CRAIG

No. 023879

8

Vertical Scale: N/A

Horizontal Scale: 1"= 10'

2120

Sheet No.:

SCALE IN FEET

RECORD DRAWINGS

2. INSTALLATION SIMILAR AT NEW PUMP STATION- PROVIDE 20' MAST CONDUIT.

3. INSTALL ANTENNA ON TANK HANDRAIL AT TANK. PROVIDE CONDUIT FROM SCADA PANEL TO TOP OF TANK.