



GENERAL NOTES

- 1. TANK DATA:
84,000 GAL. WATER TANK
OVERFLOW ELEV. 1776.50
RINGWALL ELEV. 1739.50
DIA. 20'
HEIGHT TO OVERFLOW 37'
1 VF = 2,270 GALLONS
- 2. LADDER AND TANK LEVEL GAUGE SHALL BE POSITIONED ON THE TANK FACING THE ACCESS ROAD.
- 3. TANK LEVEL PROBES SHALL BE LOCATED NEXT TO THE TANK LADDER FOR MAINTENANCE PURPOSES.
- 4. TANK INTERIOR PIPING SHALL BE LOCATED NEAR THE TANK LADDER AND ACCESS MANHOLE.

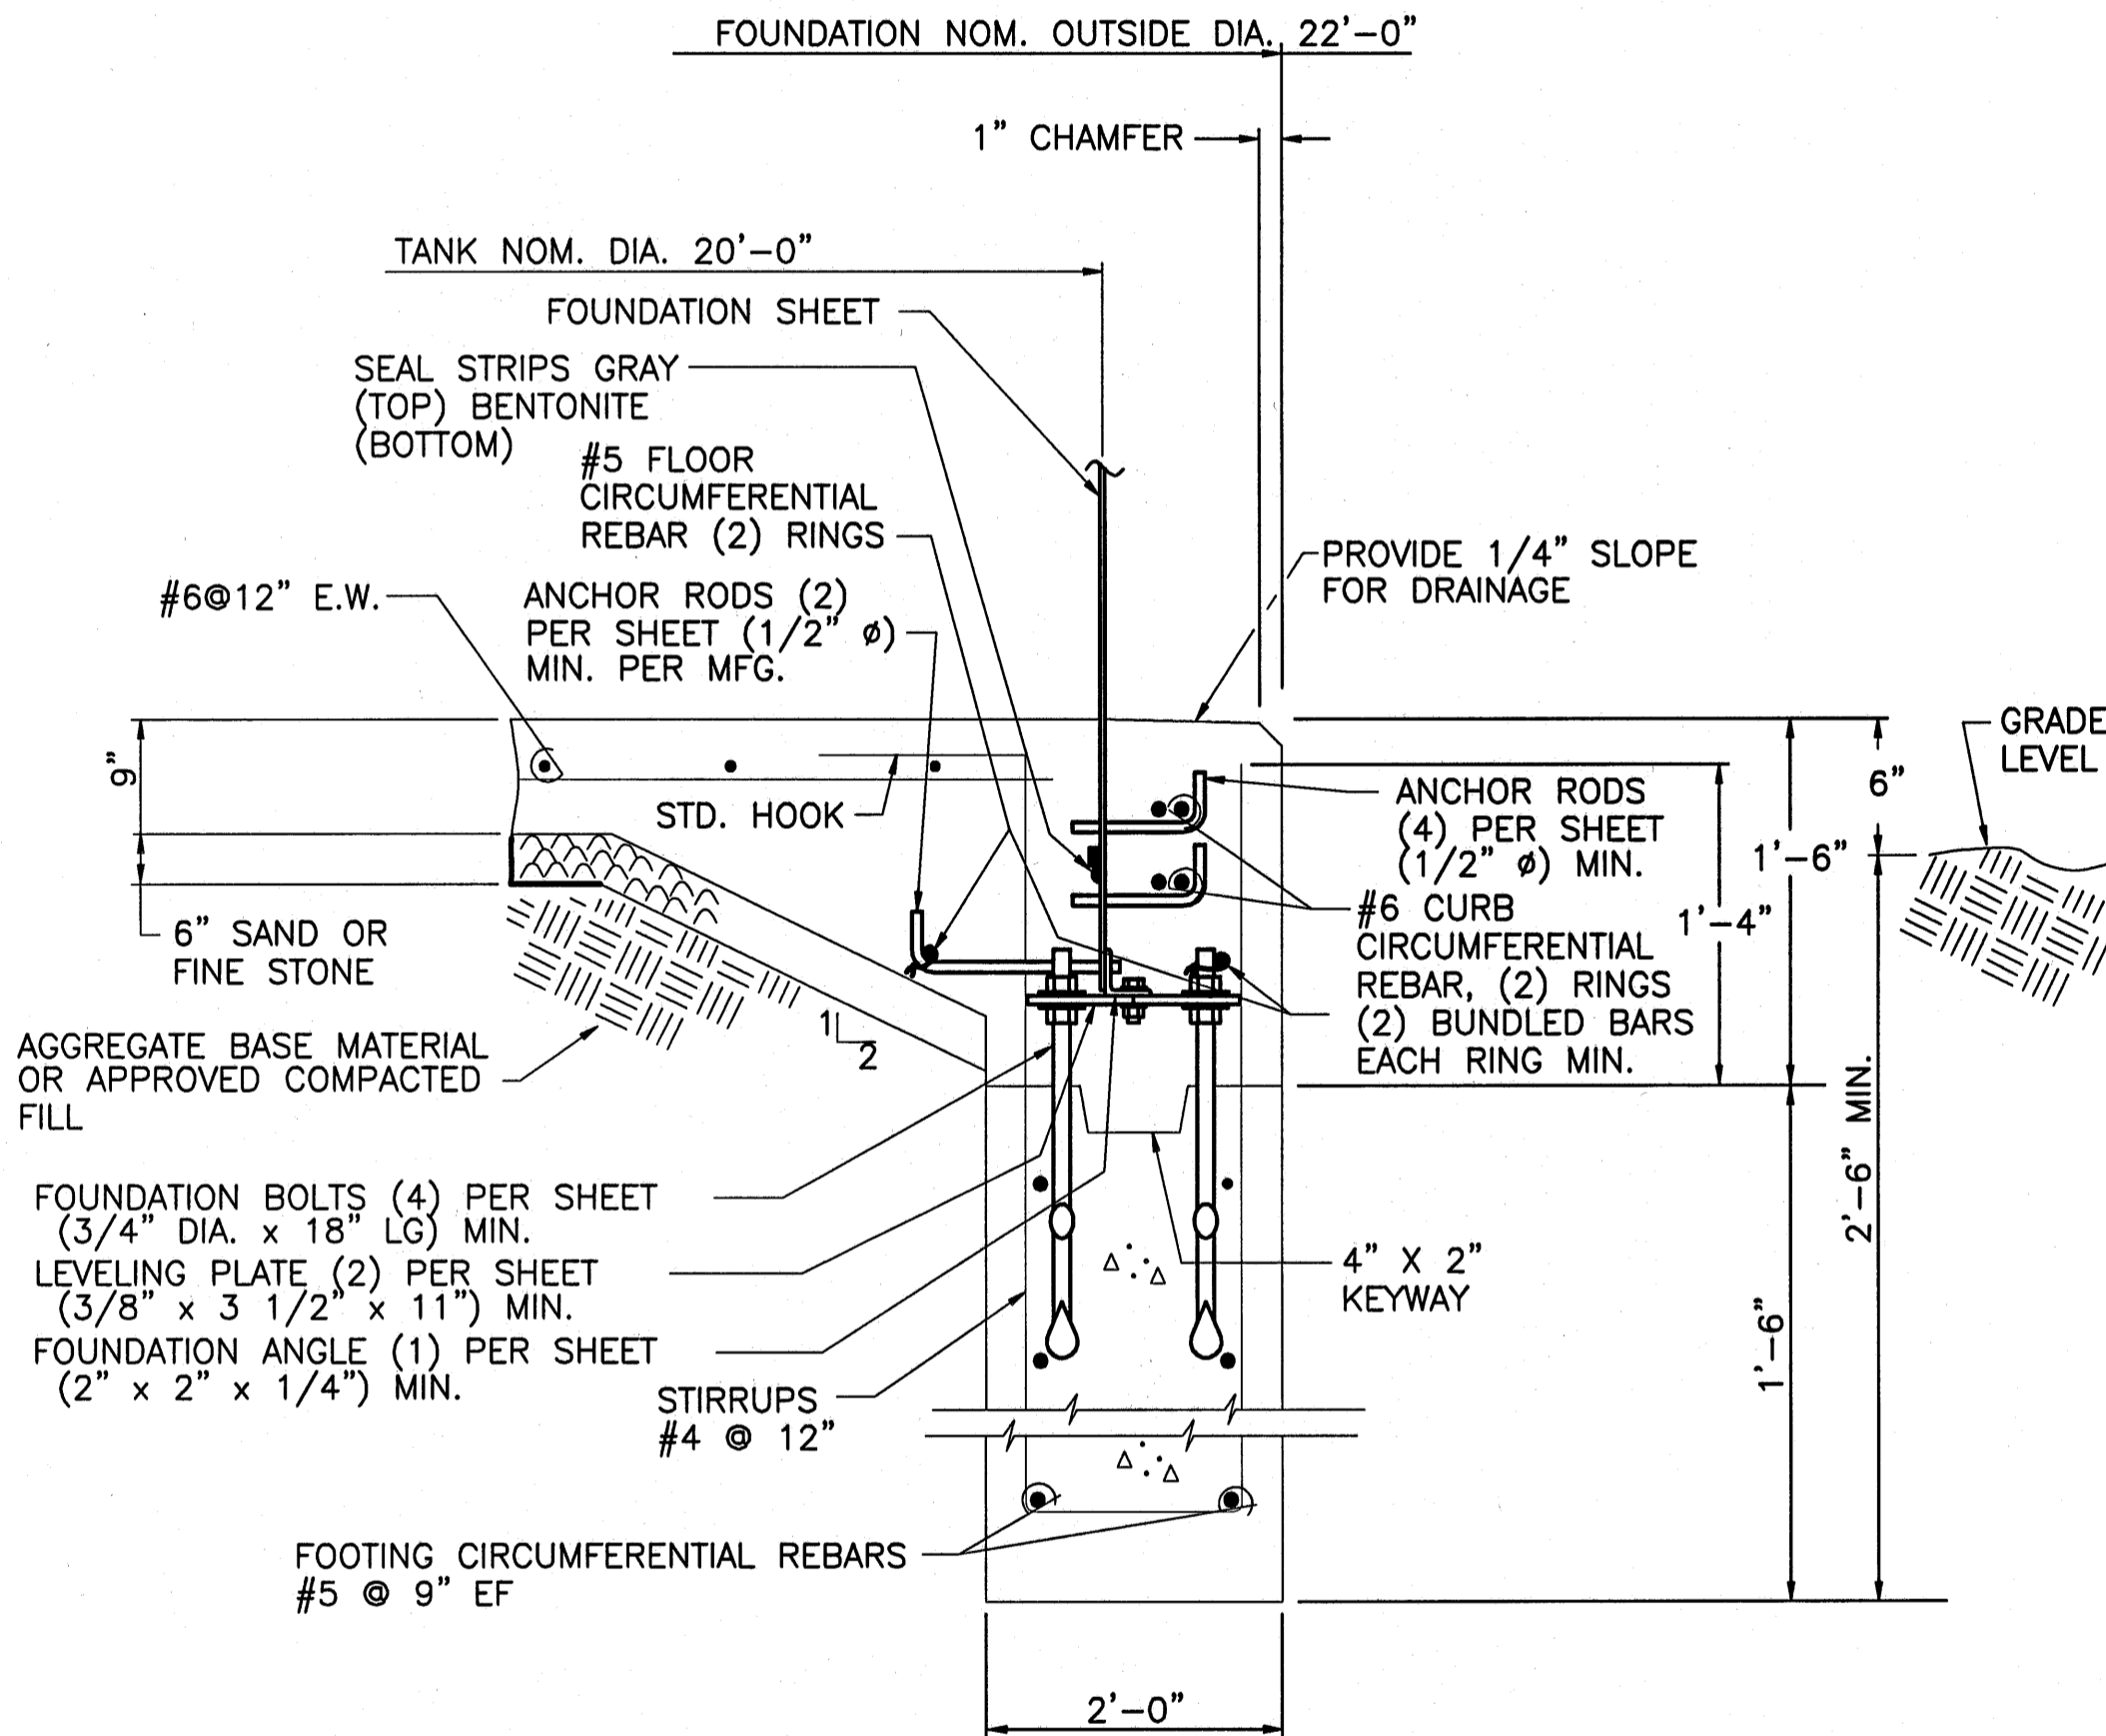

NOTE: SIZES AND QUANTITIES SHOWN ARE MINIMUM ALLOWED.


FOOTING DETAIL- STORAGE TANK
NO SCALE

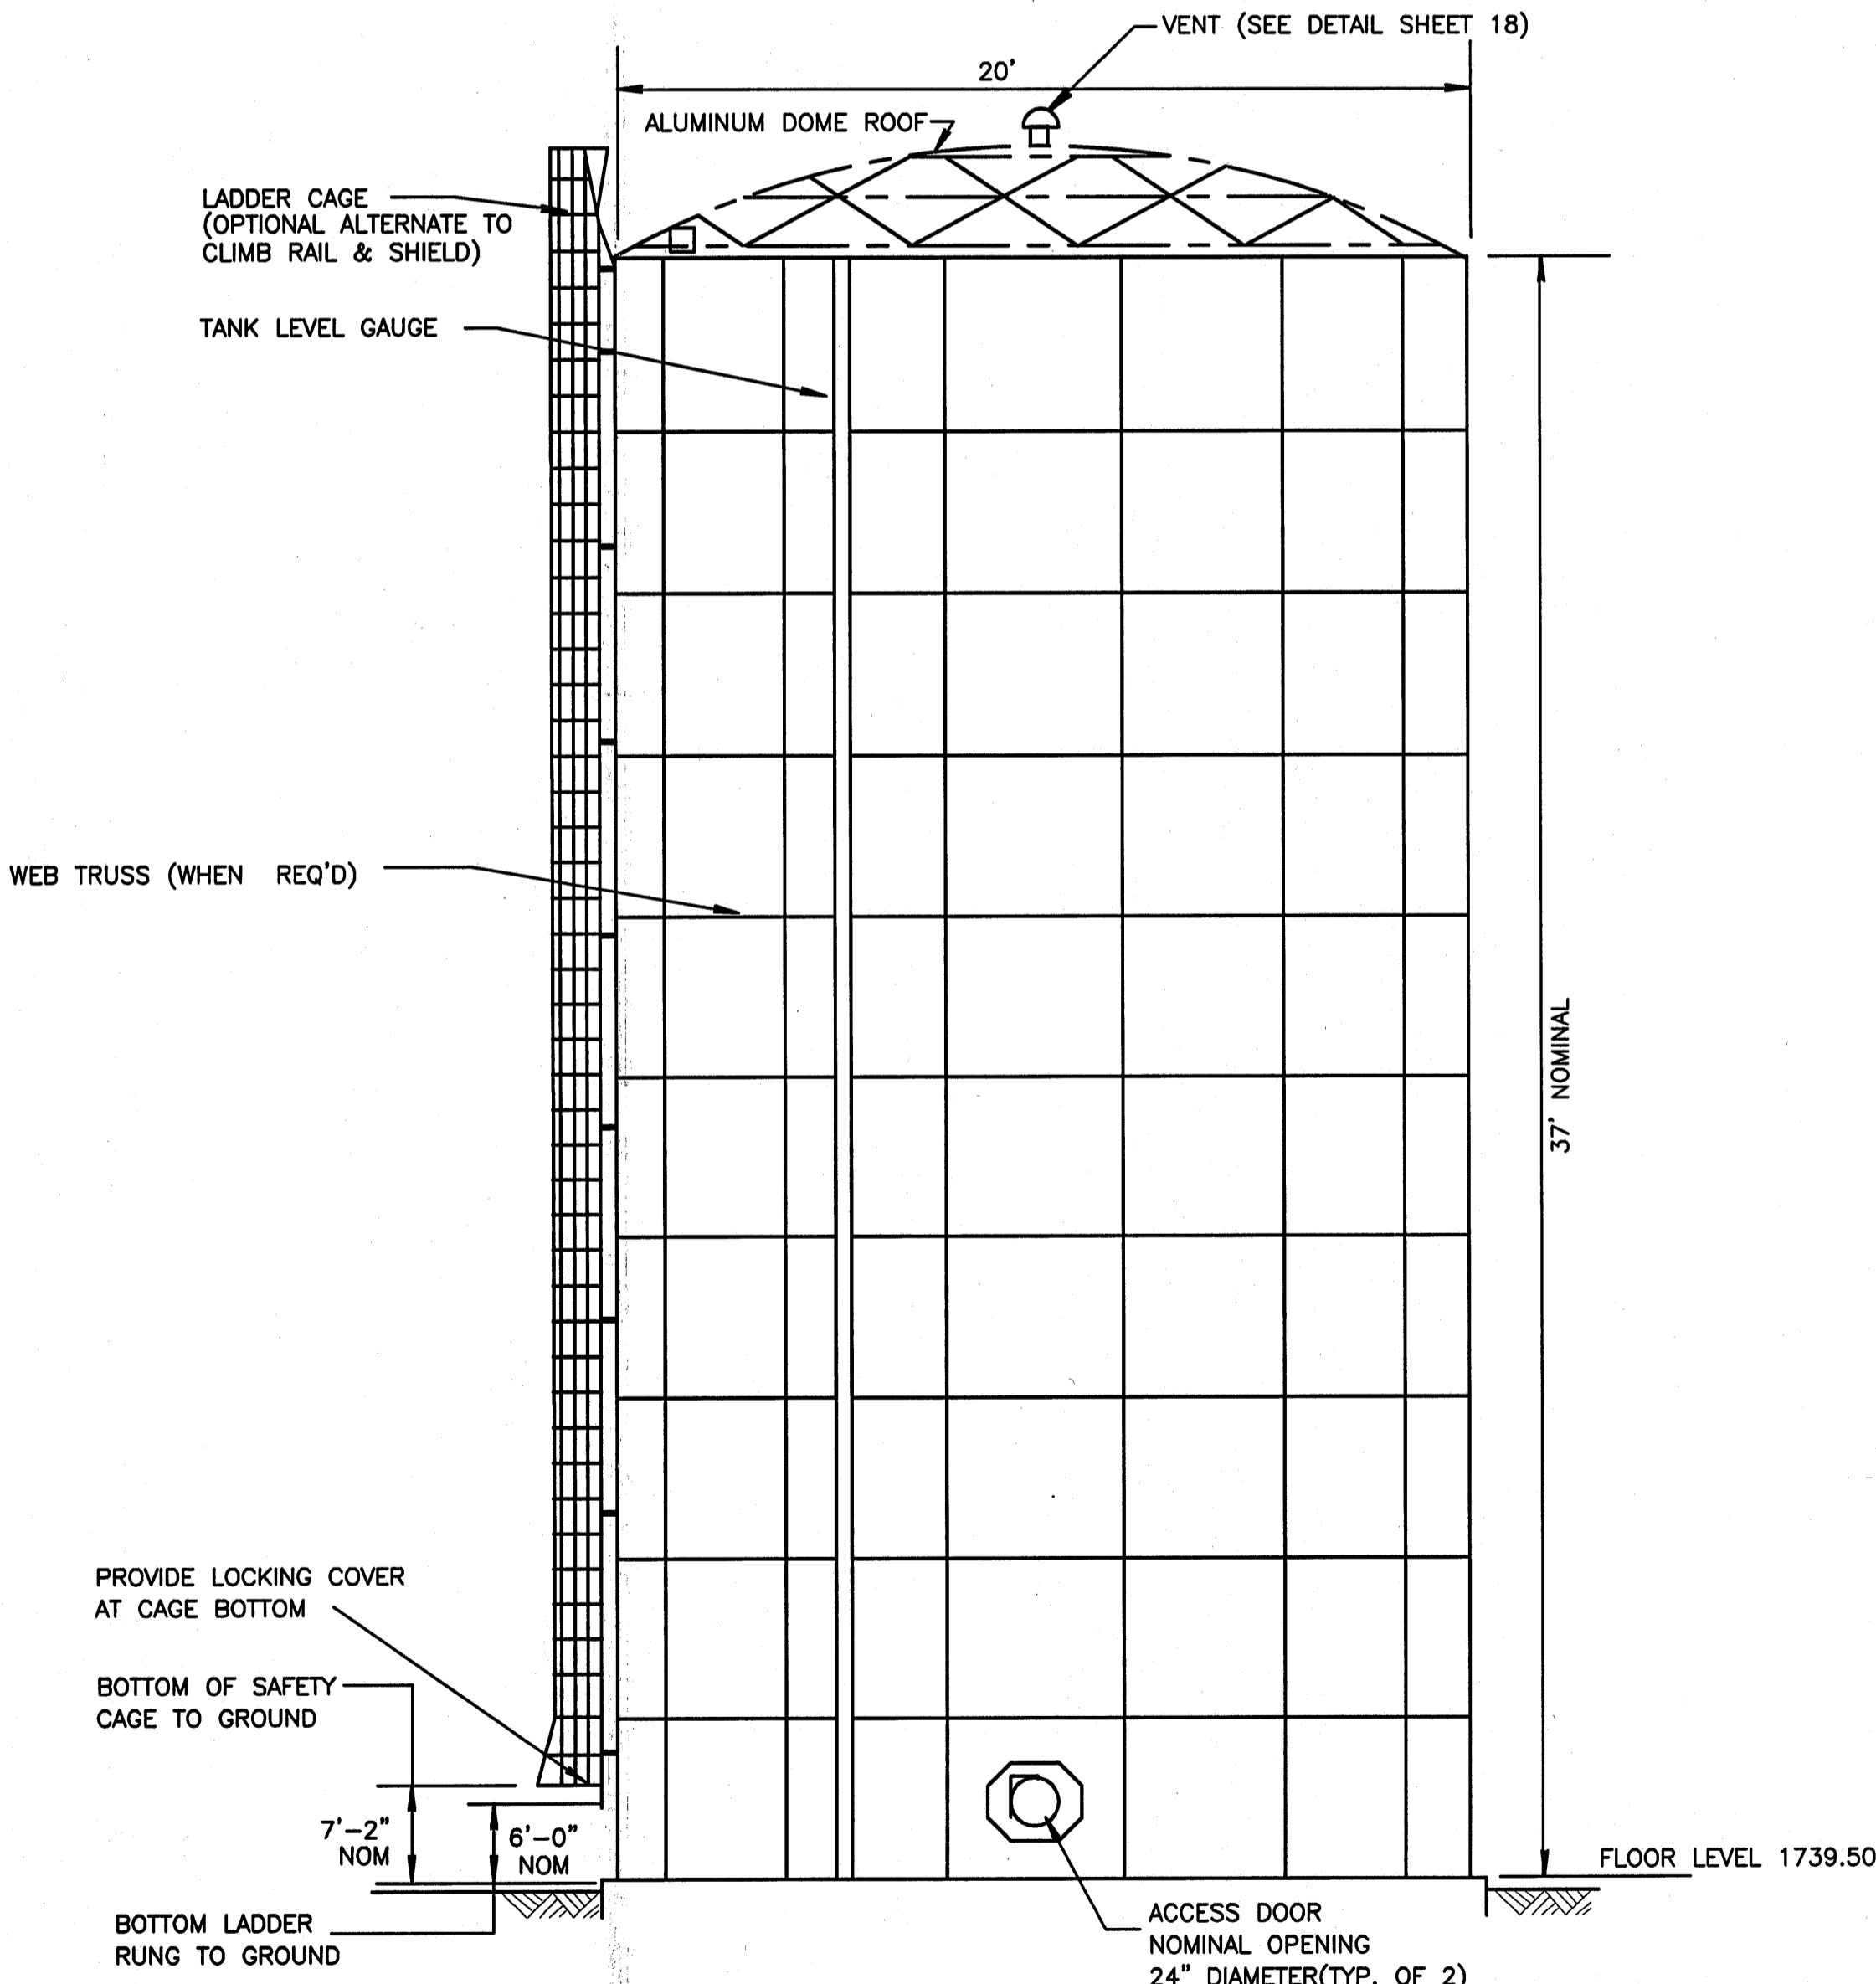

TANK ELEVATION - BOLTED STEEL TANK
NO SCALE

- NOTES:
- 1. PROVIDE ACCESSORIES SHOWN ON SHEET 18 FOR WELDED STEEL TANK.

RECORD DRAWINGS

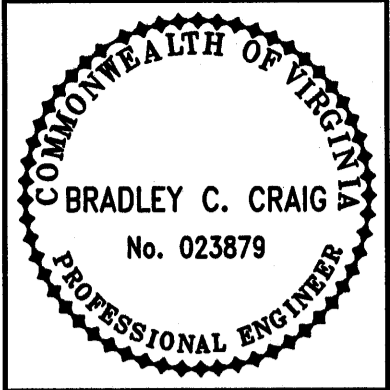

Date	
Revisions	

Issue Date:	02/17/04
Drawn By:	ARB
Designed By:	BCC
Checked By:	BCC
Date:	02/17/04

Mattem & Craig
CONSULTING ENGINEERS • SURVEYORS
701 FIRST STREET, S.W.
ROANOKE, VIRGINIA 24016
(540) 345-7882
FAX (540) 345-7881

MILL MOUNTAIN WATER PROJECT
**WATER TANK -
BOLTED STEEL**
CITY OF ROANOKE, VIRGINIA

Vertical Scale:	N/A
Horizontal Scale:	AS NOTED
Commission Number:	2120
Sheet No.:	21