




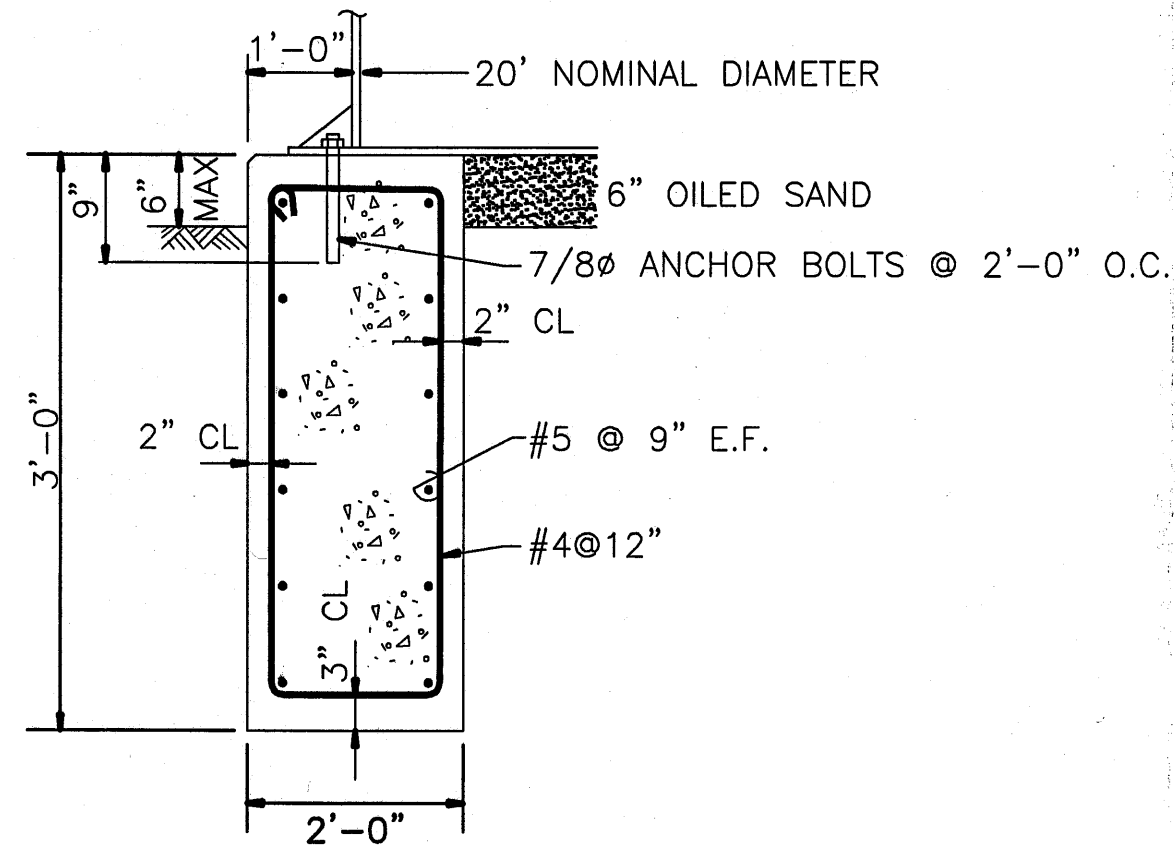

FOOTING DETAIL - WELDED STEEL TANK
NO SCALE

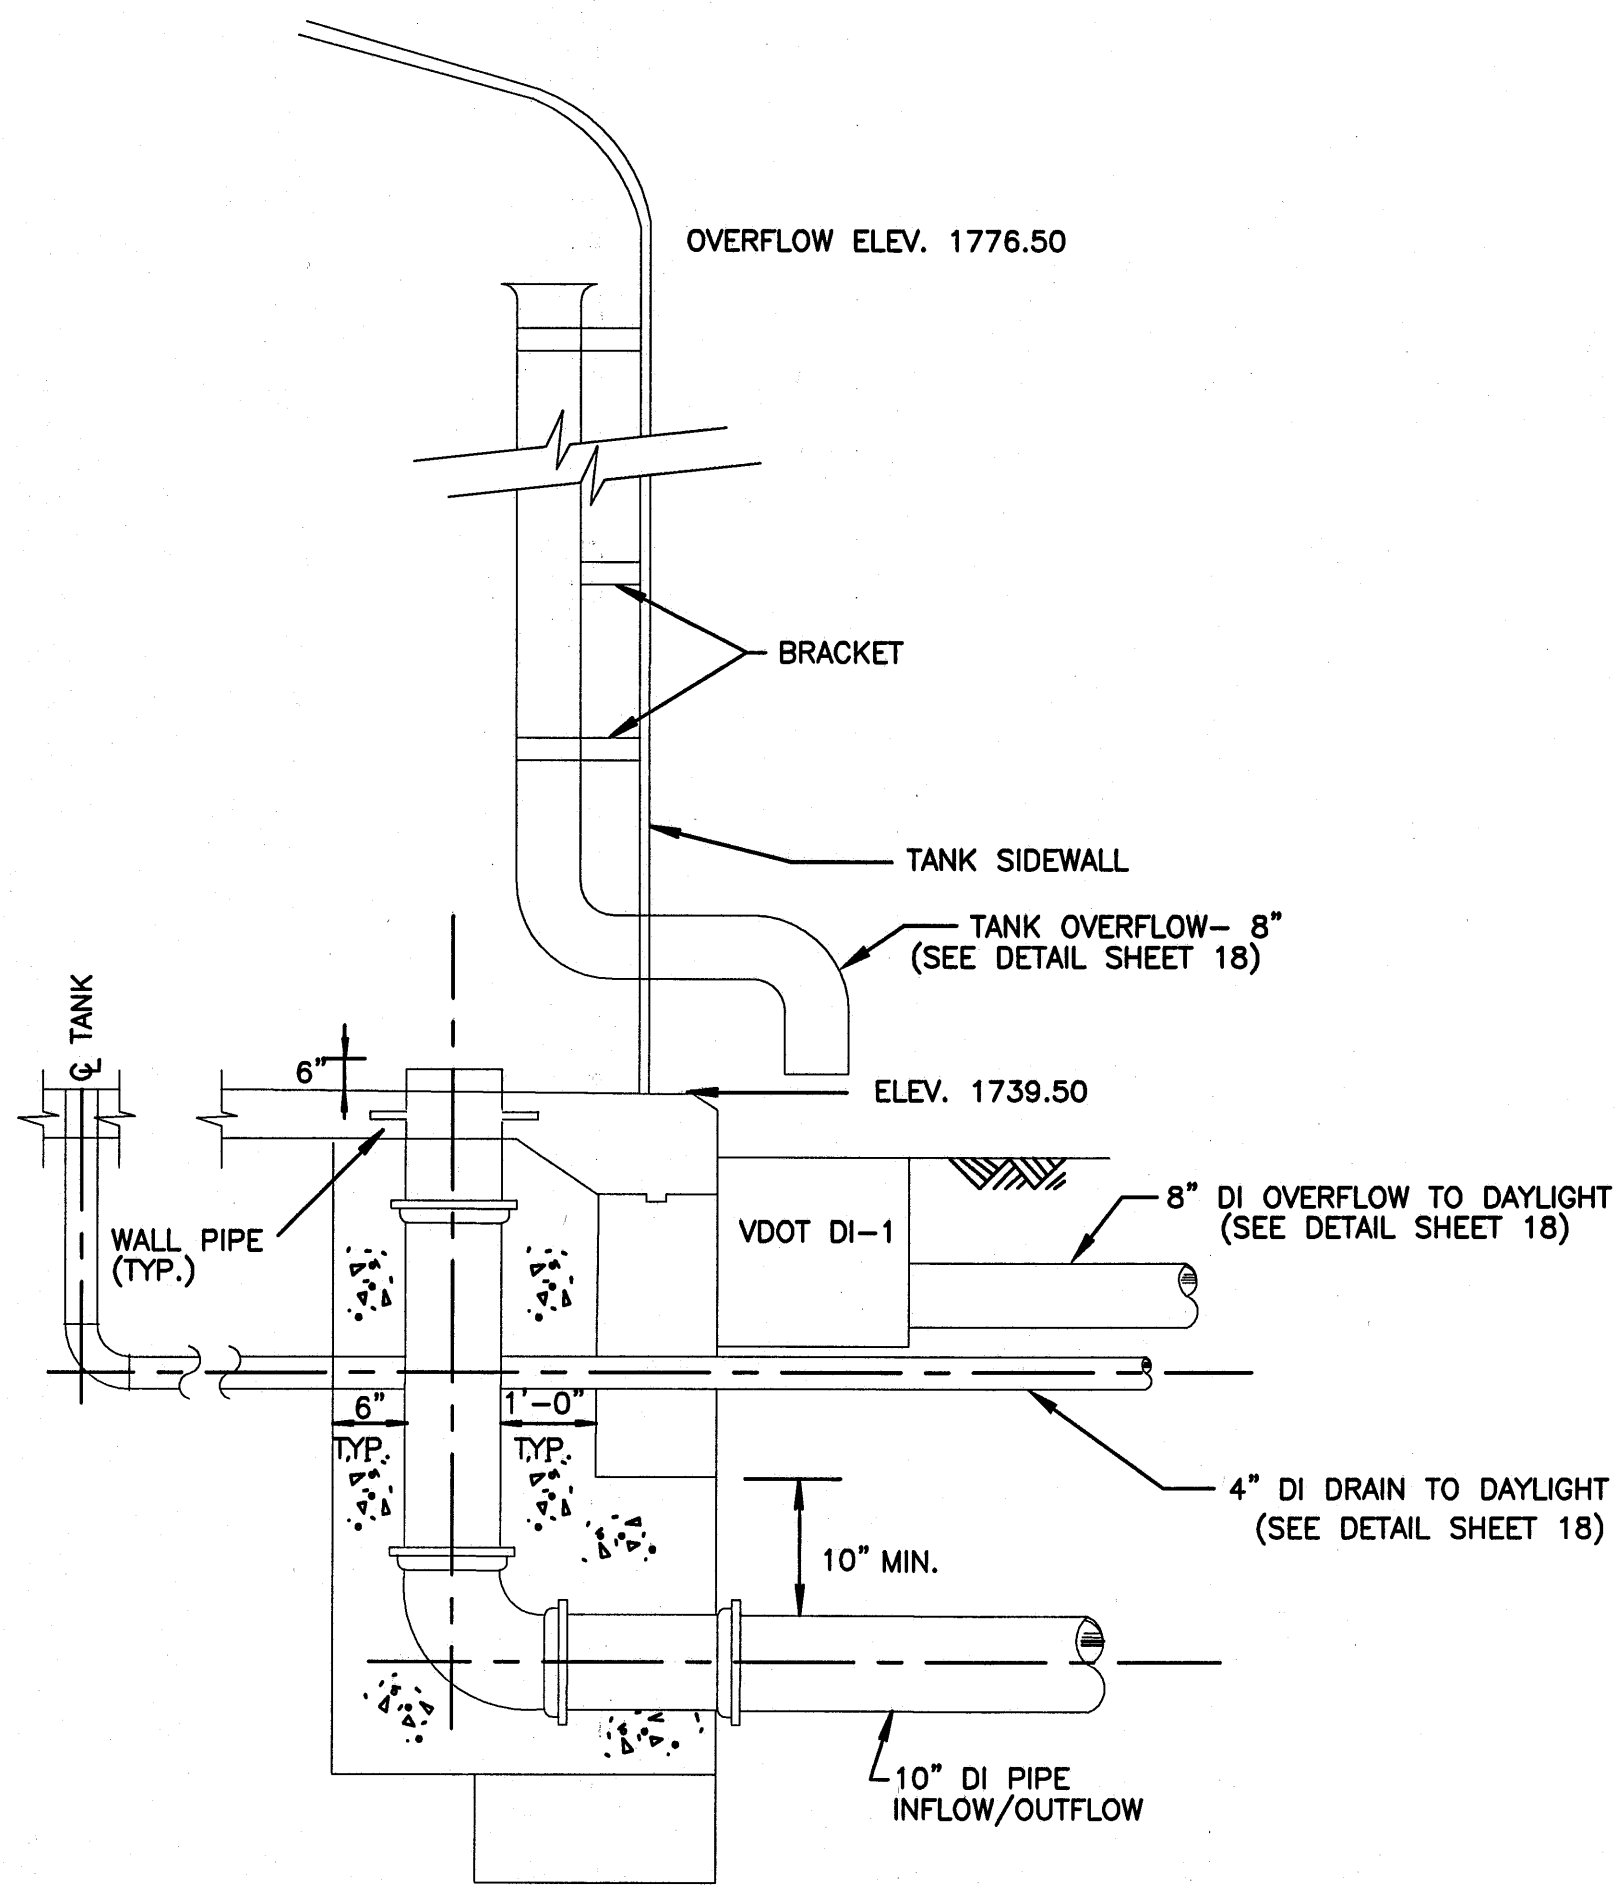

STORAGE TANK DISTRIBUTION LINE
NO SCALE

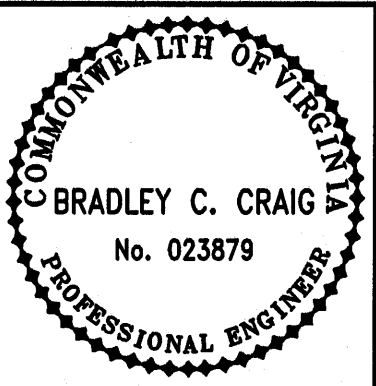

Revisions	Date

Issue Date: 02/17/04	Drawn By: ARB	Designed By: BCC	Checked By: BCC	Date: 02/17/04
-------------------------	---------------	------------------	-----------------	----------------

Mattem & Craig
CONSULTING ENGINEERS • SURVEYORS
701 FIRST STREET, S.W.
ROANOKE, VIRGINIA 24016
(800) 345-5302
FAX (800) 345-7891

MILL MOUNTAIN WATER PROJECT
WATER TANK - DETAILS
CITY OF ROANOKE, VIRGINIA

Vertical Scale:
N/A

Horizontal Scale:
AS NOTED

Commission Number:
2120

Sheet No.:
22

RECORD DRAWINGS