


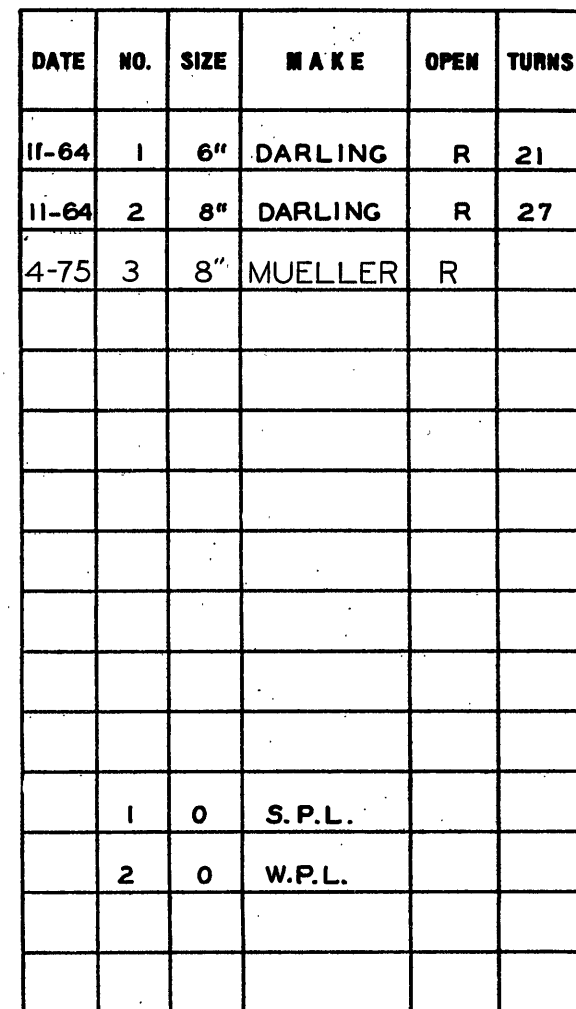

DATE PAGE NO.