


ROANOKE COUNTY
PUBLIC SERVICE AUTHORITY
ROANOKE COUNTY, VIRGINIA
PROJECT NO. 72-4-S

AUTHORITY MEMBERS

L.S.	WALDROP		CHAIRMAN
F.R.	ANGELL	VICE	CHAIRMAN
H.F.	REED		
R.H.	RICHARDSON		
B.W.	MAHONEY		

J.A. BEAVERS EXECUTIVE DIRECTOR

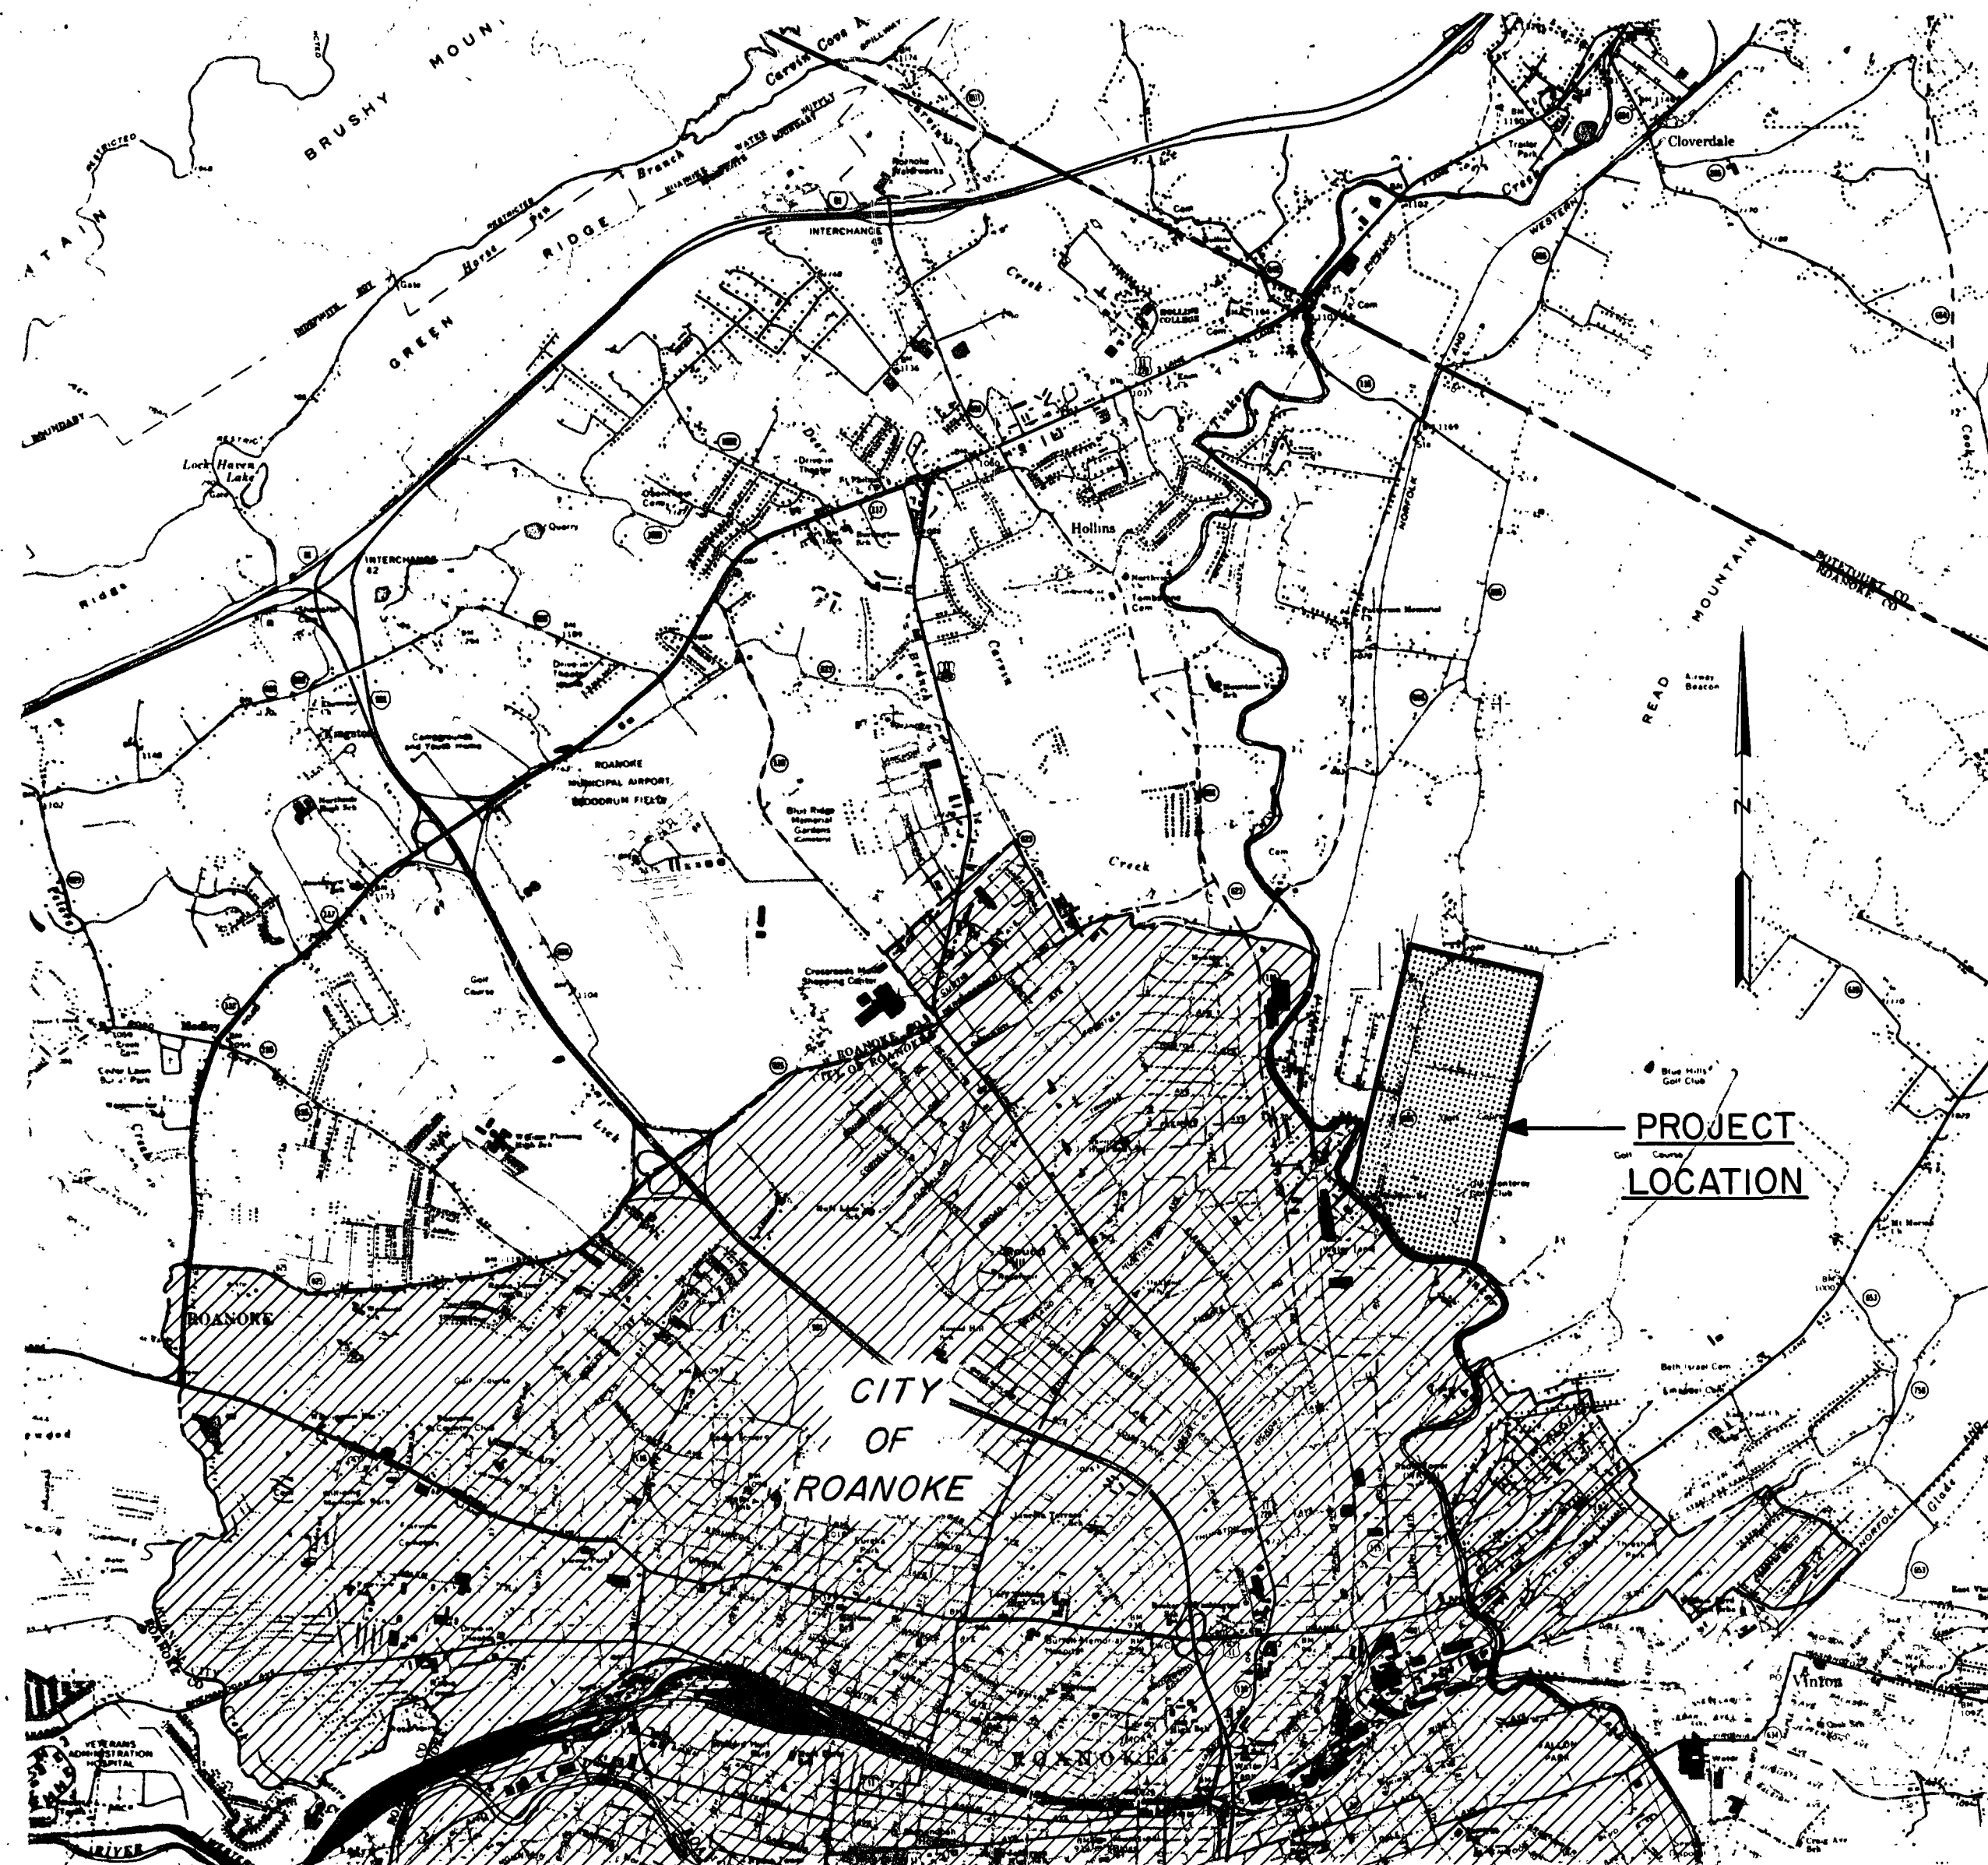

LEGEND

- | | |
|--|-----------------------------|
| | SURVEY BASE LINE |
| | PROPERTY LINE |
| | RIGHT OF WAY LINE |
| | EDGE OF PAVEMENT |
| | EXISTING SANITARY SEWER |
| | PROPOSED SANITARY SEWER |
| | EXISTING MANHOLE |
| | PROPOSED MANHOLE |
| | PROPOSED CLEANOUT |
| | PROPOSED METERING STATION |
| | WATER MAIN |
| | GAS LINE |
| | ELECTRIC CABLE OR CONDUIT |
| | TELEPHONE CABLE OR CONDUIT |
| | RAILROAD TRACKS |
| | DITCH |
| | STREAM |
| | FENCE |
| | FIRE HYDRANT |
| | POWER POLE |
| | TELEPHONE POLE AND GUY WIRE |
| | VALVE VAULT |
| | WATER METER |
| | TREE |
| | SHRUB |
| | HEDGE |
| | ROCK OR STONE WALL |
| | EXISTING GROUND |


SCHEDULE OF DRAWINGS

<u>SHEET</u>	<u>TITLE</u>	<u>STATION</u>
1.	MONTEREY INTERCEPTOR	0+07 - 11+00
2.	MONTEREY INTERCEPTOR	11+00 - 27+00
3.	MONTEREY INTERCEPTOR	27+00 - 41+43
4.	DETAILS	

[illegible]

SANITARY SEWERAGE SYSTEM **MONTEREY INTERCEPTOR**

LANGLEY, McDONALD AND OVERMAN
CONSULTING ENGINEERS
NORFOLK, VIRGINIA

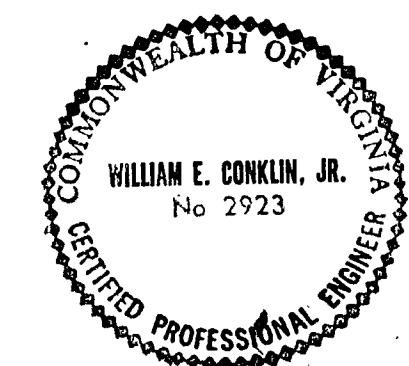

AS BUILT