



DESIGNED BY	DATE
DRAWN BY	DATE
CHECKED BY	DATE
IN CHARGE	DATE
PROJECT NO.	
SHEET NO.	

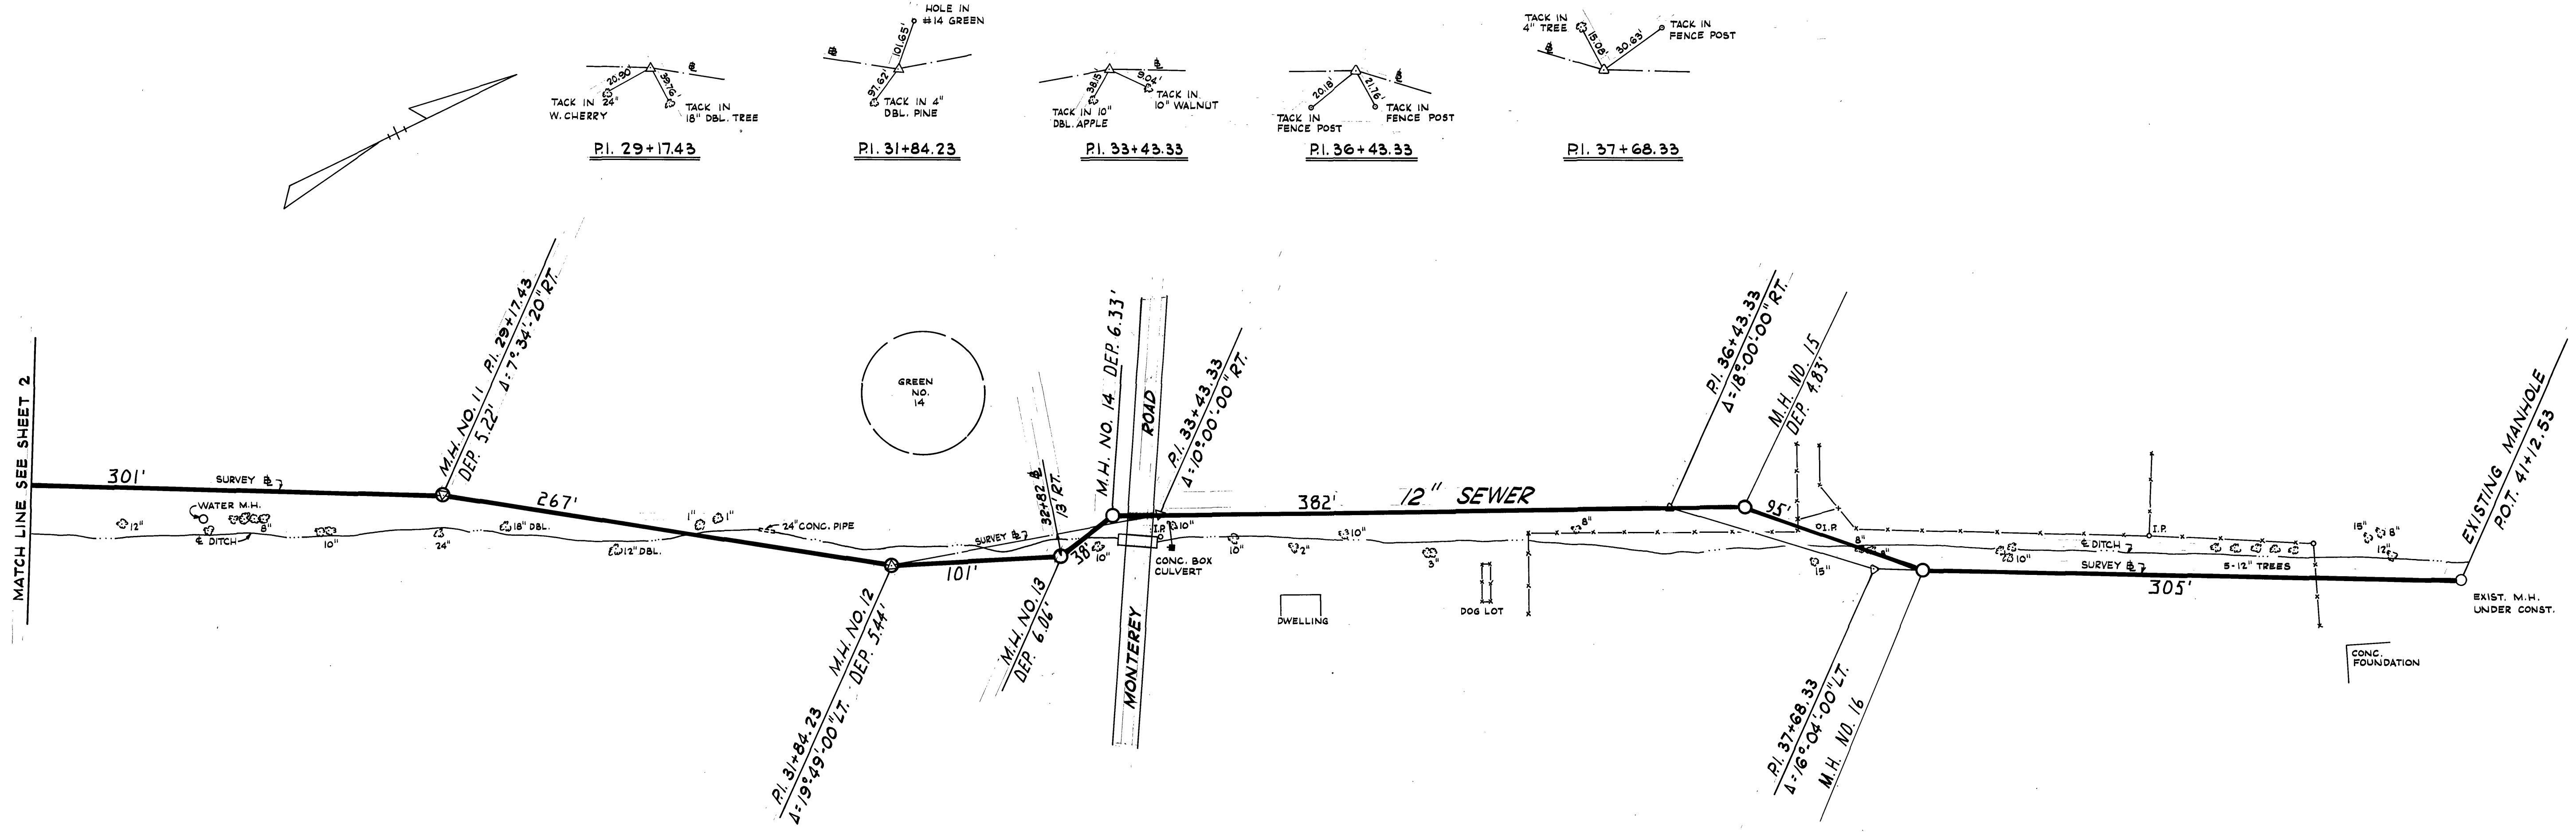

SCALE: 1 IN. = 50 FT.

DESIGNED BY	DATE
DRAWN BY	DATE
CHECKED BY	DATE
IN CHARGE	DATE
PROJECT NO.	
SHEET NO.	

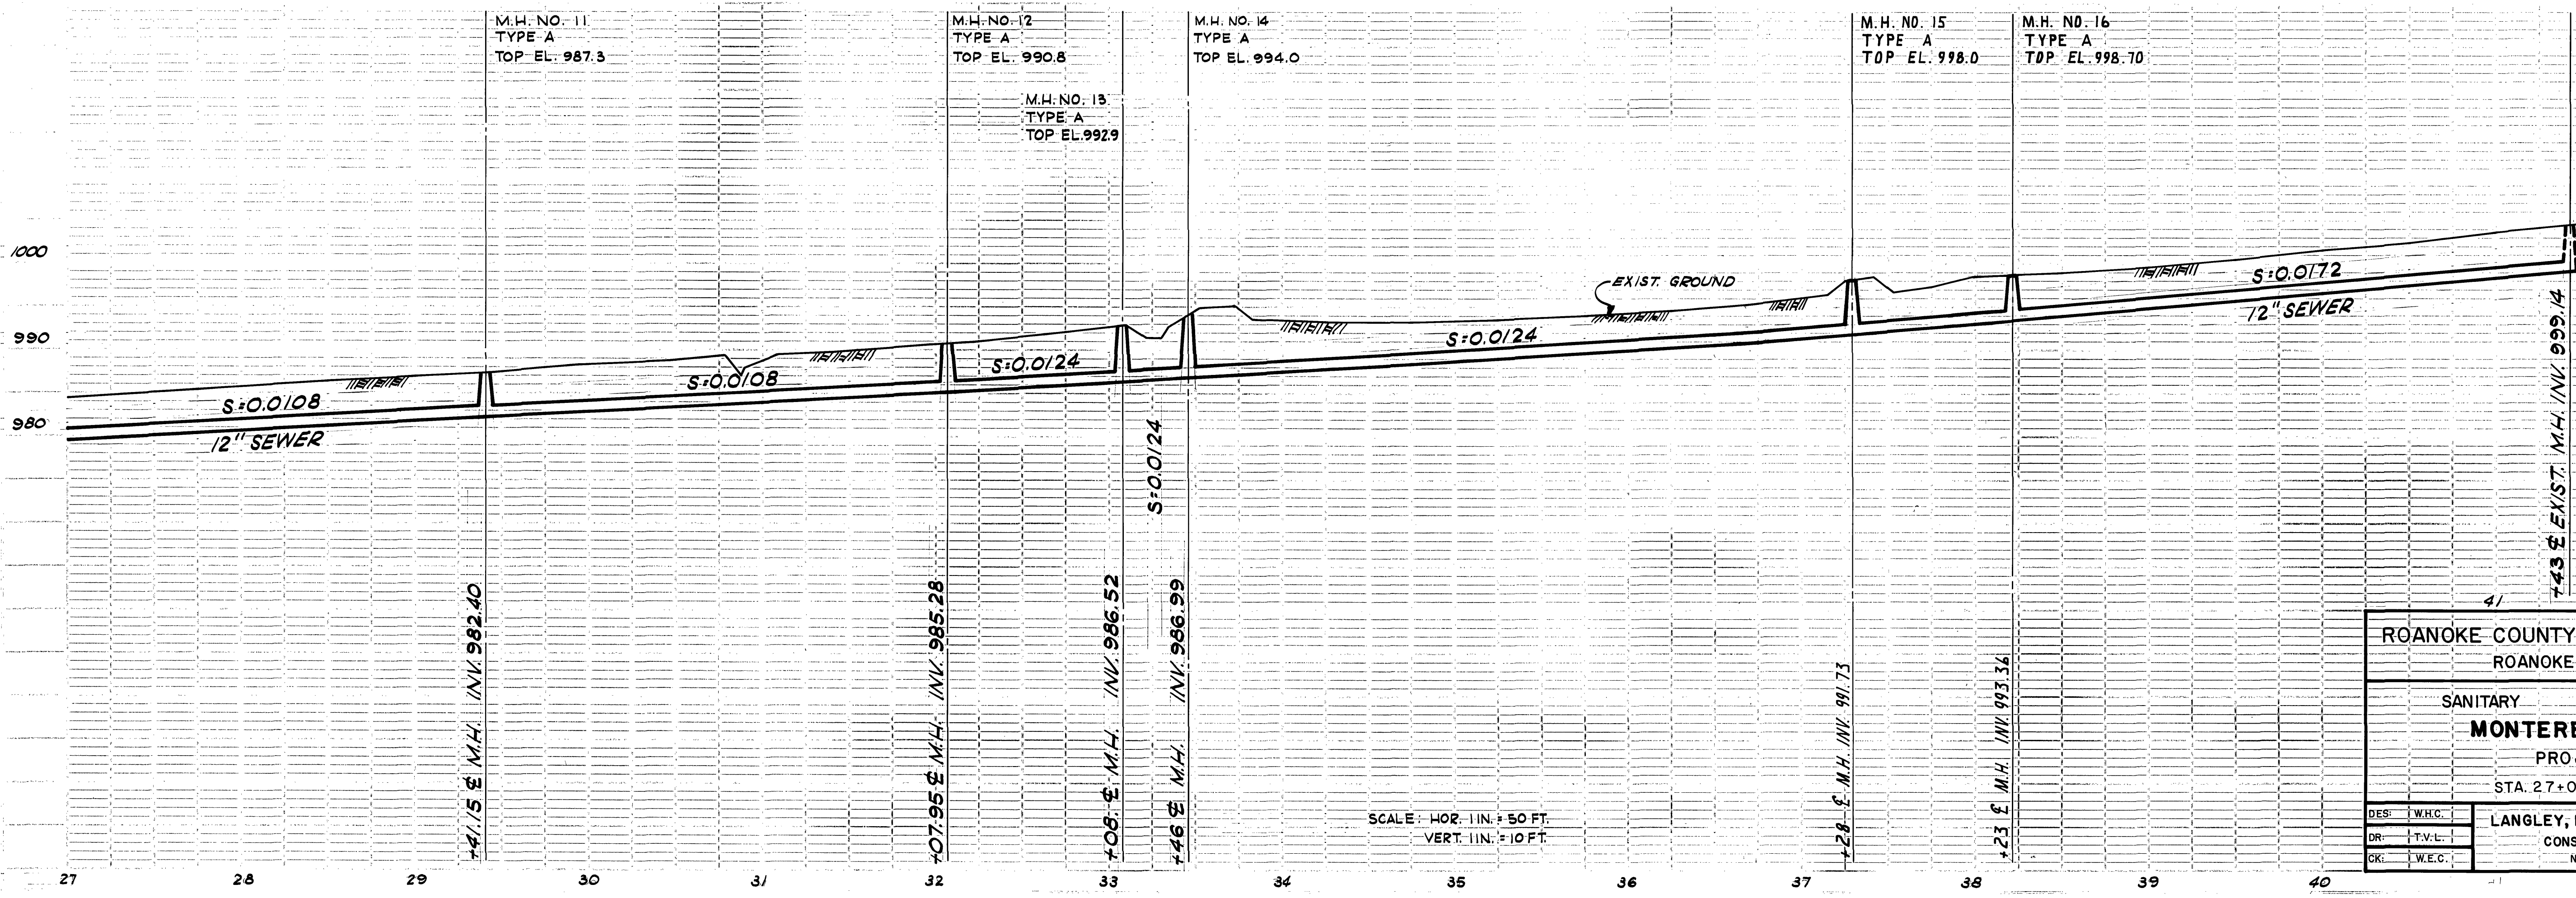

SCALE: HOR. 1 IN. = 50 FT.
VERT. 1 IN. = 10 FT.

AS BUILT

ROANOKE COUNTY PUBLIC SERVICE AUTHORITY ROANOKE COUNTY, VIRGINIA			
SANITARY		SEWERAGE	
SYSTEM			
MONTEREY INTERCEPTOR			
PROJECT No. 72-4-S			
STA. 27+00		TO STA. 41+43	
DES: T.W.C.	DR: T.V.L.	SCALE: AS SHOWN	
CK: W.E.C.	LANGLEY, McDONALD and OVERMAN		DATE: 11-1-72
CONSULTING ENGINEERS		SHEET 3 OF 4	
NORFOLK VIRGINIA			