


PLAN	DATE	BY
SURVEYED		
NOTED		
ALIGNED		
RT. OF WAY		
NO.		

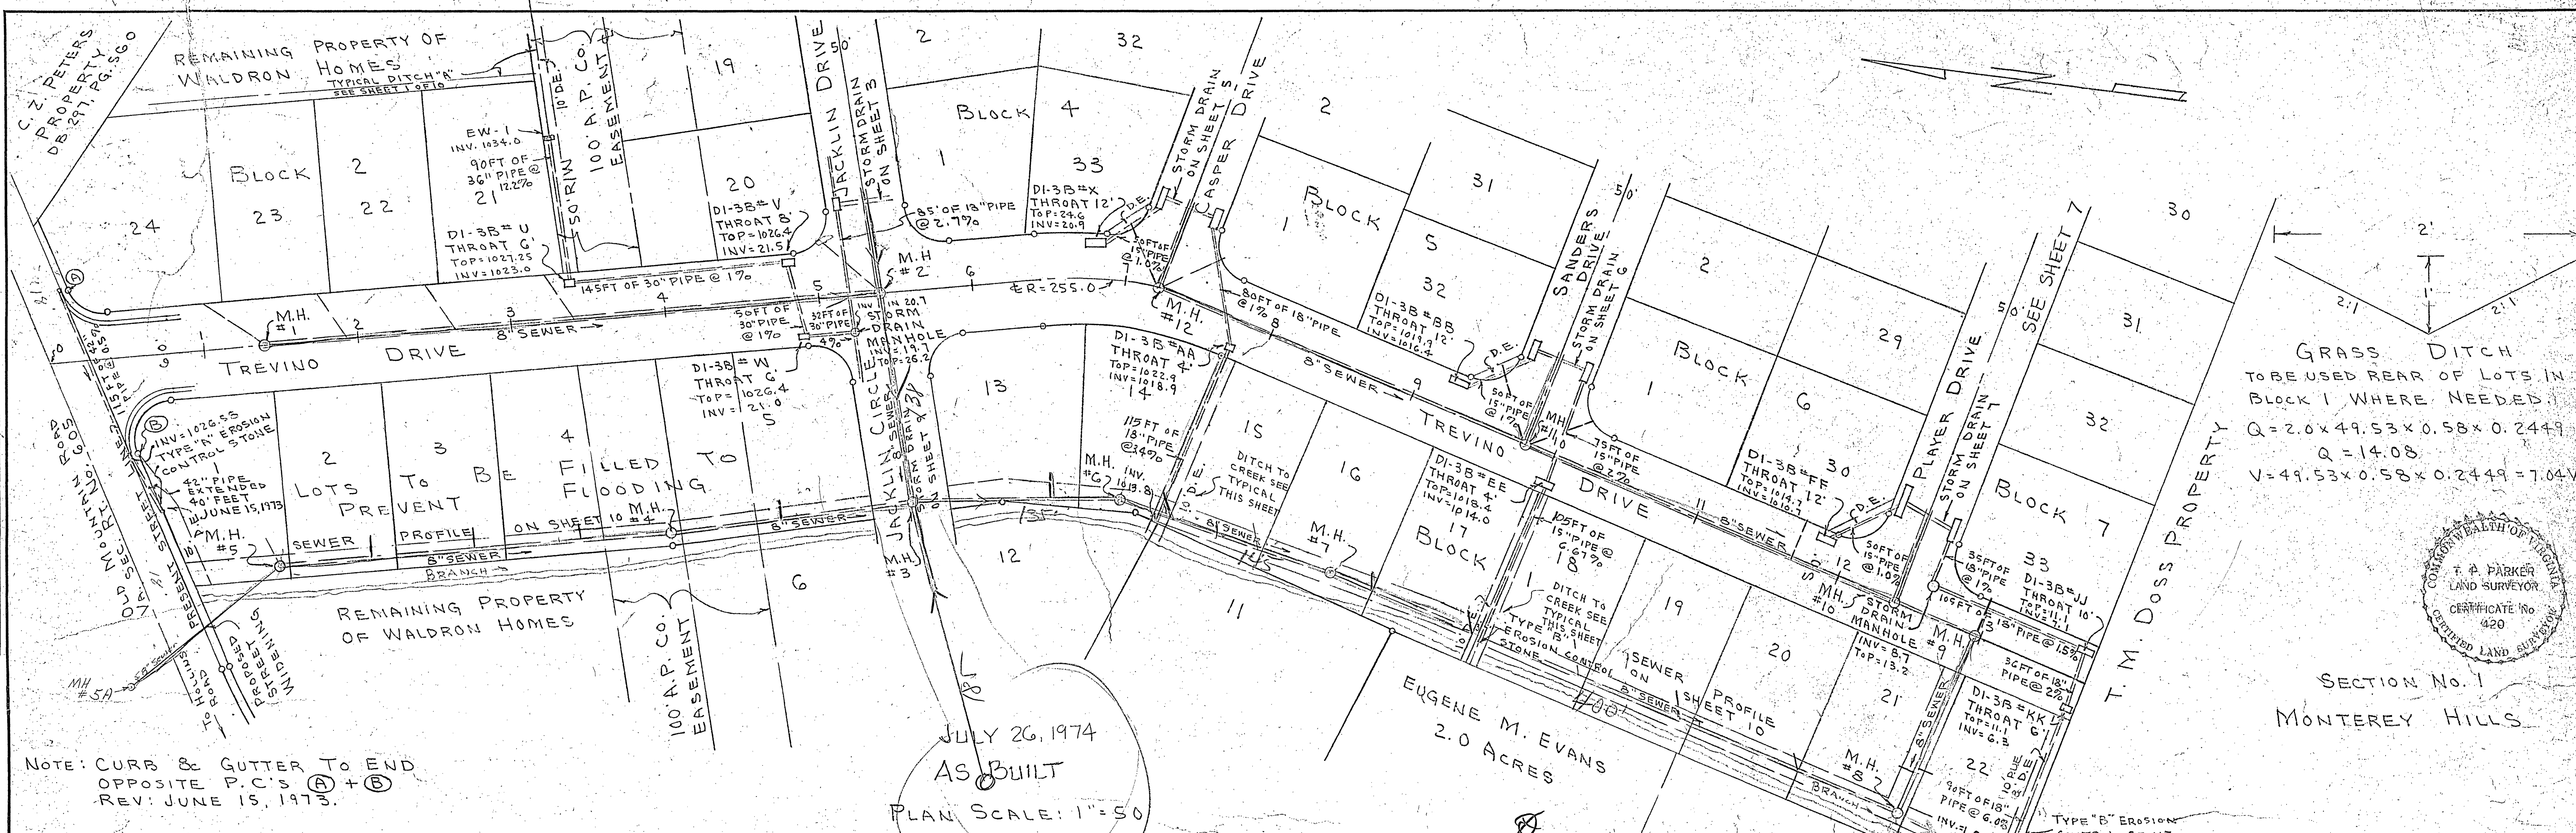

NOTE: CURB & GUTTER TO END
OPPOSITE P.C.'S (A) + (B)
REV: JUNE 15, 1973.

JULY 26, 1974
AS BUILT
PLAN SCALE: 1" = 50'

PROFILE	DATE	BY
SURVEYED		
NOTED		
GRADES CHECKED		
RT. OF WAY		
NO.		

