


PLAN	DATE
SURVEYED	
PLOTTED	
OTE BOOK	
ALIGNMENT CHECKED	
INT. OF WY. CHECKED	
0	

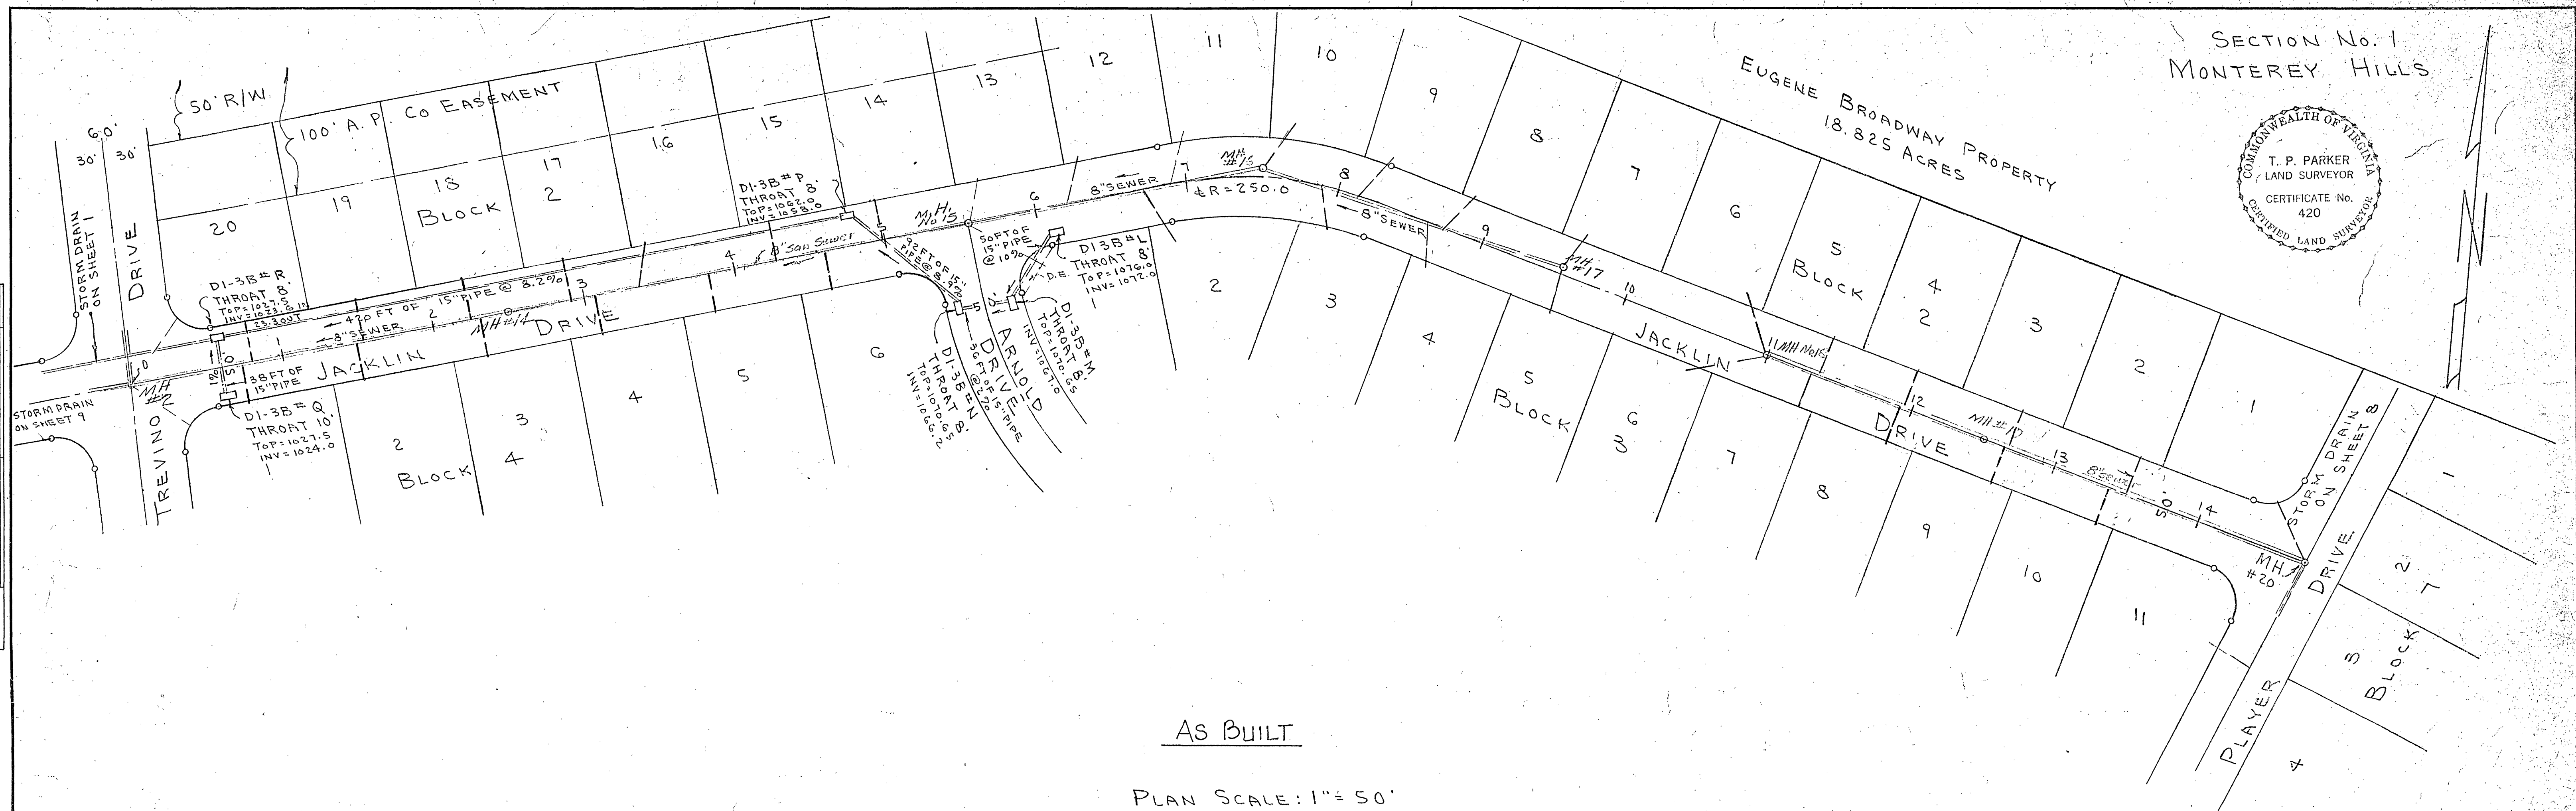

AS BUILT

PLAN SCALE: 1" = 50'

PROFILE	DATE
SURVEYED	
PLOTTED	
NOTE BOOK	
GRADES CHECKED	
STRUCTURE NOTATIONS OK'D	
NO.	

