



PLAN	DATE	BY
SURVEYED		
NOTE BOOK		
NO.		

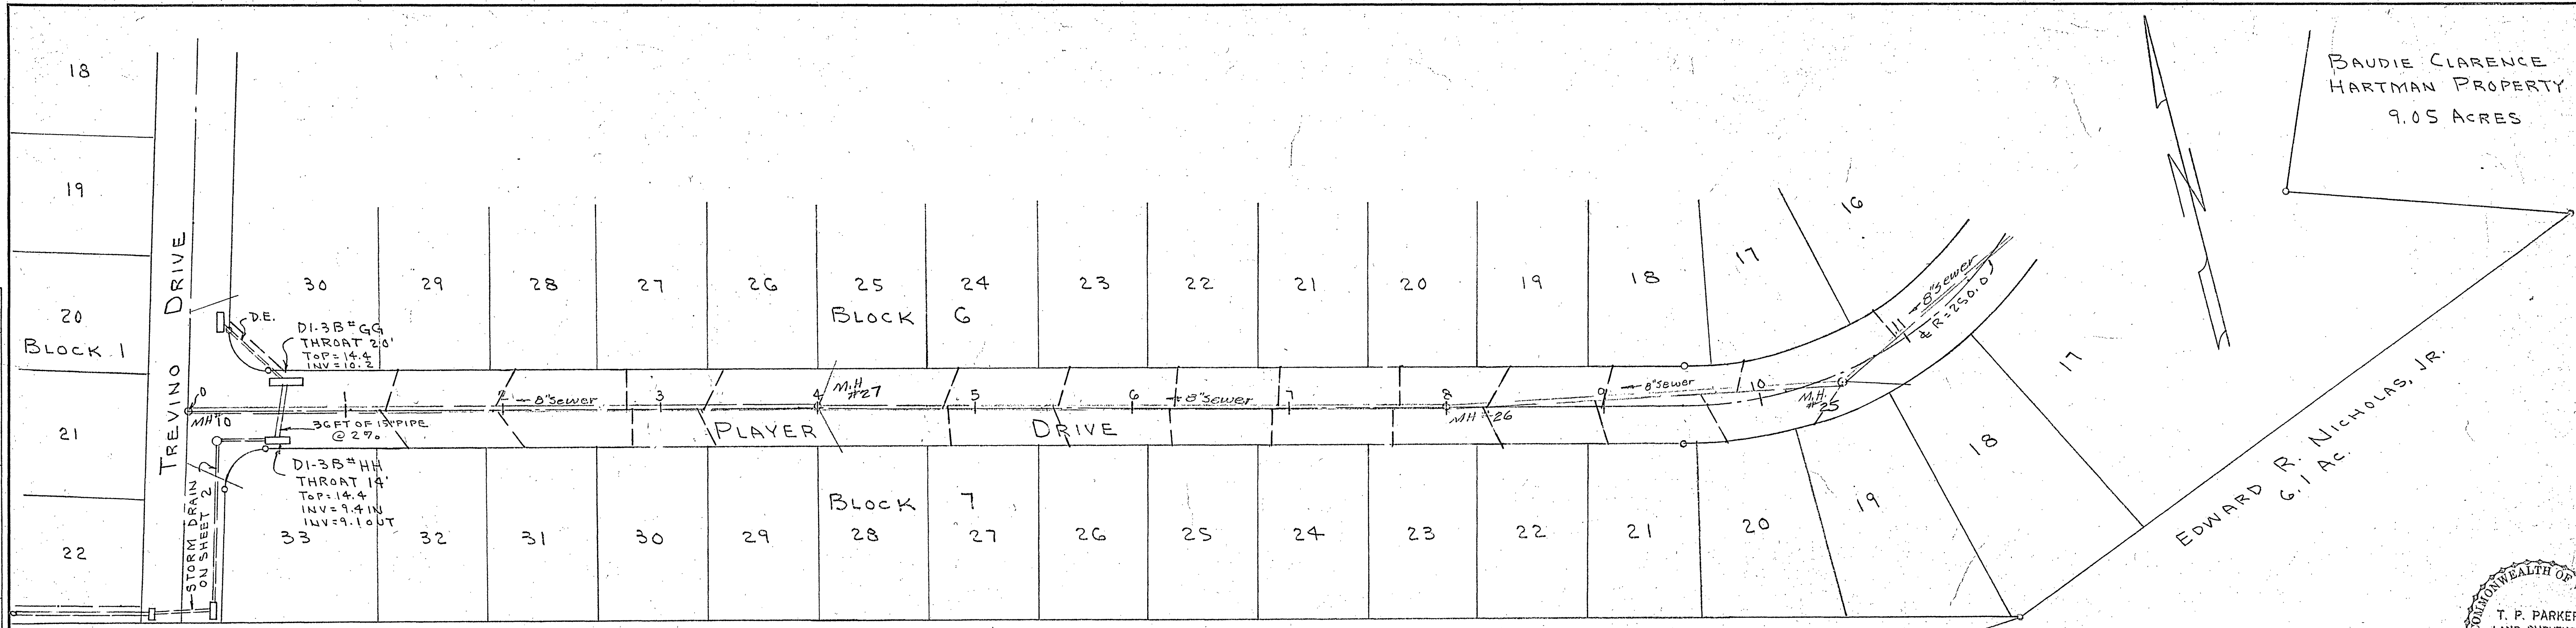

BAUDIE CLARENCE
HARTMAN PROPERTY
9.05 ACRES

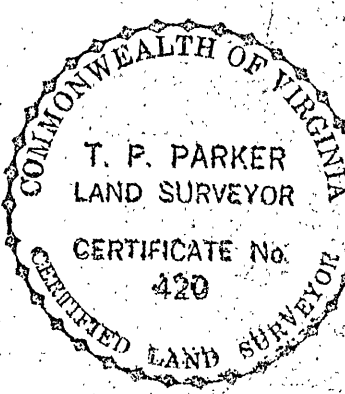


SECTION No. 1
MONTEREY HILLS

T. M. DOSS PROPERTY
8 AC.

AS BUILT
PLAN SCALE: 1" = 50'

PROFILE	DATE	BY
SURVEYED		
NOTE BOOK		
NO.		

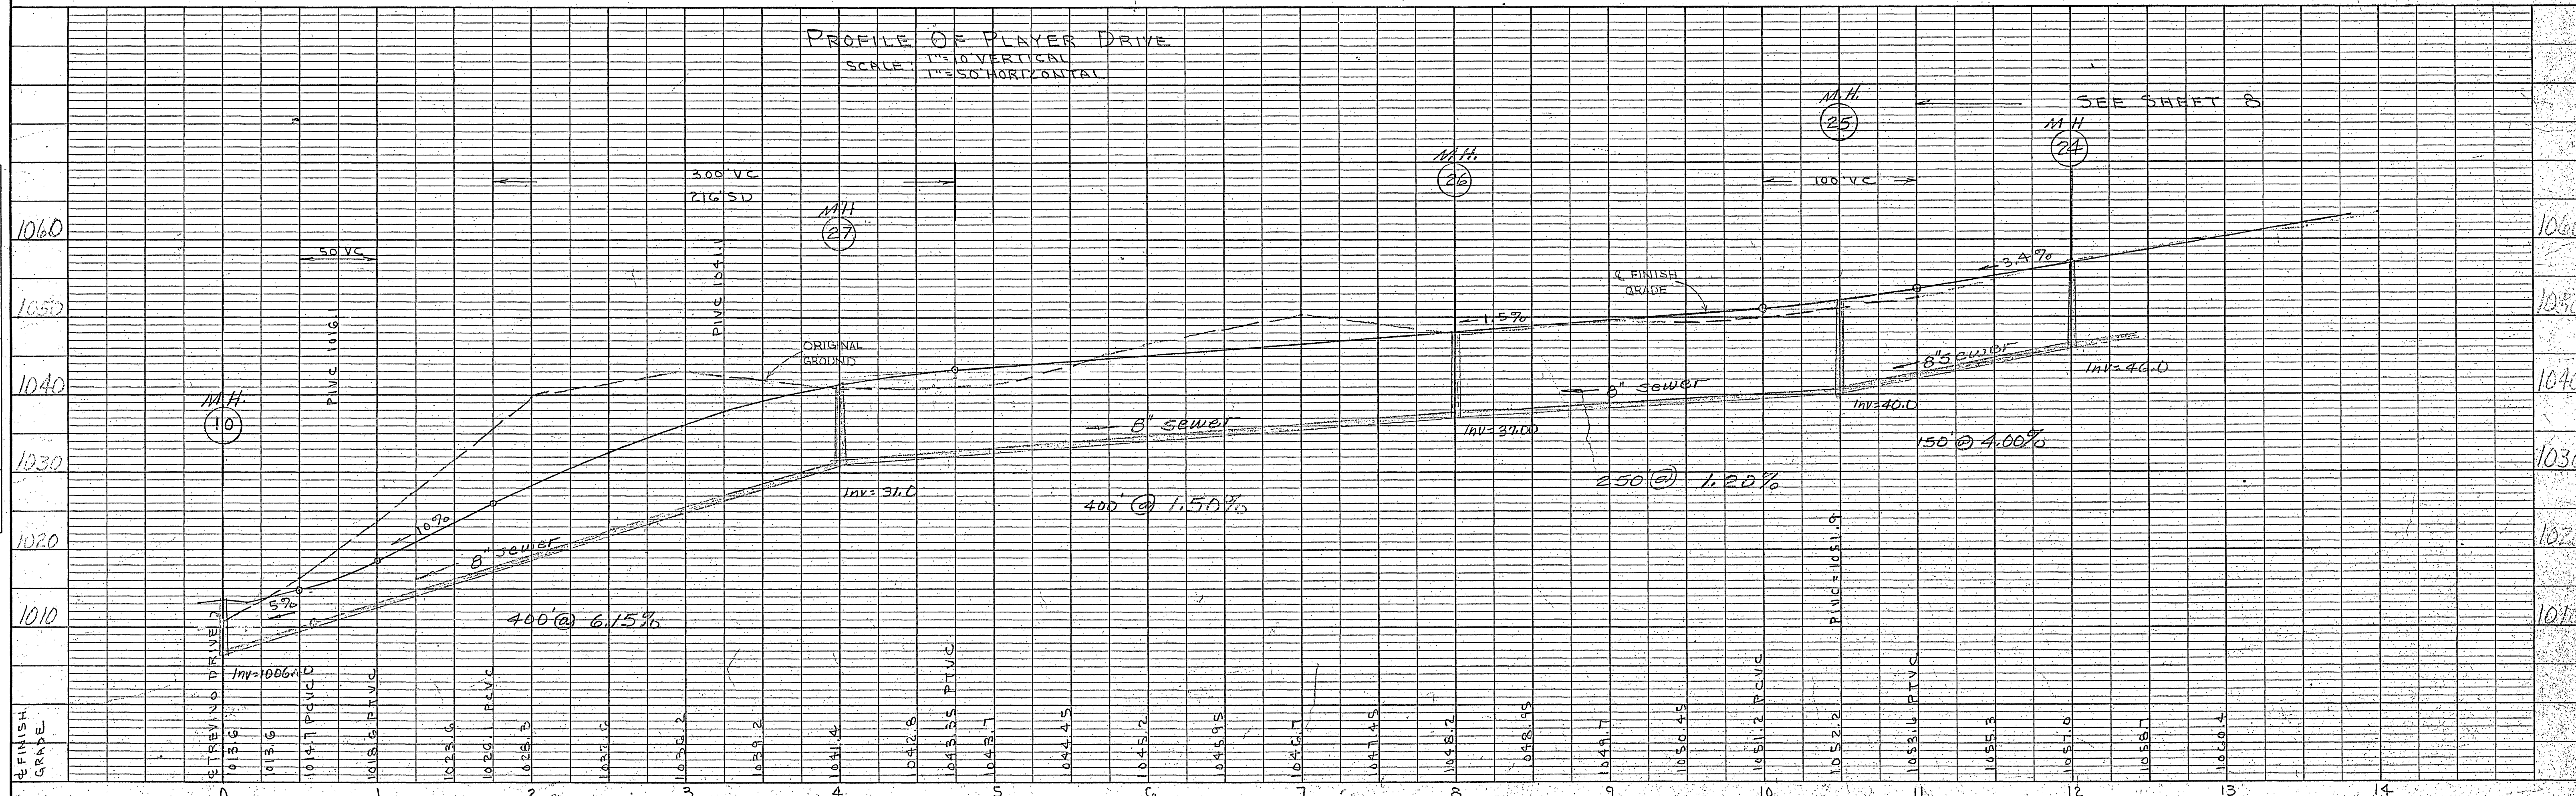

MONTEREY HILLS