


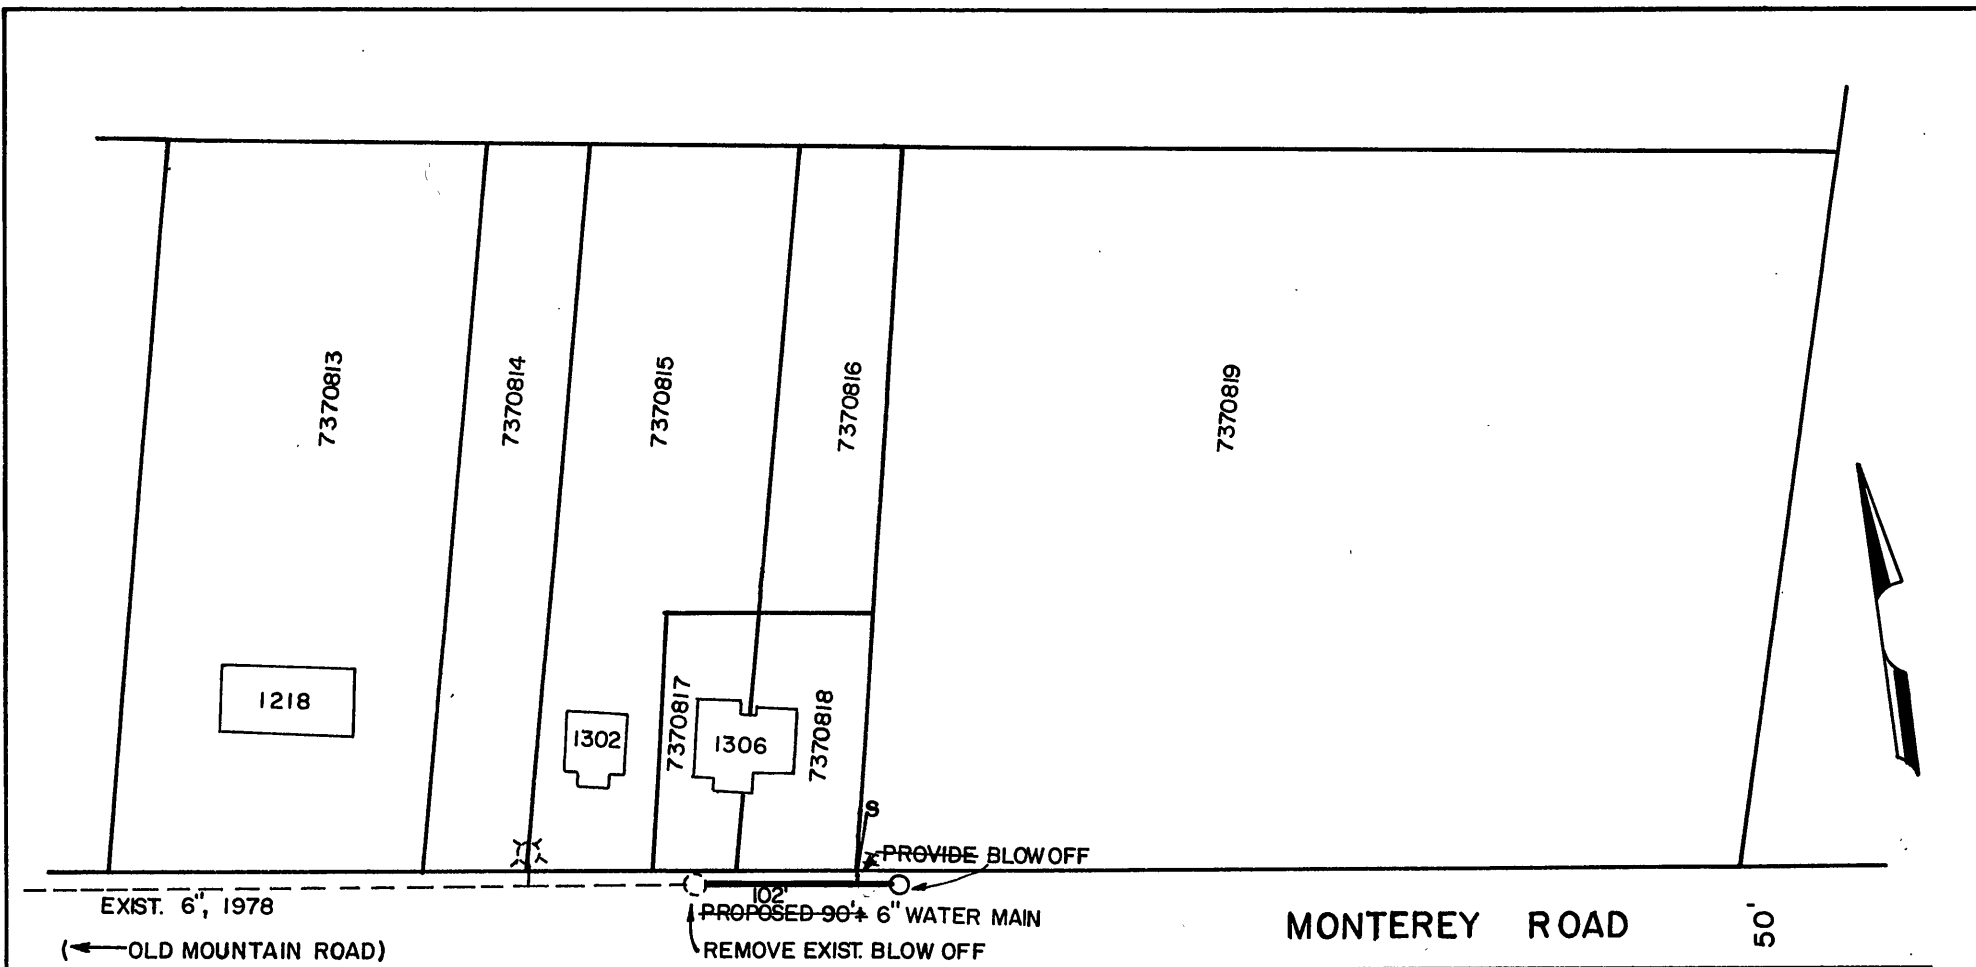

DATE STARTED 12-1-87				
DATE COMP. 12-8-87				
FEET MAIN	SIZE	VALVE	VAULT	BOX
102	6"	-	-	#2
BLOWOFF	2"	1	-	#1
F. H. COMP. 0				
F. H. STUB ONLY 0				
SERV. INS. BY: C. DAME				
MAIN INS. BY: C. DAME				
NO. 1/2" SERV. INS. 1				
CITY OR CO. CITY				
DEPT. INSP. U.L.S. - C. DAME				

NOTE: ALL EXIST. UTILITIES SHALL BE ASCERTAINED IN THE FIELD PRIOR TO CONSTRUCTION.

John H. Puley
MANAGER UTILITY LINE SERVICES

AS-BUILT	
WATER DEPARTMENT	
ROANOKE	VIRGINIA
MONTEREY ROAD, N.E.	
SCALE: 1" = 100'	<i>at B.L.</i> 11/4/87
DATE: 11-3-87	DIRECTOR UTILITIES & OPERATIONS DATE
DIST. MAP: 737	<i>William F. Clark</i> 11-5-87
PLAN NO.: 87-15	DIRECTOR OF PUBLIC WORKS DATE