



PLAN	DATE	BY	DATE	BY
DESIGNED				
PLOTTED				
CHECKED				
NOTED				
NO.				

PROFILE	DATE	BY	DATE	BY
DESIGNED				
PLOTTED				
CHECKED				
NOTED				
NO.				

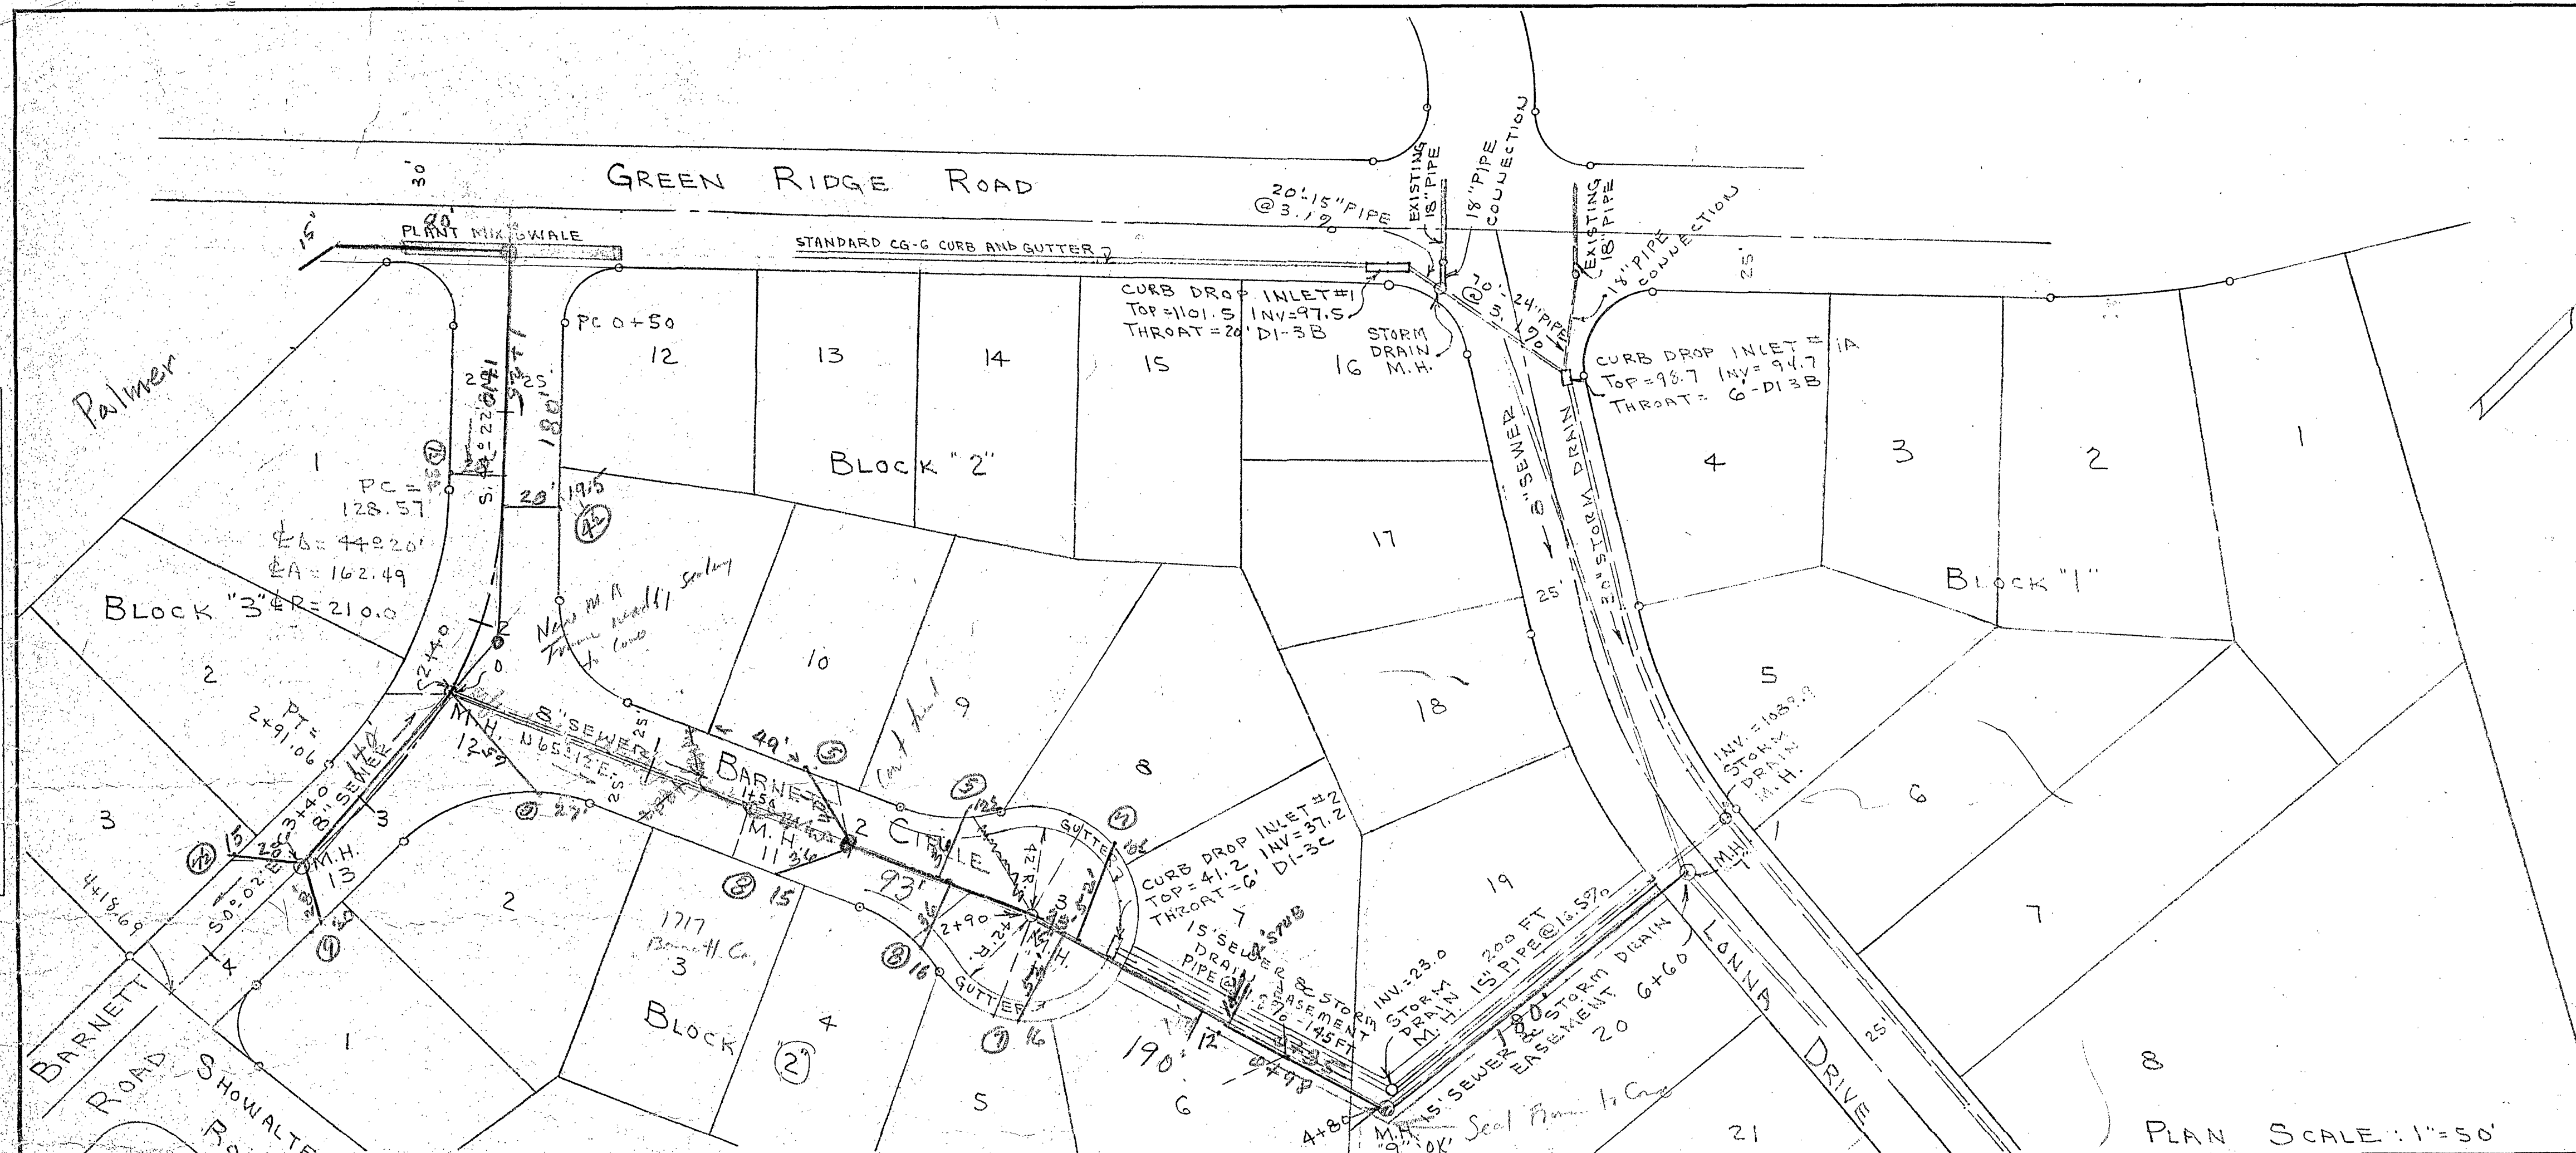

SEE SHEET 3 OF 3
FOR UTILITY NOTE &
APPROVALS.

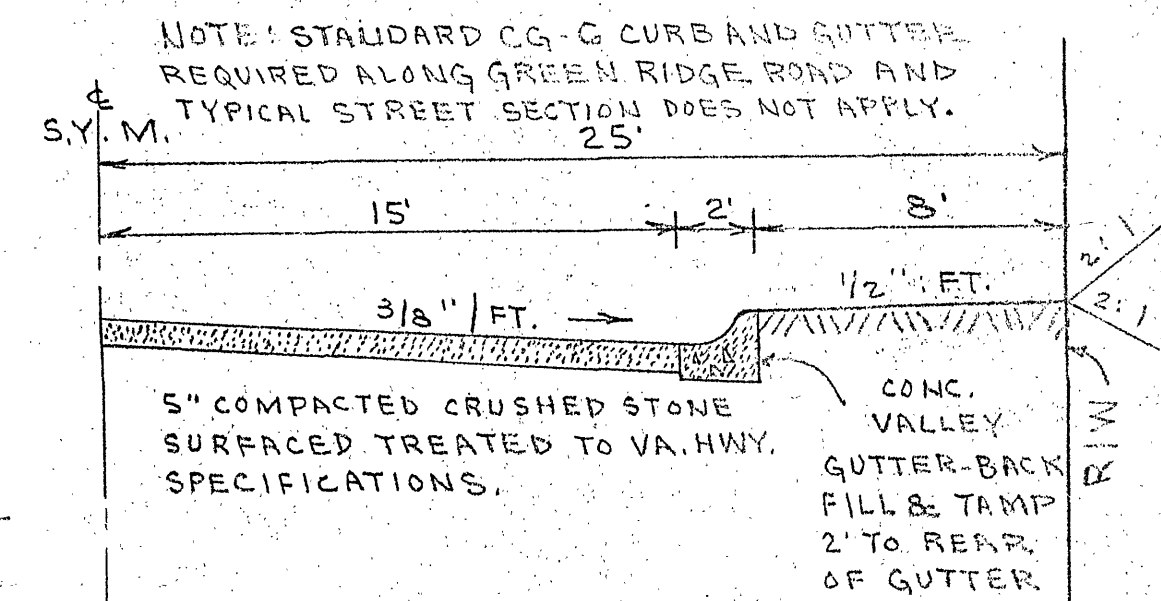

TYPICAL STREET SECTION

SHEET 1 OF 4
PLAN AND PROFILE OF
SECTION No. 1

MONTICELLO ESTATES

PROPERTY OF
PETER P. SLOVENSKY
ROANOKE COUNTY, VIRGINIA
SCALE: 1\"/>

BY: T. P. PARKER
STATE CERT. ENGR.

As-Built 07/06/1990

PLAN SCALE: 1\"/>

