


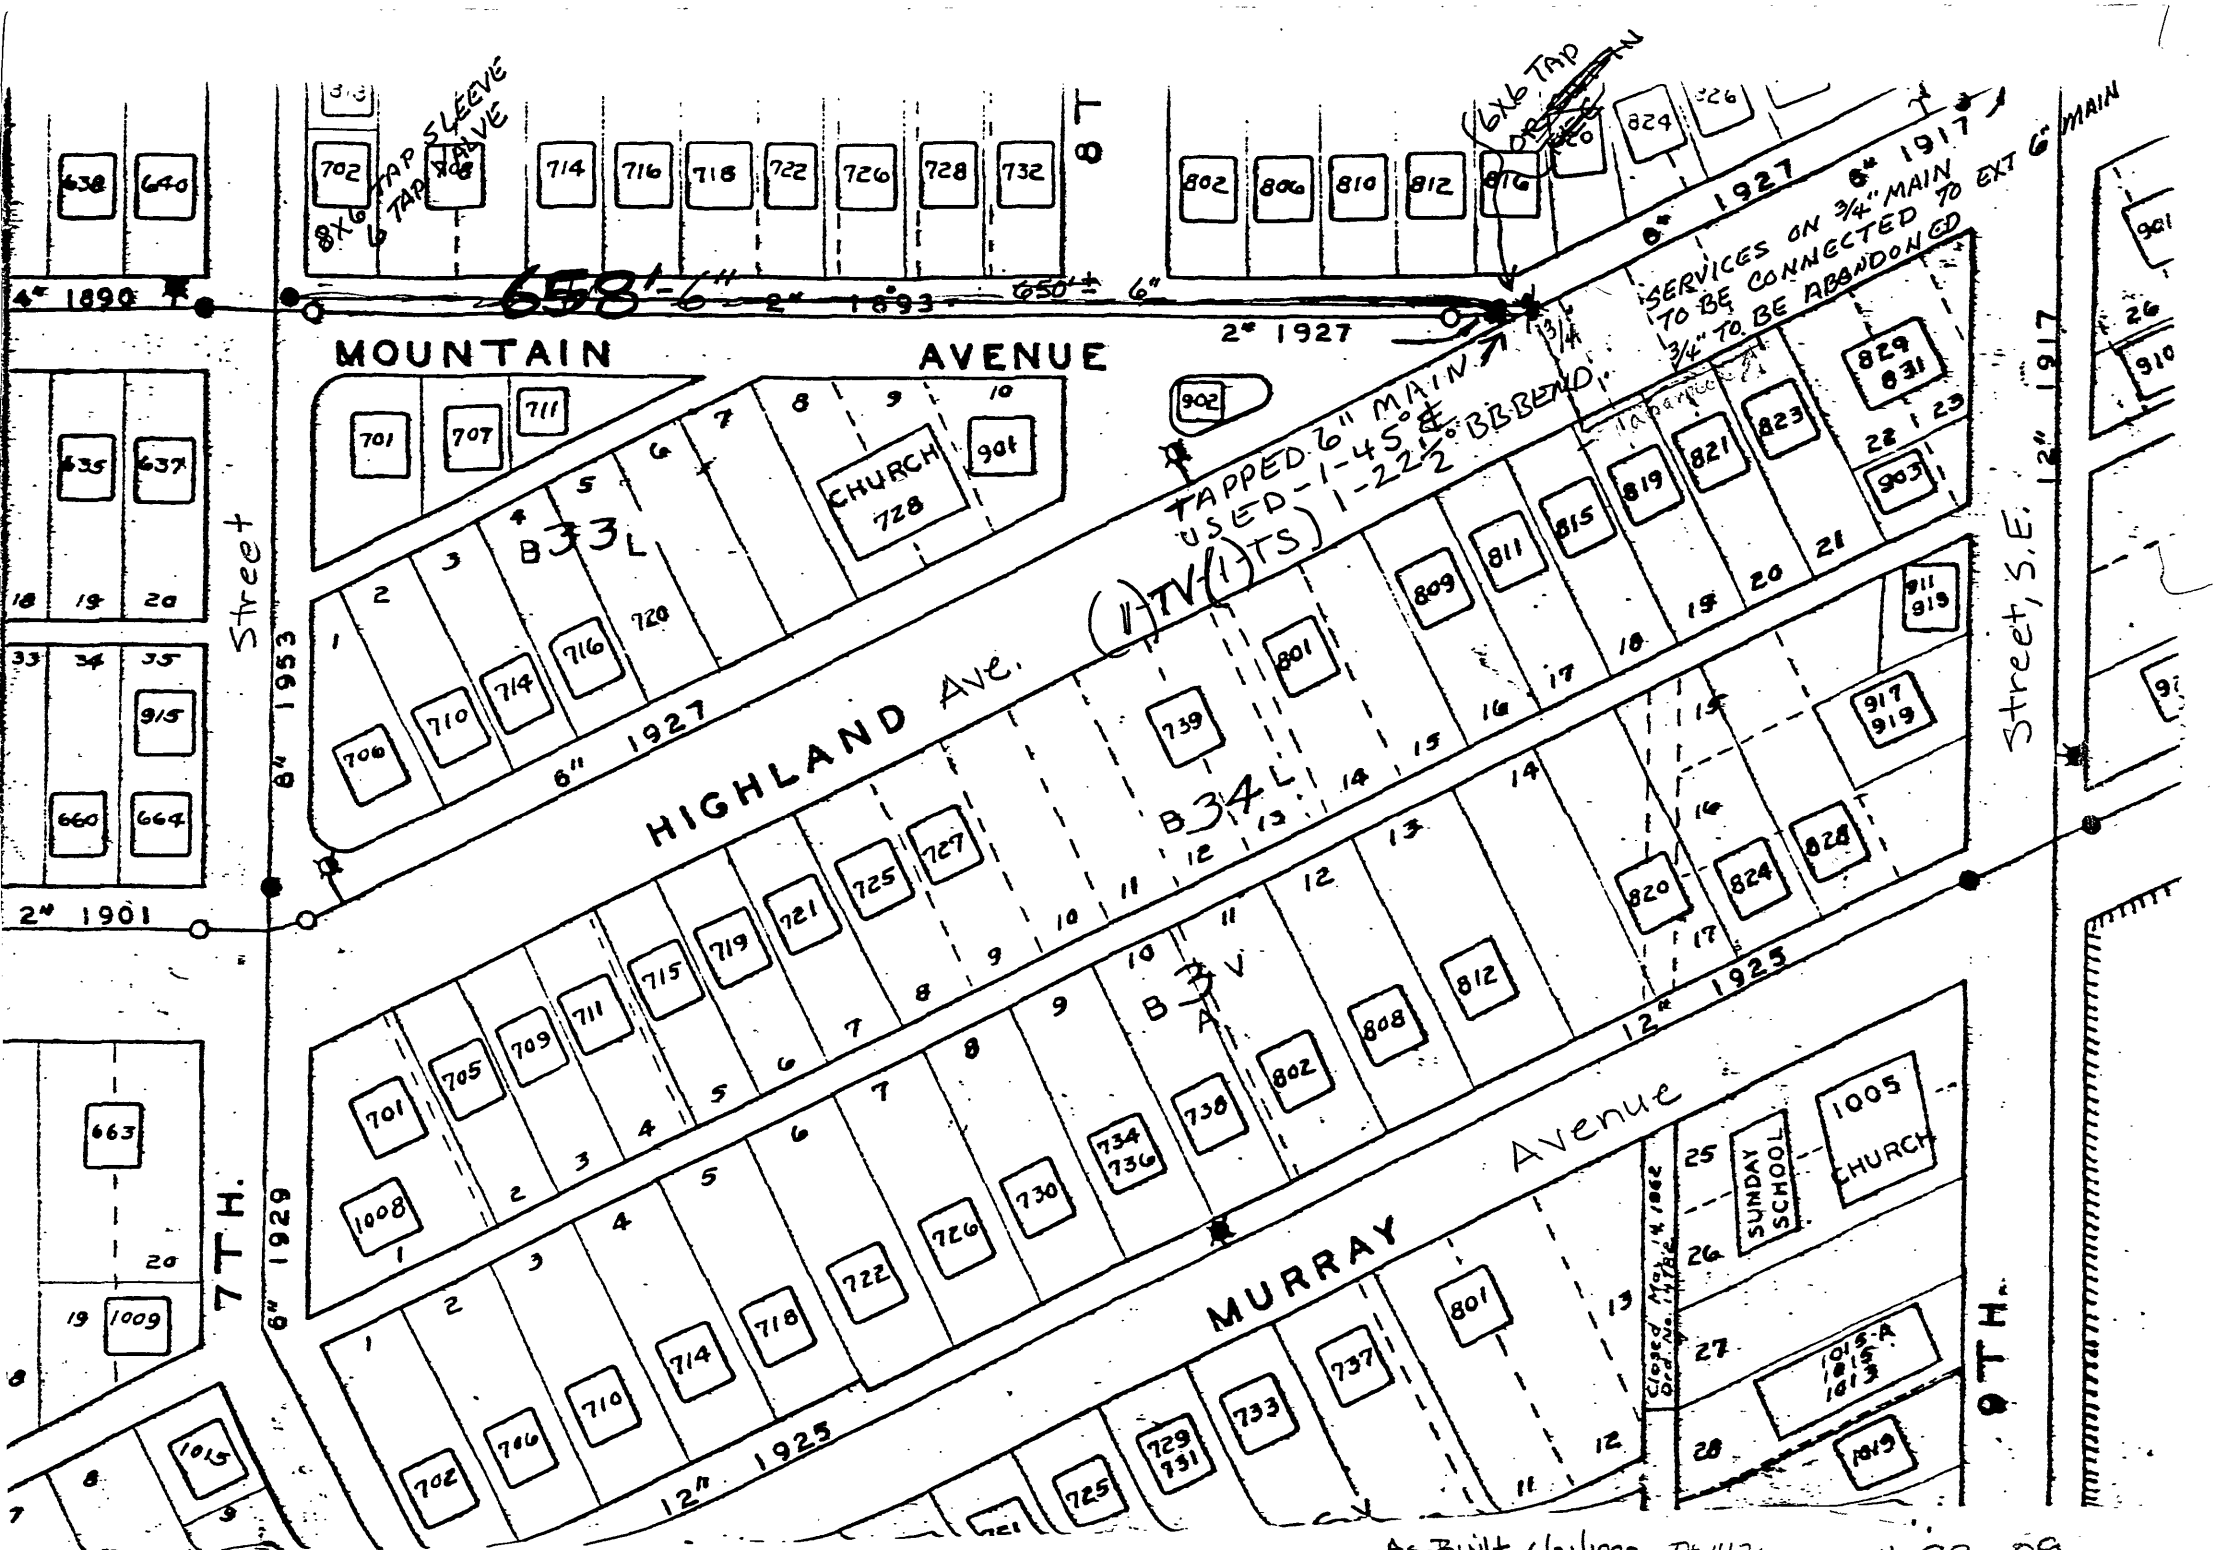

As-Built 6/21/1993 T# 412

#93-09
No drafted map