
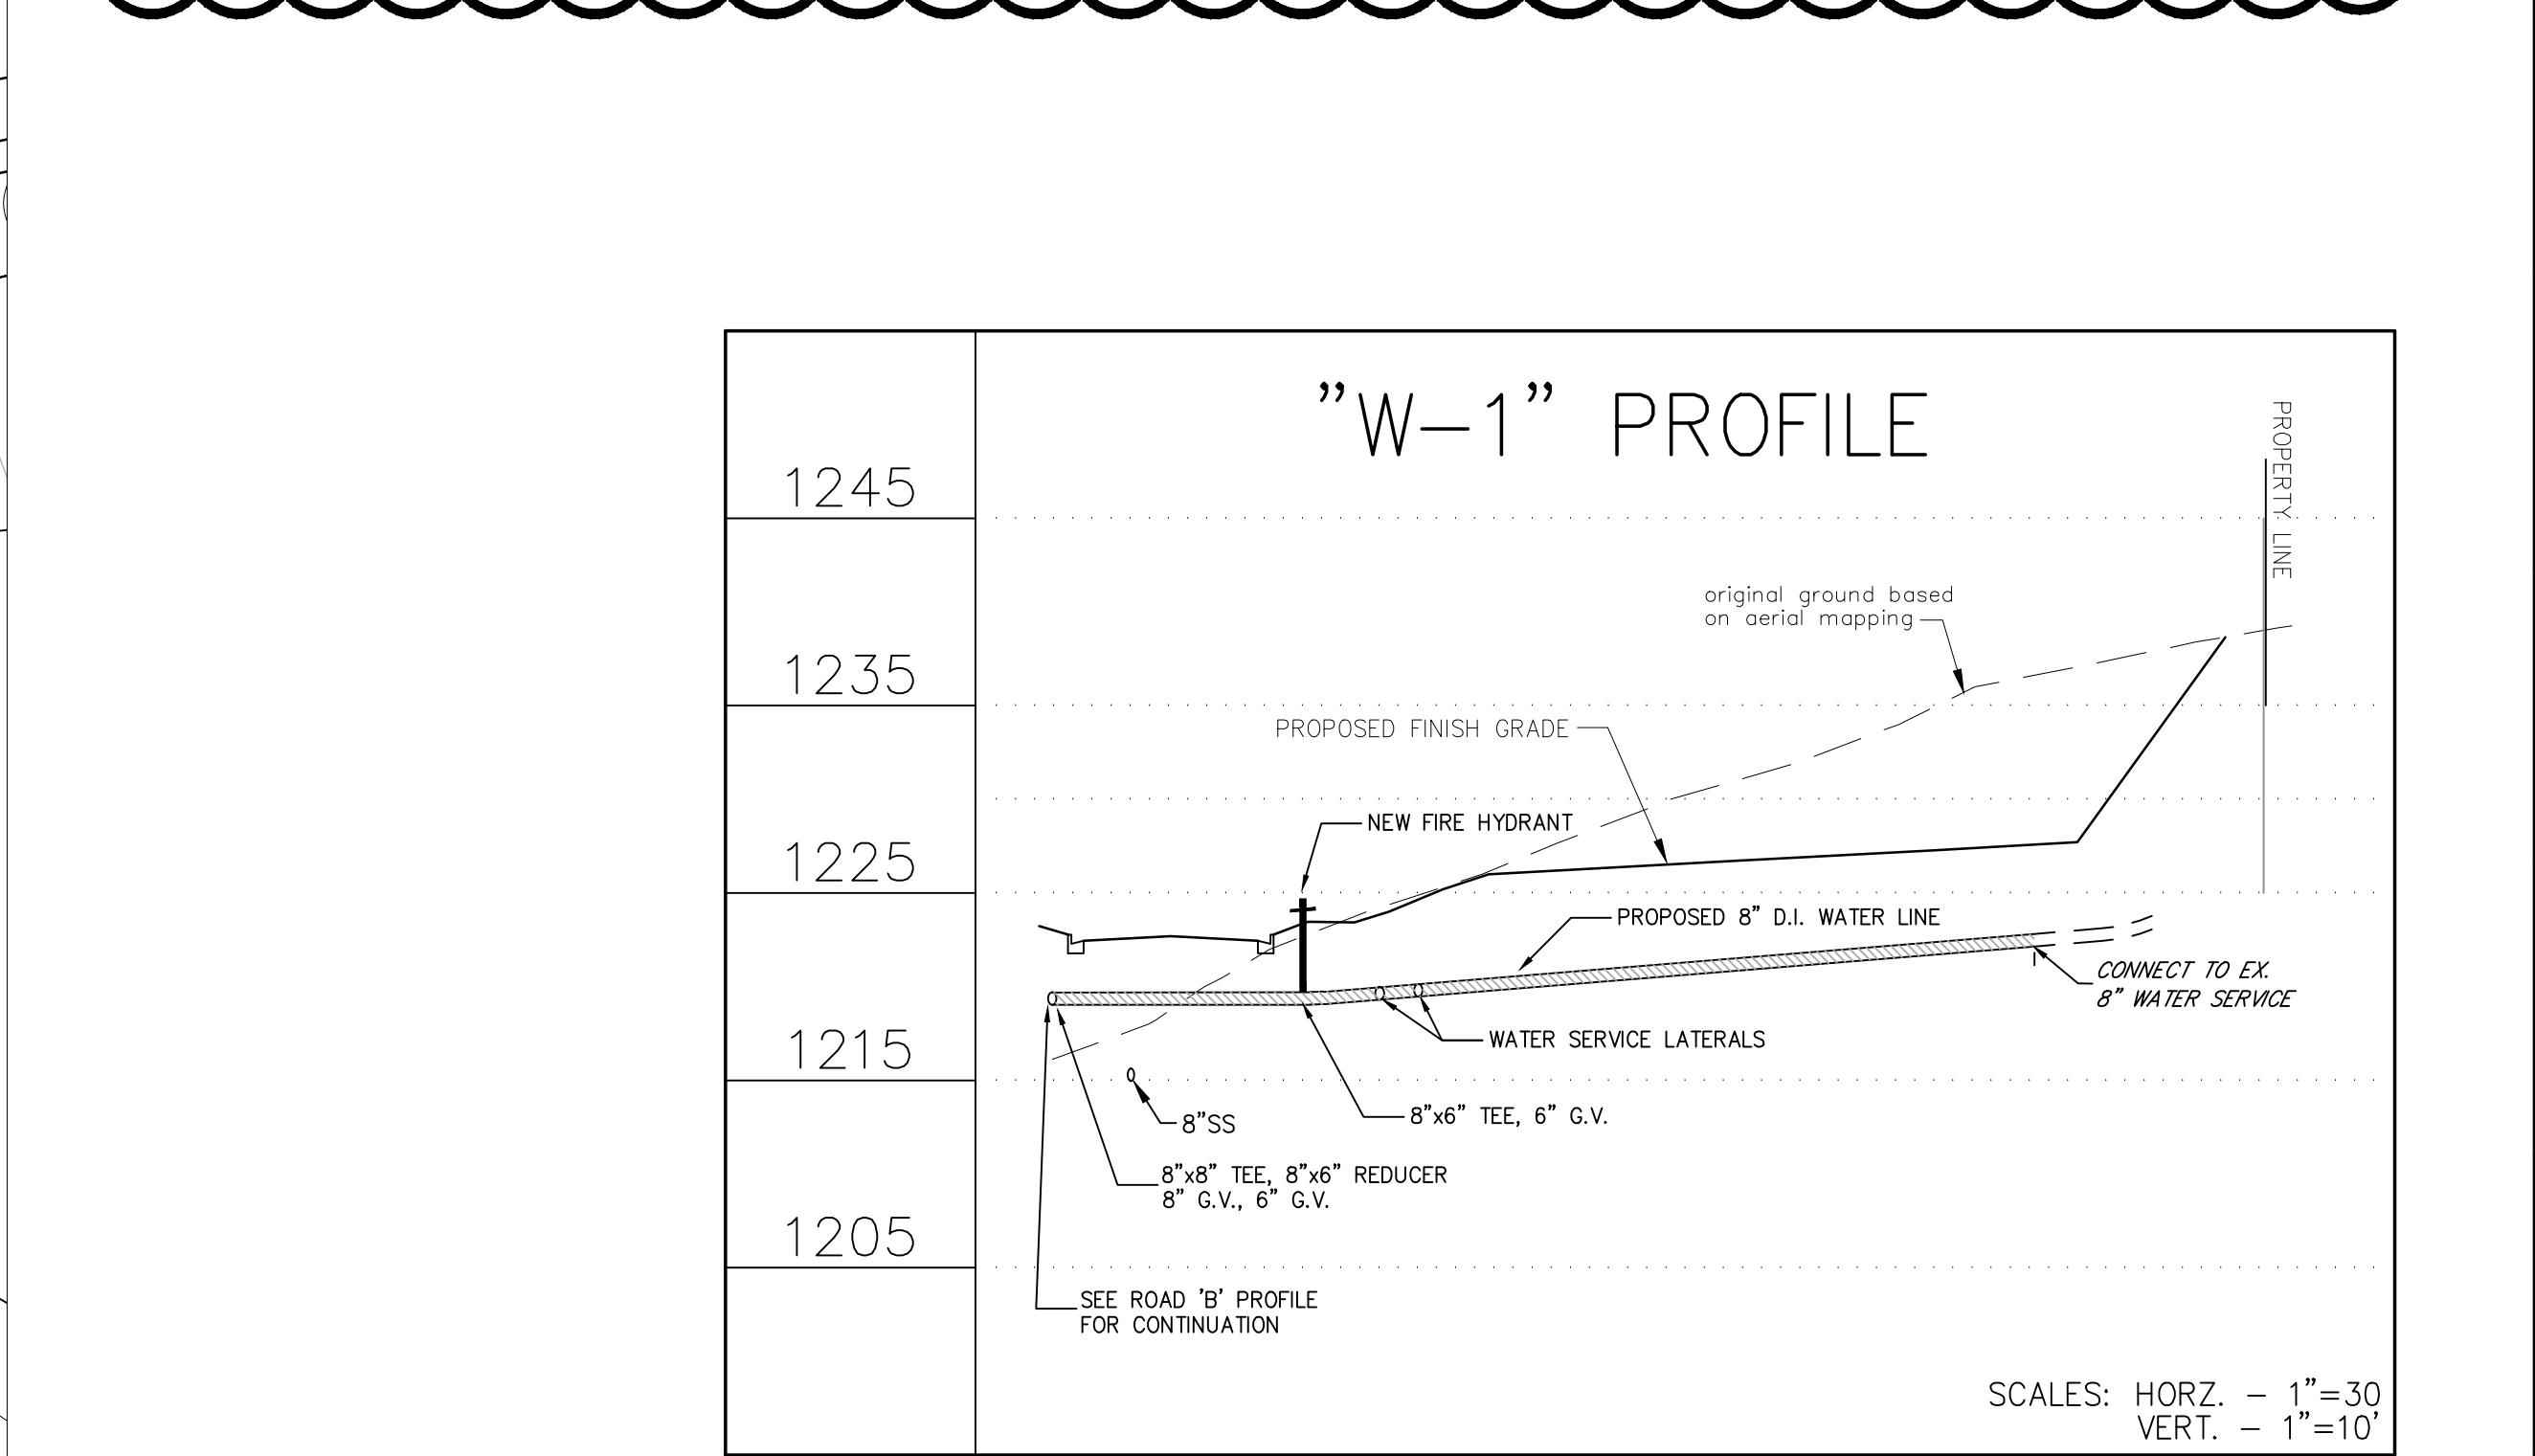


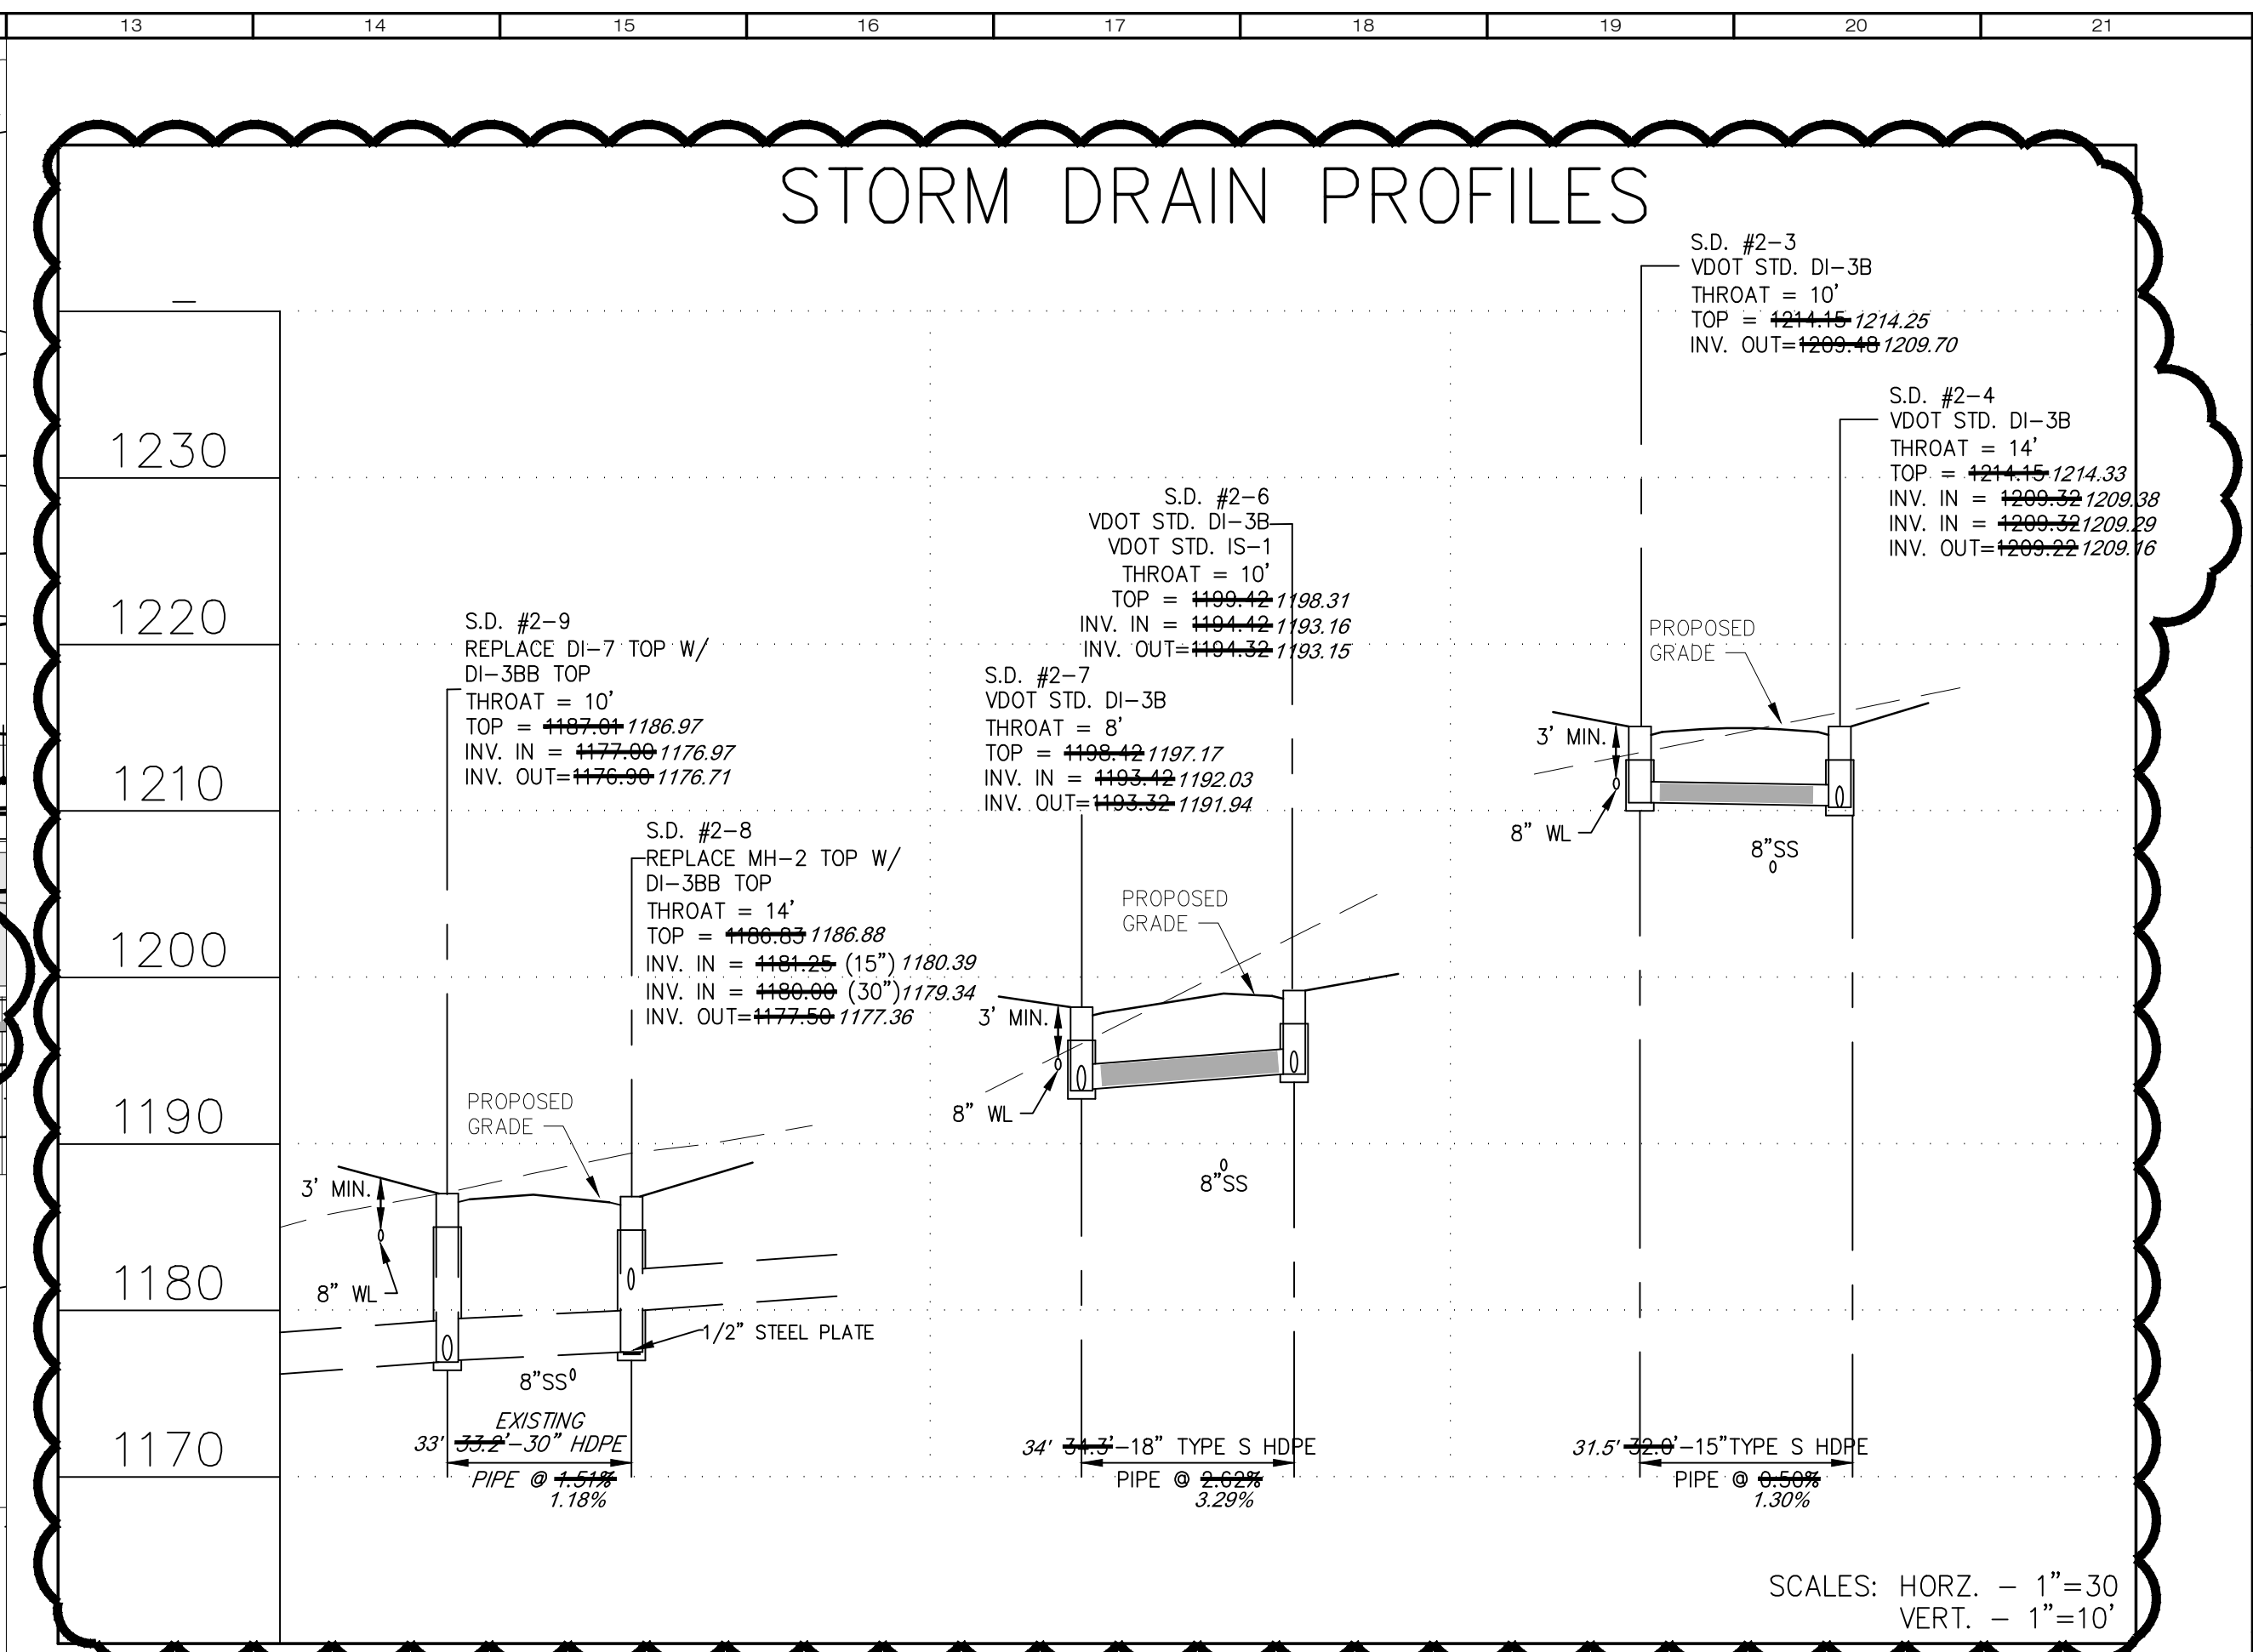

NOTE:
1. THE LOCATION OF THE PROPOSED RESIDENTIAL DWELLINGS ARE APPROXIMATE AND ARE PROVIDED ONLY AS TO SUGGEST THE TYPE OF UNIT (PATIO OR RANCH). BUILDING PERMIT PLOT PLANS ARE REQUIRED BY THE COUNTY OF ROANOKE, WHICH WILL PROVIDE THE EXACT SIZE, FINISH FLOOR ELEVATION AND GRADES NECESSARY TO PROVIDE POSITIVE DRAINAGE AWAY FROM THE DWELLING AND DRIVEWAY LOCATIONS.
2. ROOF LEADERS FROM LOTS 42 THROUGH 60 SHALL NOT DRAIN TOWARDS THE PROPOSED ROAD.

AS-BUILT DRAWING NOTE:
AS-BUILT DRAWING FOR STORM SEWER AS-BUILT PURPOSES ONLY. NO OTHER IMPROVEMENTS WERE AS-BUILT OR INDICATED AS SUCH ON THE SUBJECT PLAN SET.

SCALE: 1"=30'

SHEET NO.

AS-BUILT
JOB NO. R0600065.01

BALZER AND ASSOCIATES, INC.
REFLECTING TOMORROW
www.balzer.cc
PLANNERS • ARCHITECTS
ENGINEERS • SURVEYORS

1208 Corporate Circle
Roanoke, Virginia 24018
Phone: 540/772-9580
FAX: 540/772-8050

15871 City View Drive, Suite 200
Midlothian, Virginia 23113
Phone: 804/794-0571
FAX: 804/794-2635

880 Technology Park Drive
Suite 200
Glenn Allen, Virginia 23059
Phone: 804/653-0132
FAX: 804/653-0133

448 Peppers Ferry Road, NW
Christiansburg, Virginia 24073
Phone: 540/381-4290
FAX: 540/381-4291

1561 Commerce Road
Suite 401
Verona, Virginia 24482
Phone: 540/248-3220
FAX: 540/248-3221


BELMONT
SECTION 2
STORM SEWER AS-BUILT PLAN
ROANOKE COUNTY, VIRGINIA

DRAWN BY: EJP
DESIGNED BY: CPB
CHECKED BY: CPB
DATE: 8/7/2020
REVISIONS:


SCALE: 1"=30'

SHEET NO.

AS-BUILT
JOB NO. R0600065.01

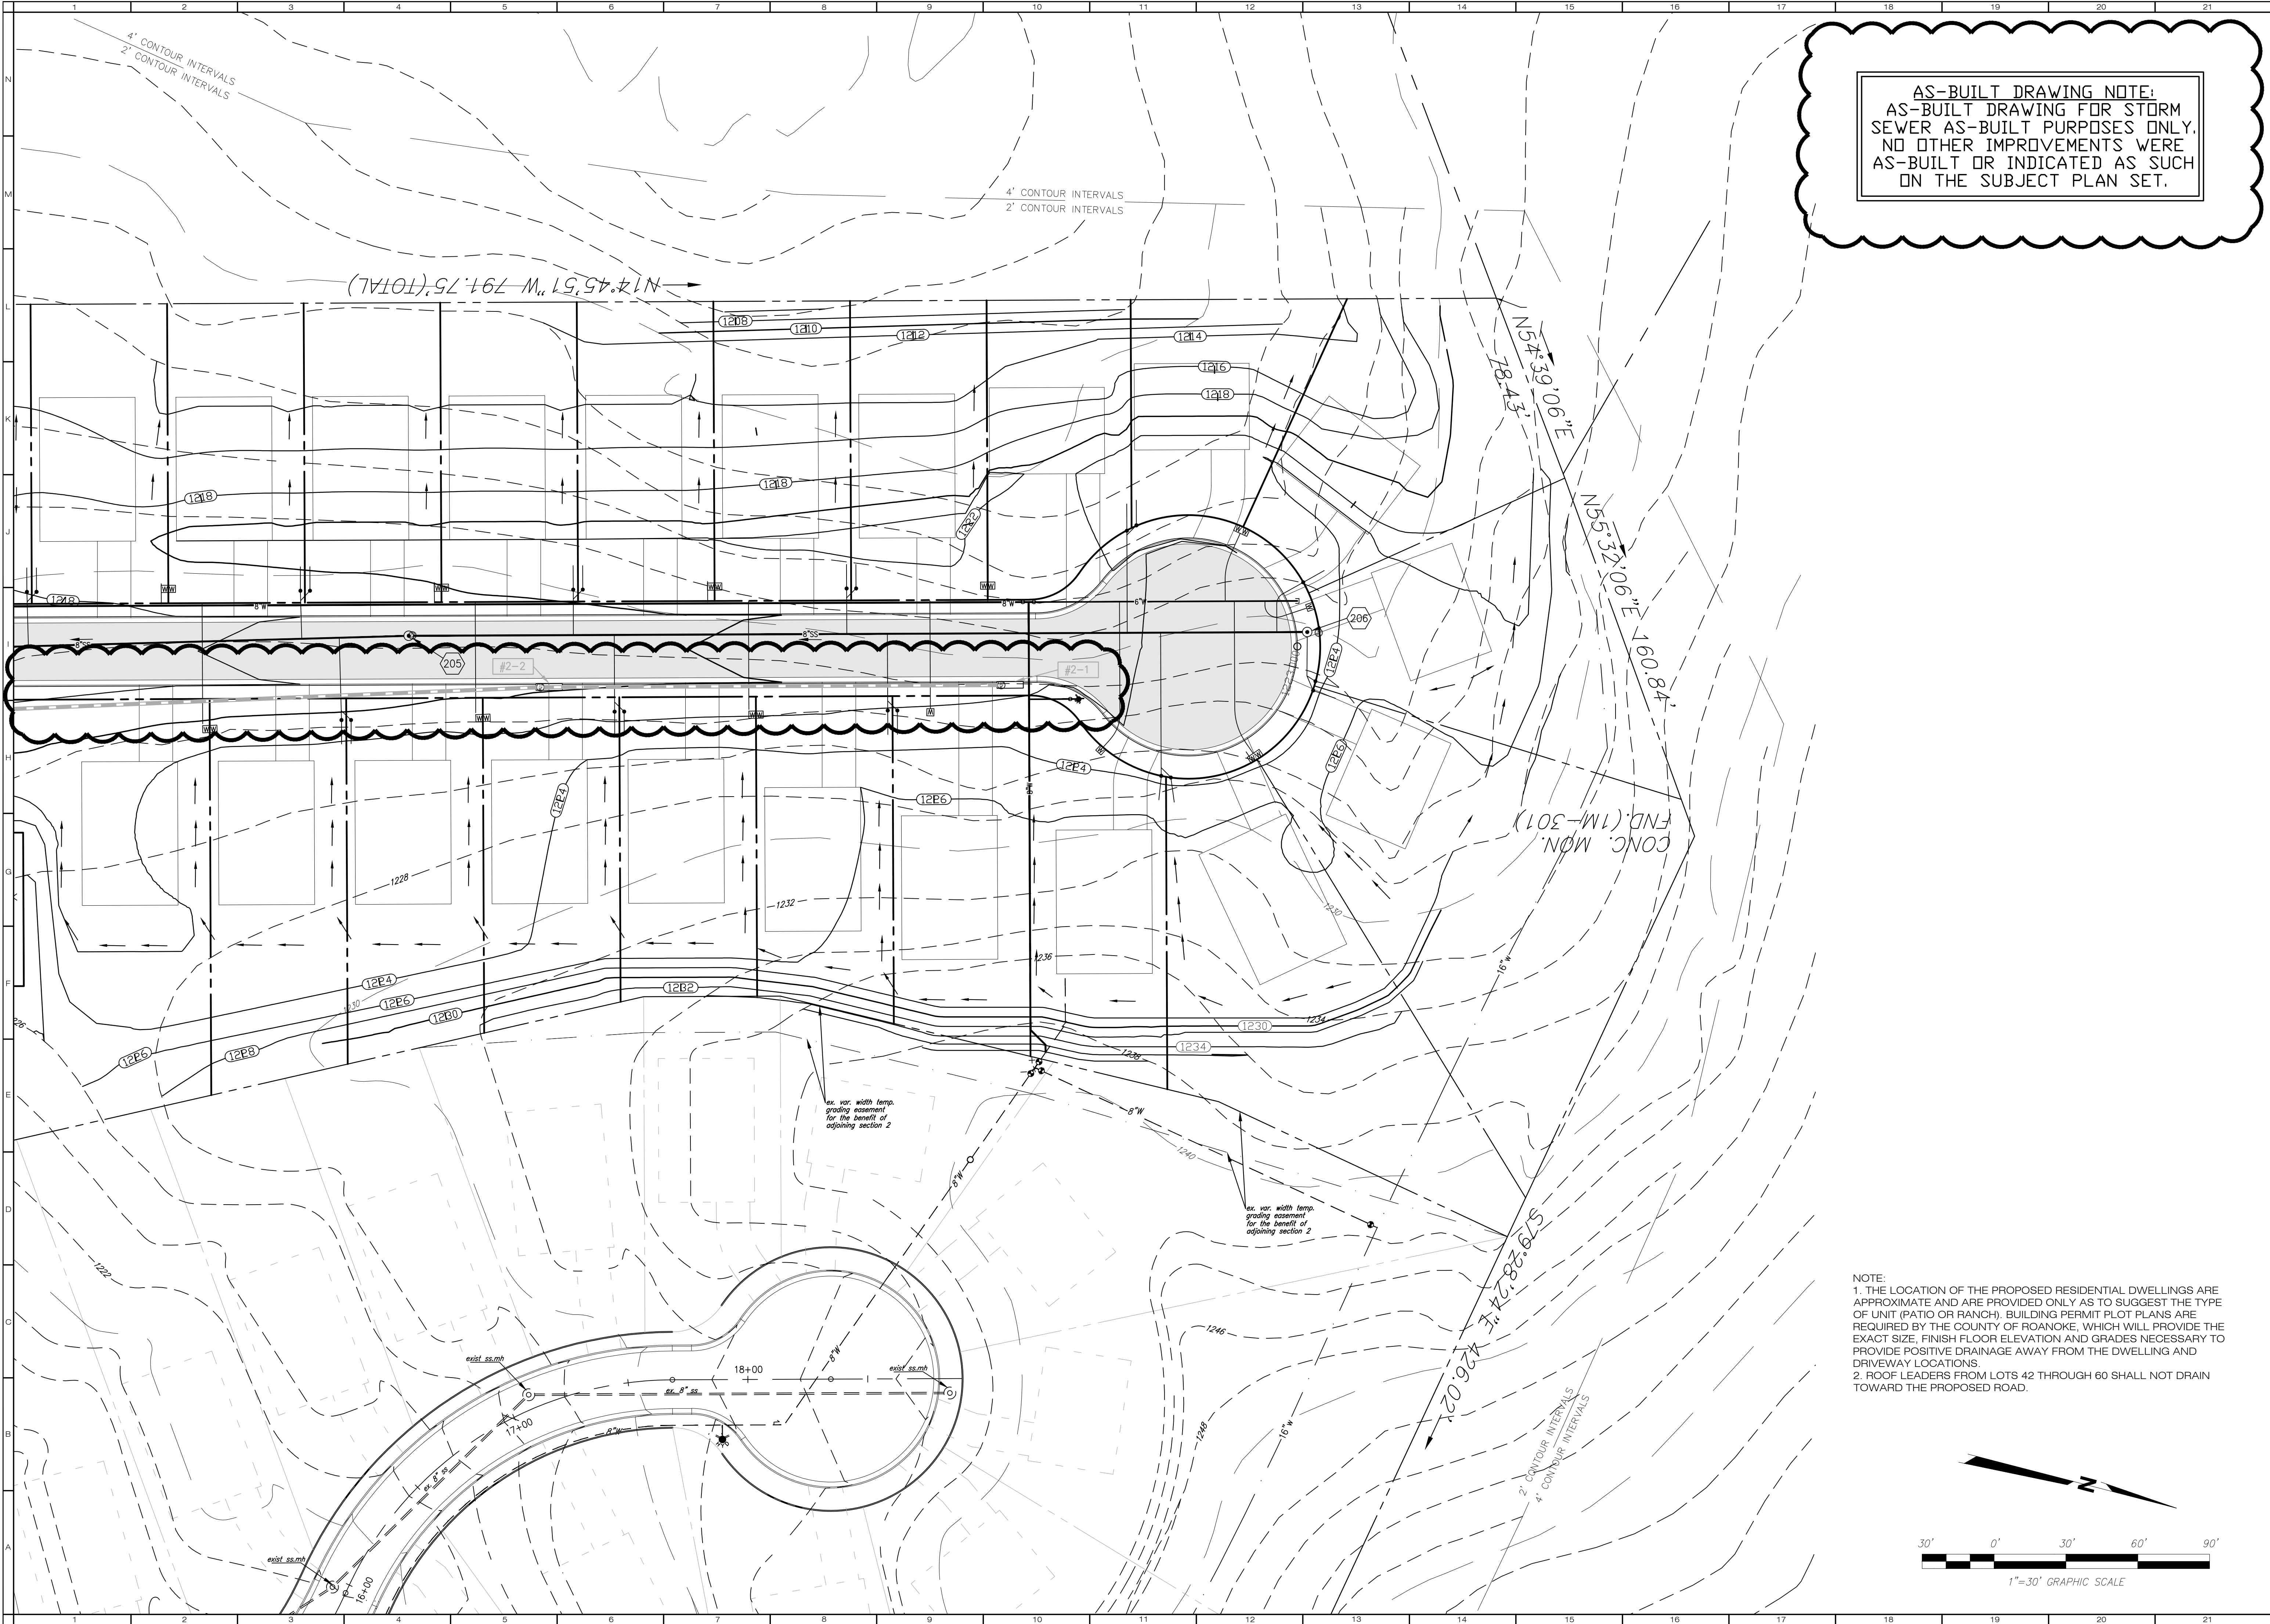

AS-BUILT DRAWING NOTE:
AS-BUILT DRAWING FOR STORM
SEWER AS-BUILT PURPOSES ONLY.
NO OTHER IMPROVEMENTS WERE
AS-BUILT OR INDICATED AS SUCH
ON THE SUBJECT PLAN SET.

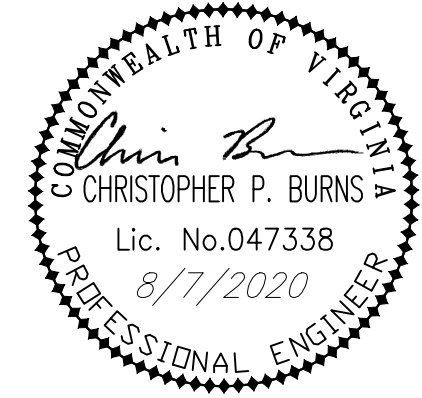

REFLECTING TOMORROW
www.balzer.cc
PLANNERS • ARCHITECTS
ENGINEERS • SURVEYORS

1208 Corporate Circle
Roanoke, Virginia 24018
Phone: 540/772-9580
FAX: 540/772-8050

15871 City View Drive, Suite 200
Midlothian, Virginia 23113
Phone: 804/794-0571
FAX: 804/794-2635

880 Technology Park Drive
Suite 200
Glenn Allen, Virginia 23059
Phone: 804/653-0132
FAX: 804/653-0133

448 Peppers Ferry Road, NW
Christiansburg, Virginia 24073
Phone: 540/381-4290
FAX: 540/381-4291

1561 Commerce Road
Suite 401
Verona, Virginia 24482
Phone: 540/248-3220
FAX: 540/248-3221

BELMONT
SECTION 2
STORM SEWER AS-BUILT PLAN
ROANOKE COUNTY, VIRGINIA

DRAWN BY: EJP
DESIGNED BY: CPB
CHECKED BY: CPB
DATE: 8/7/2020
REVISIONS:

SCALE: 1"=30'
SHEET NO.

AS-BUILT
JOB NO.
R0600065.01

