
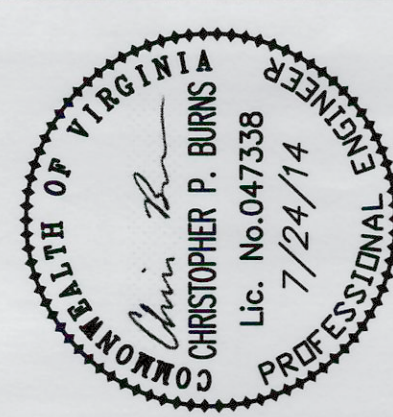
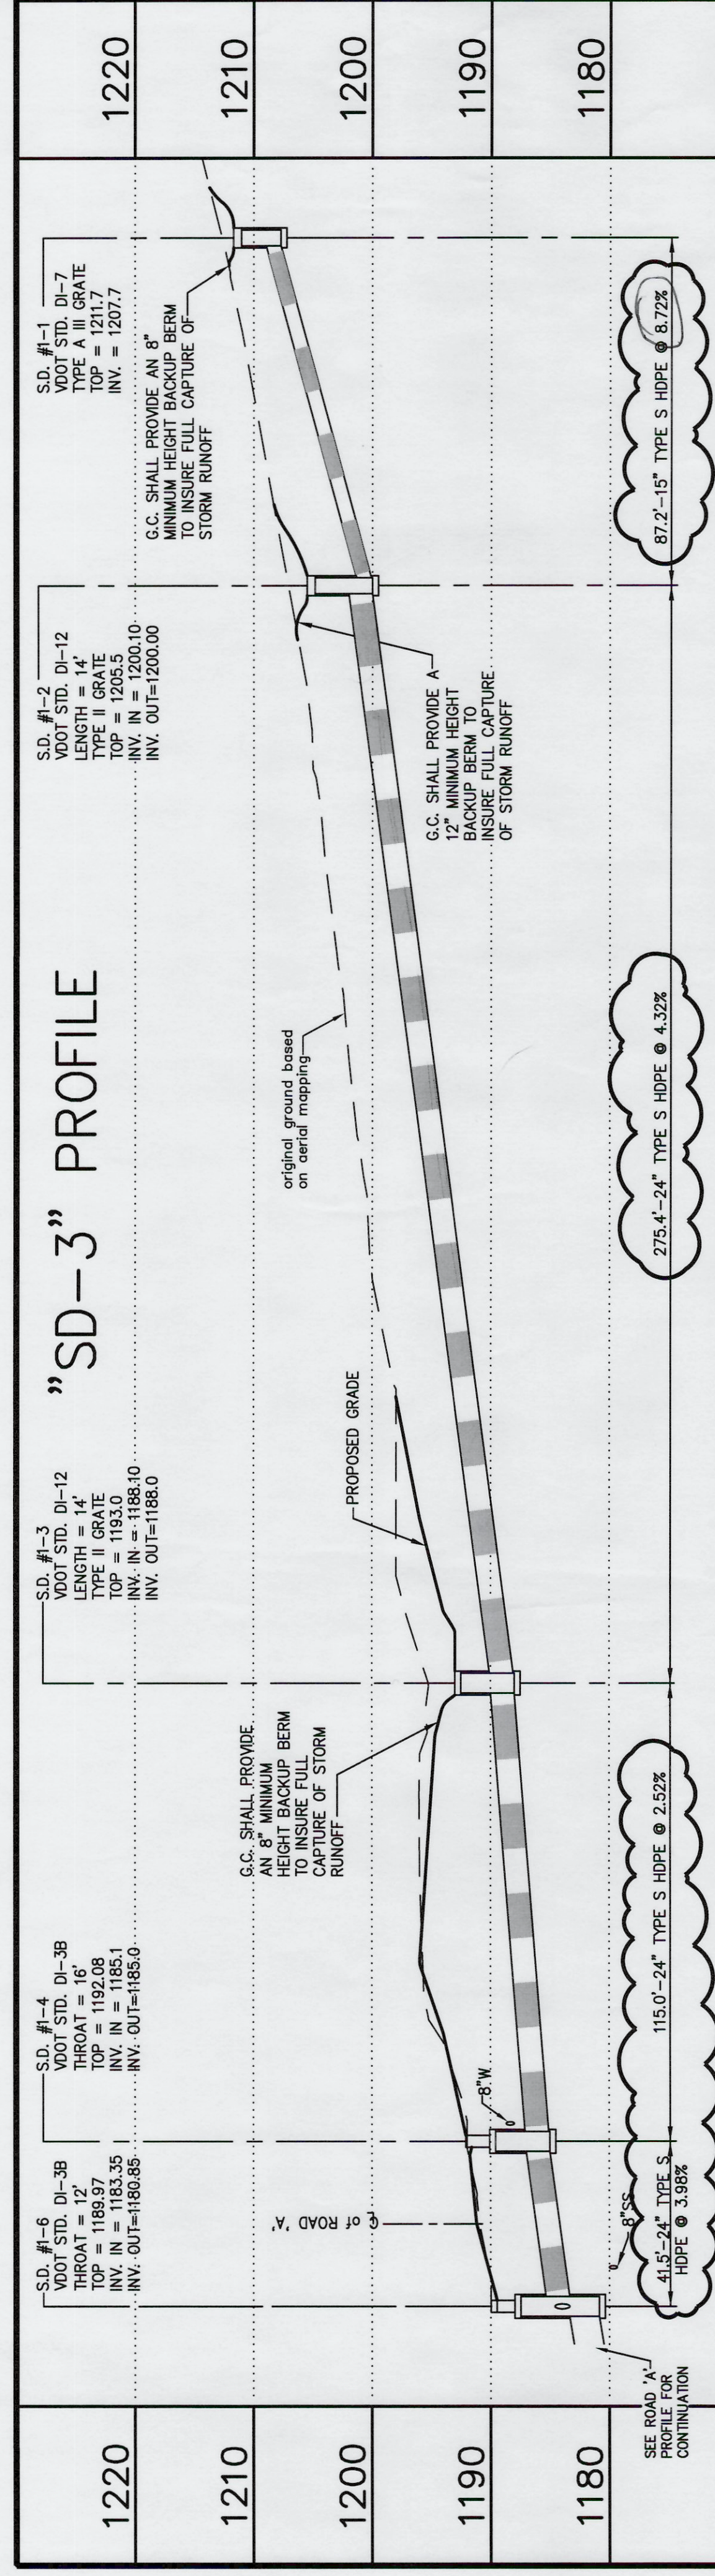
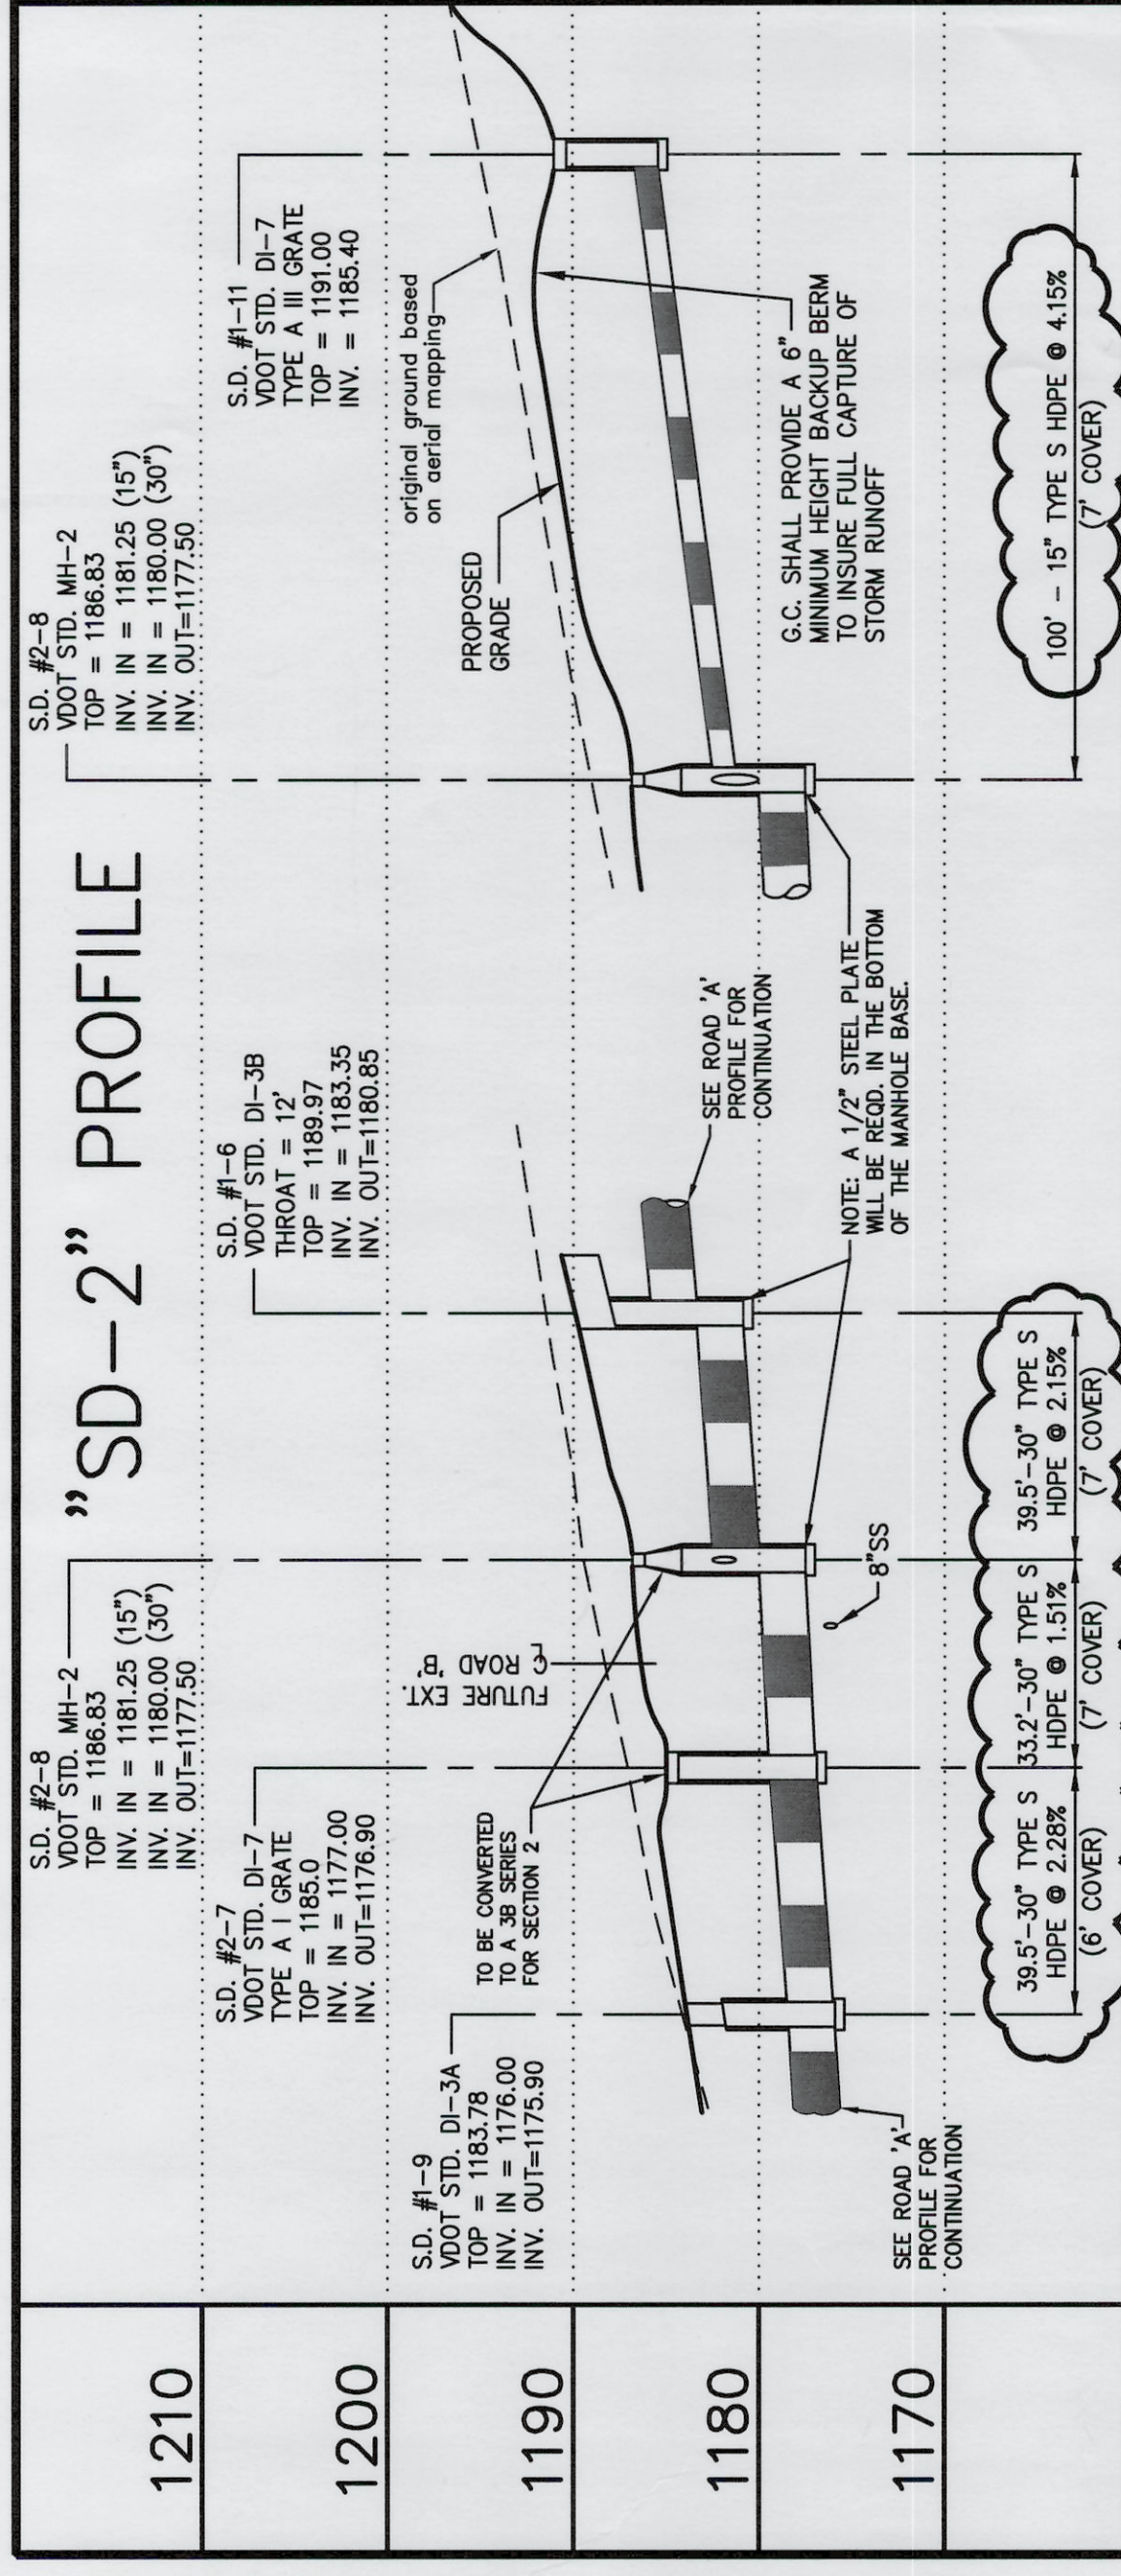
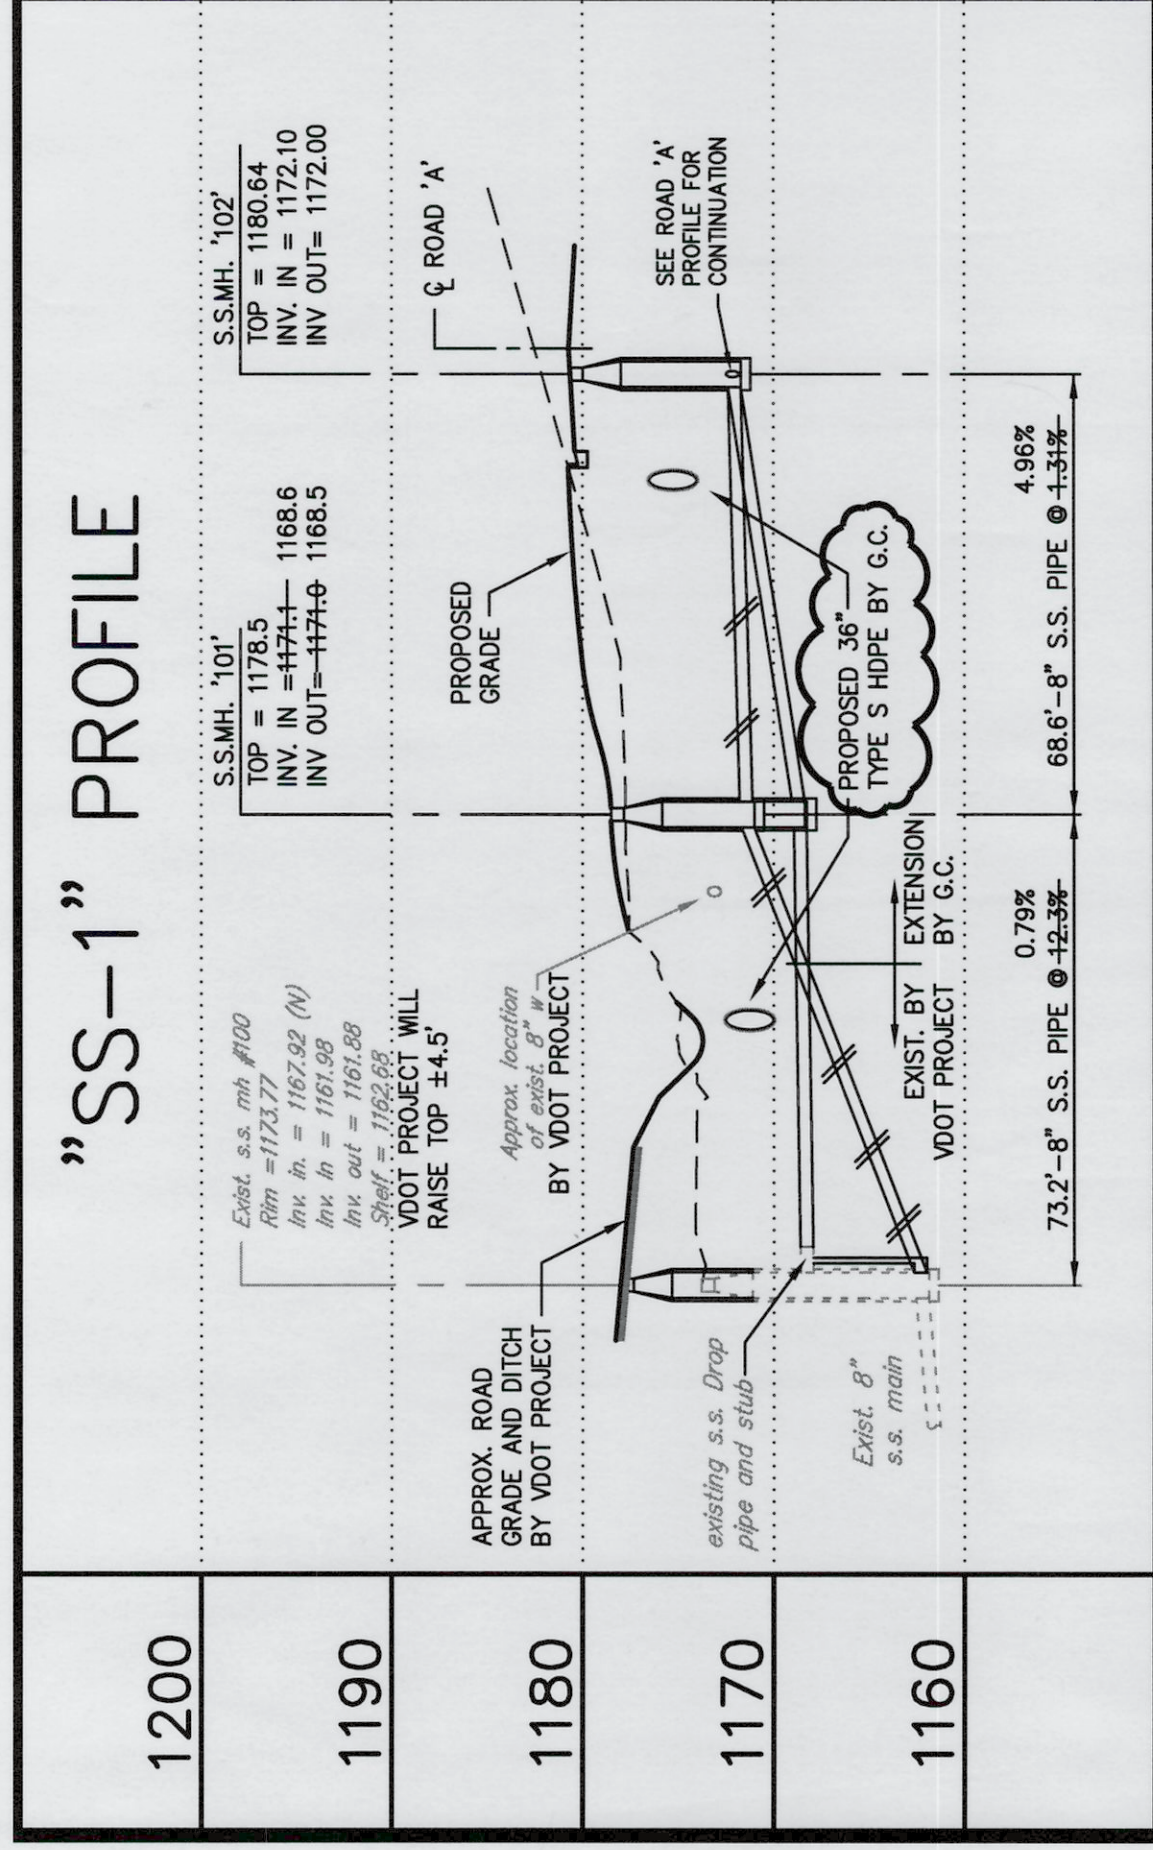
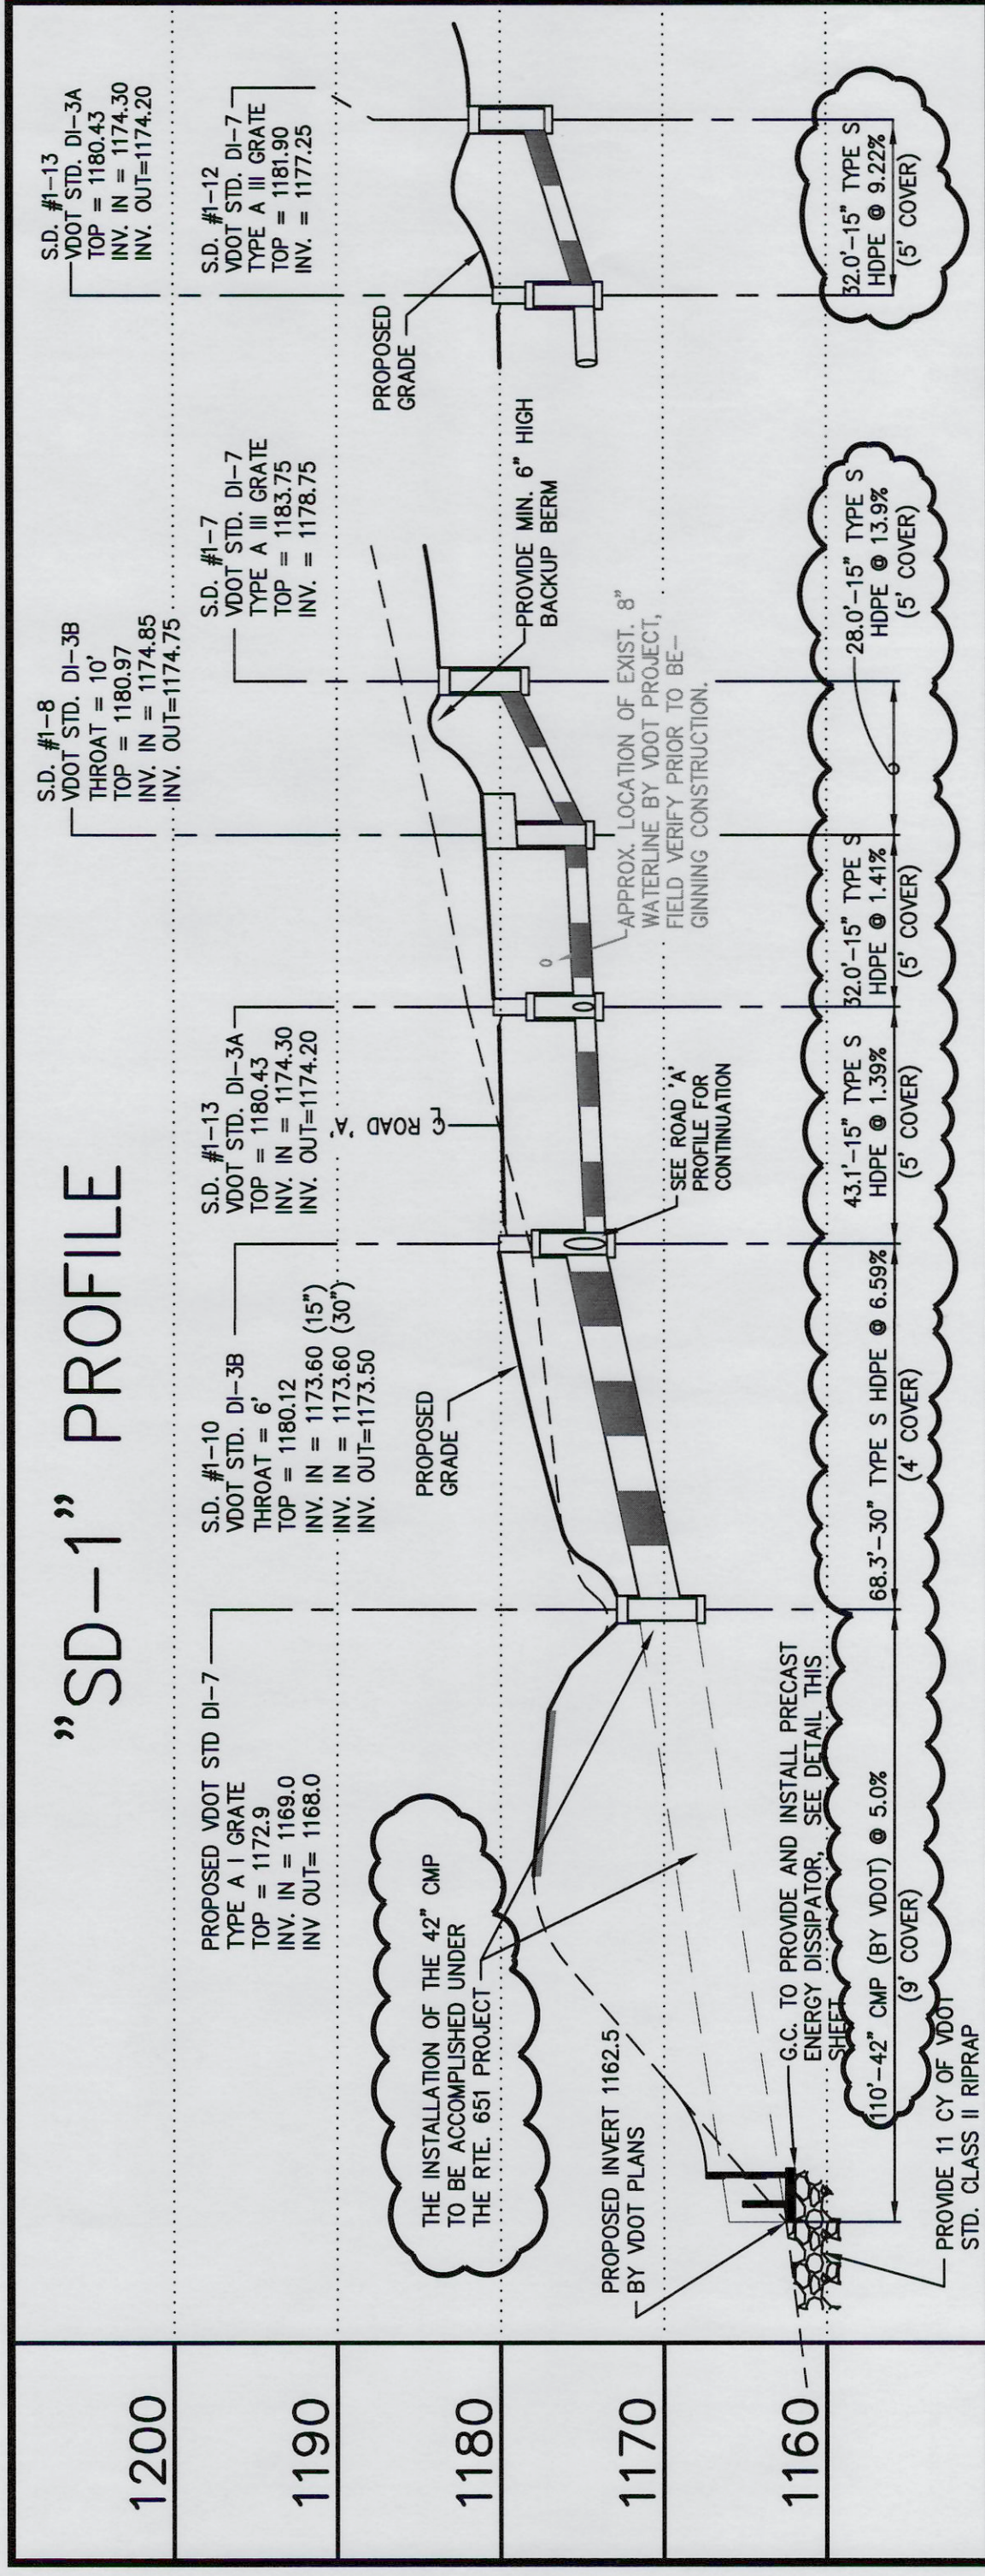


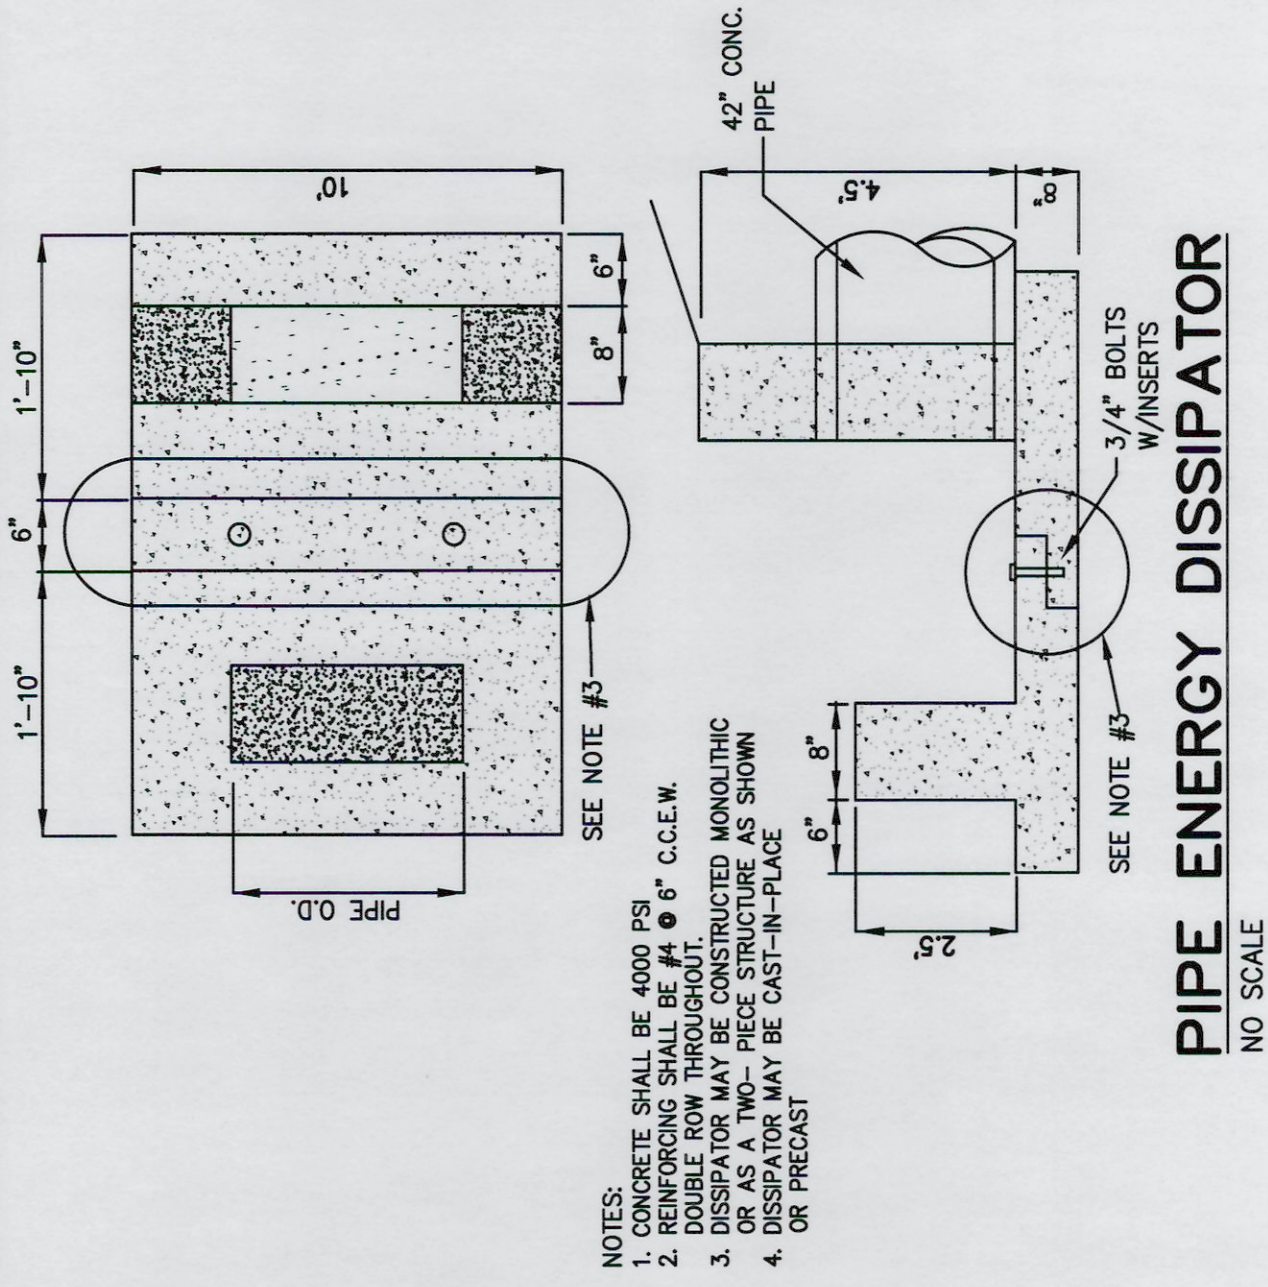

1208 Corporate Circle
Roanoke, Virginia 24018
Phone: 540/772-5580
FAX: 540/772-8059

501 Branchway Road
Roanoke, Virginia 24060
Phone: 540/794-0971
FAX: 540/794-2630

801 Technology Park Drive
Suite 200
Roanoke, Virginia 24099
Phone: 540/593-0138
FAX: 540/593-0138

448 Poplars Ferry Road, NW
Chatham, Virginia 24603
Phone: 540/881-4428
FAX: 540/881-4428

1567 Commerce Road
Roanoke, Virginia 24060
Phone: 540/246-3292
FAX: 540/246-3221

MOUNTAIN VIEW
SUBDIVISION
UTILITY PROFILES
ROANOKE COUNTY, VIRGINIA

DRAWN BY: J.V.J.
DESIGNED BY: J.V.J.
CHECKED BY: SMH
DATE: 05/09/2006

REVISIONS:
10/09/06 - PER 1ST REVIEW COMMENTS
01/19/07 - PER 2ND REVIEW COMMENTS
05/29/08 - CHANGES
01/23/2014
07/24/2014

SCALE: AS SHOWN
SHEET NO.

C-8
JOB NO.
R0600065.00

