


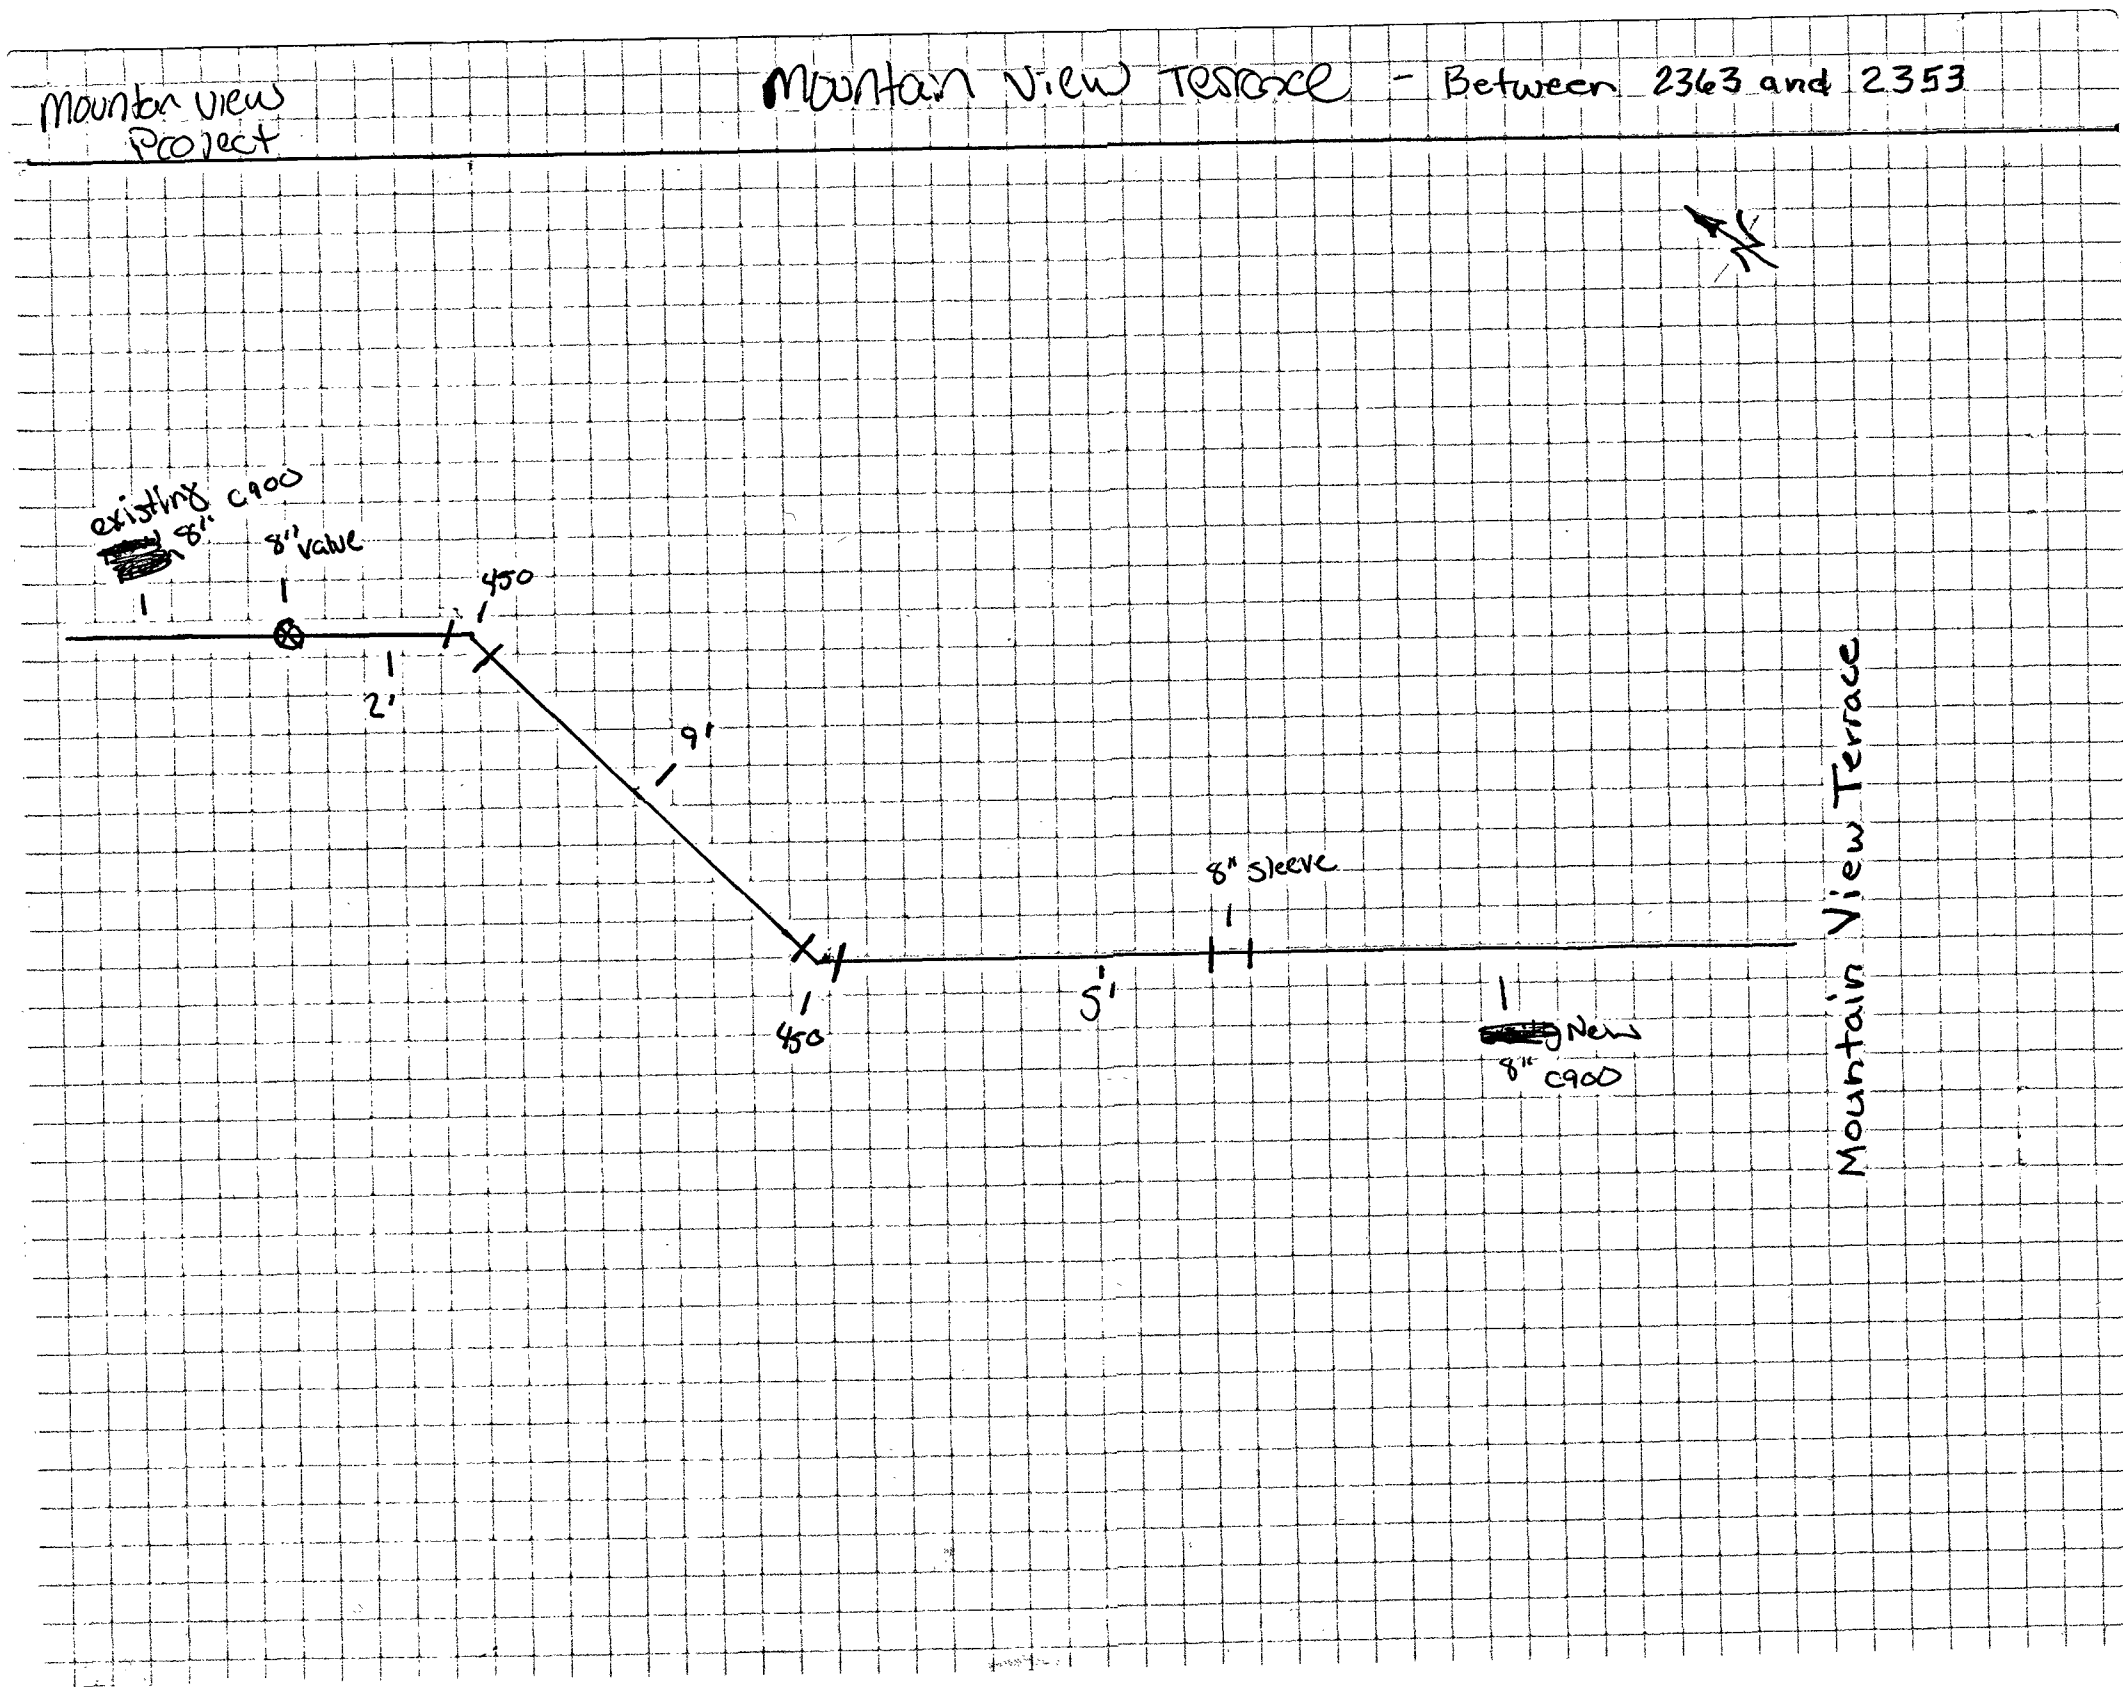


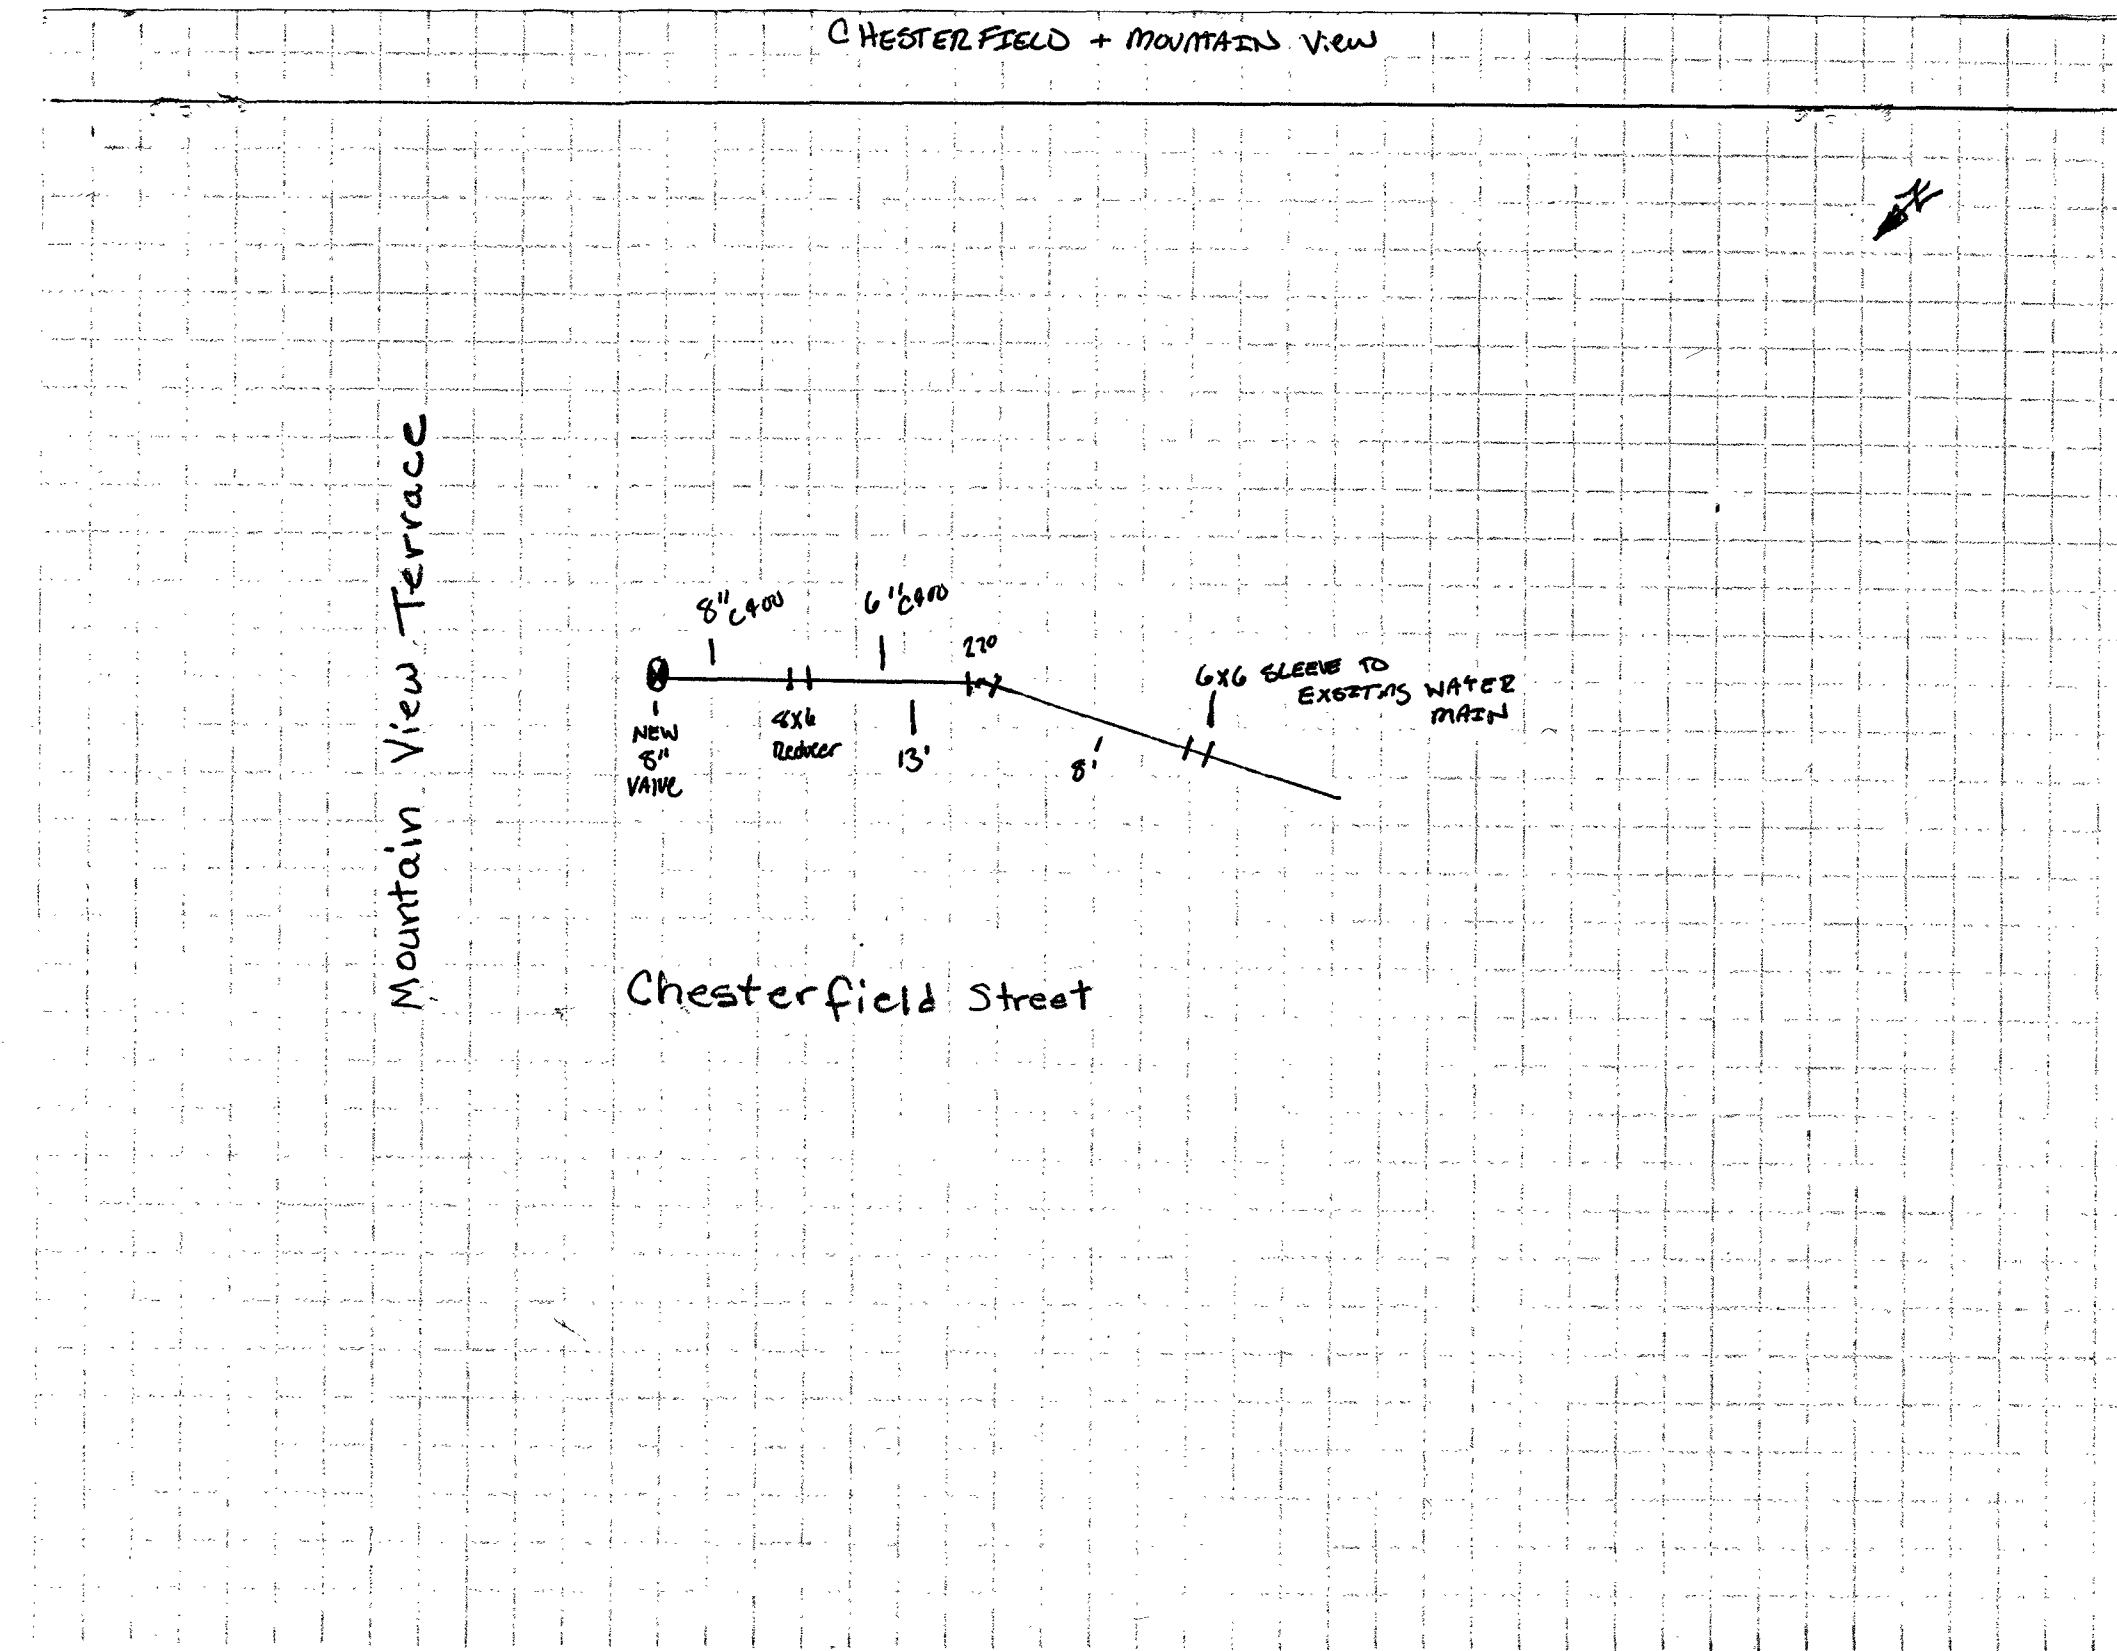

Sheet Sheet 2

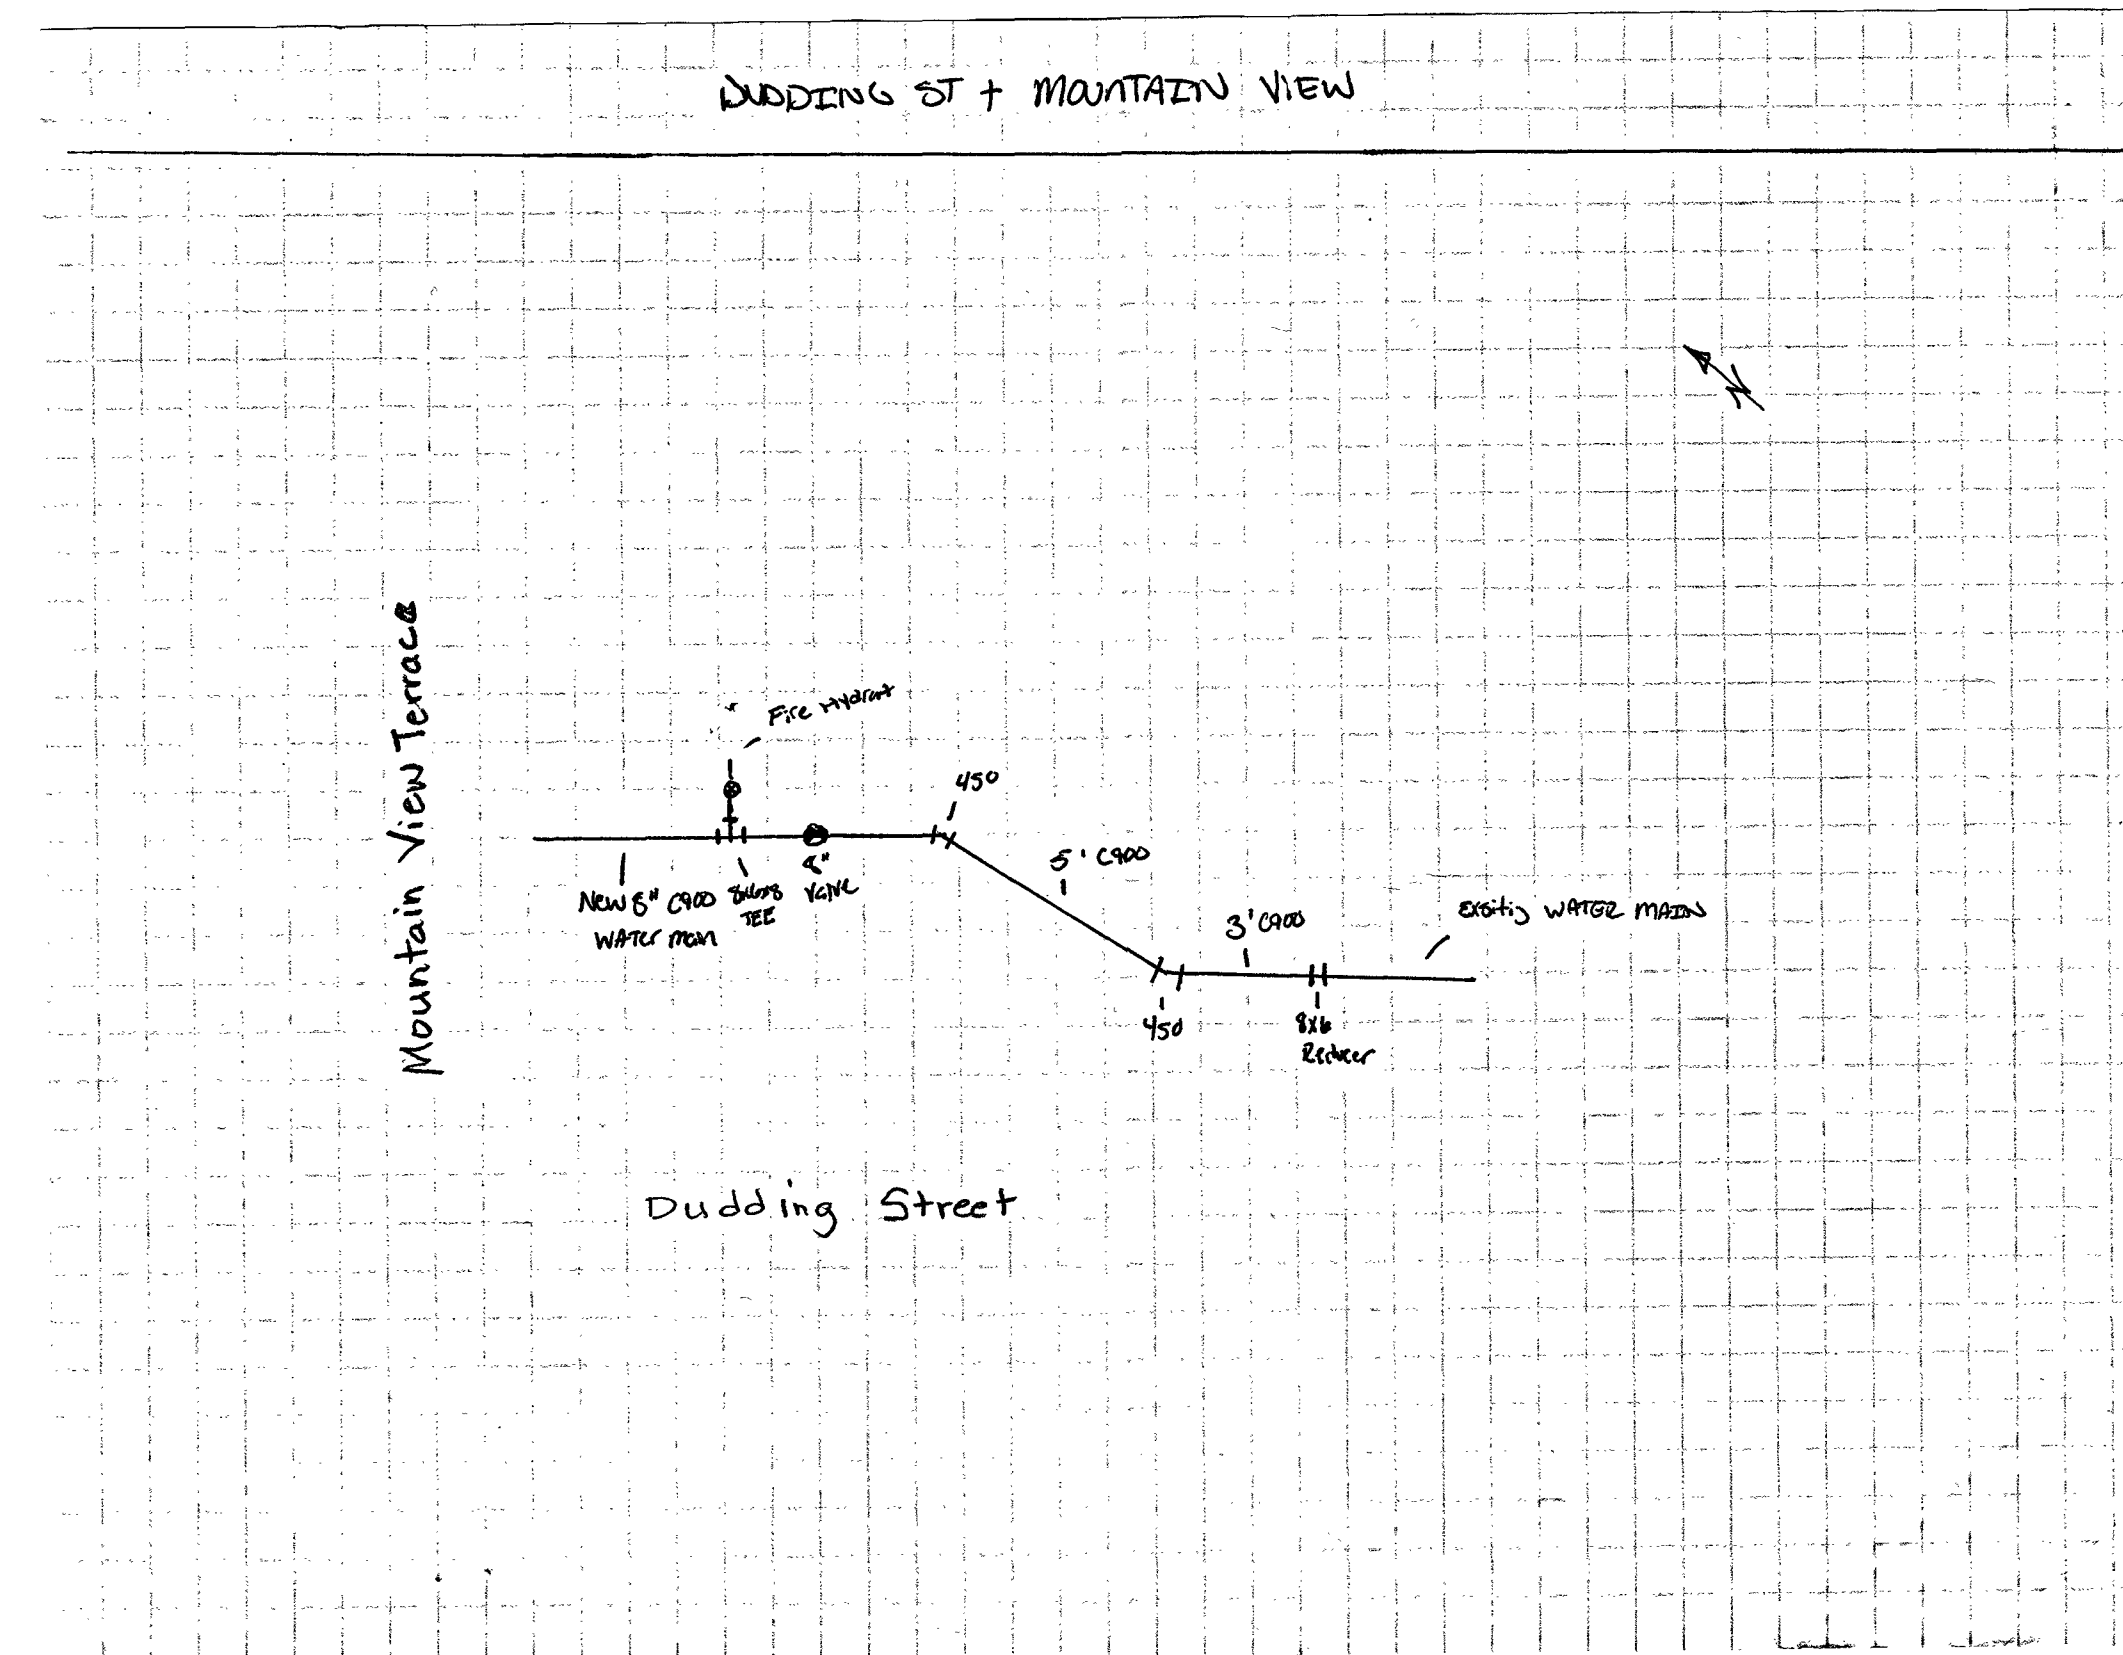

See Sheet 3

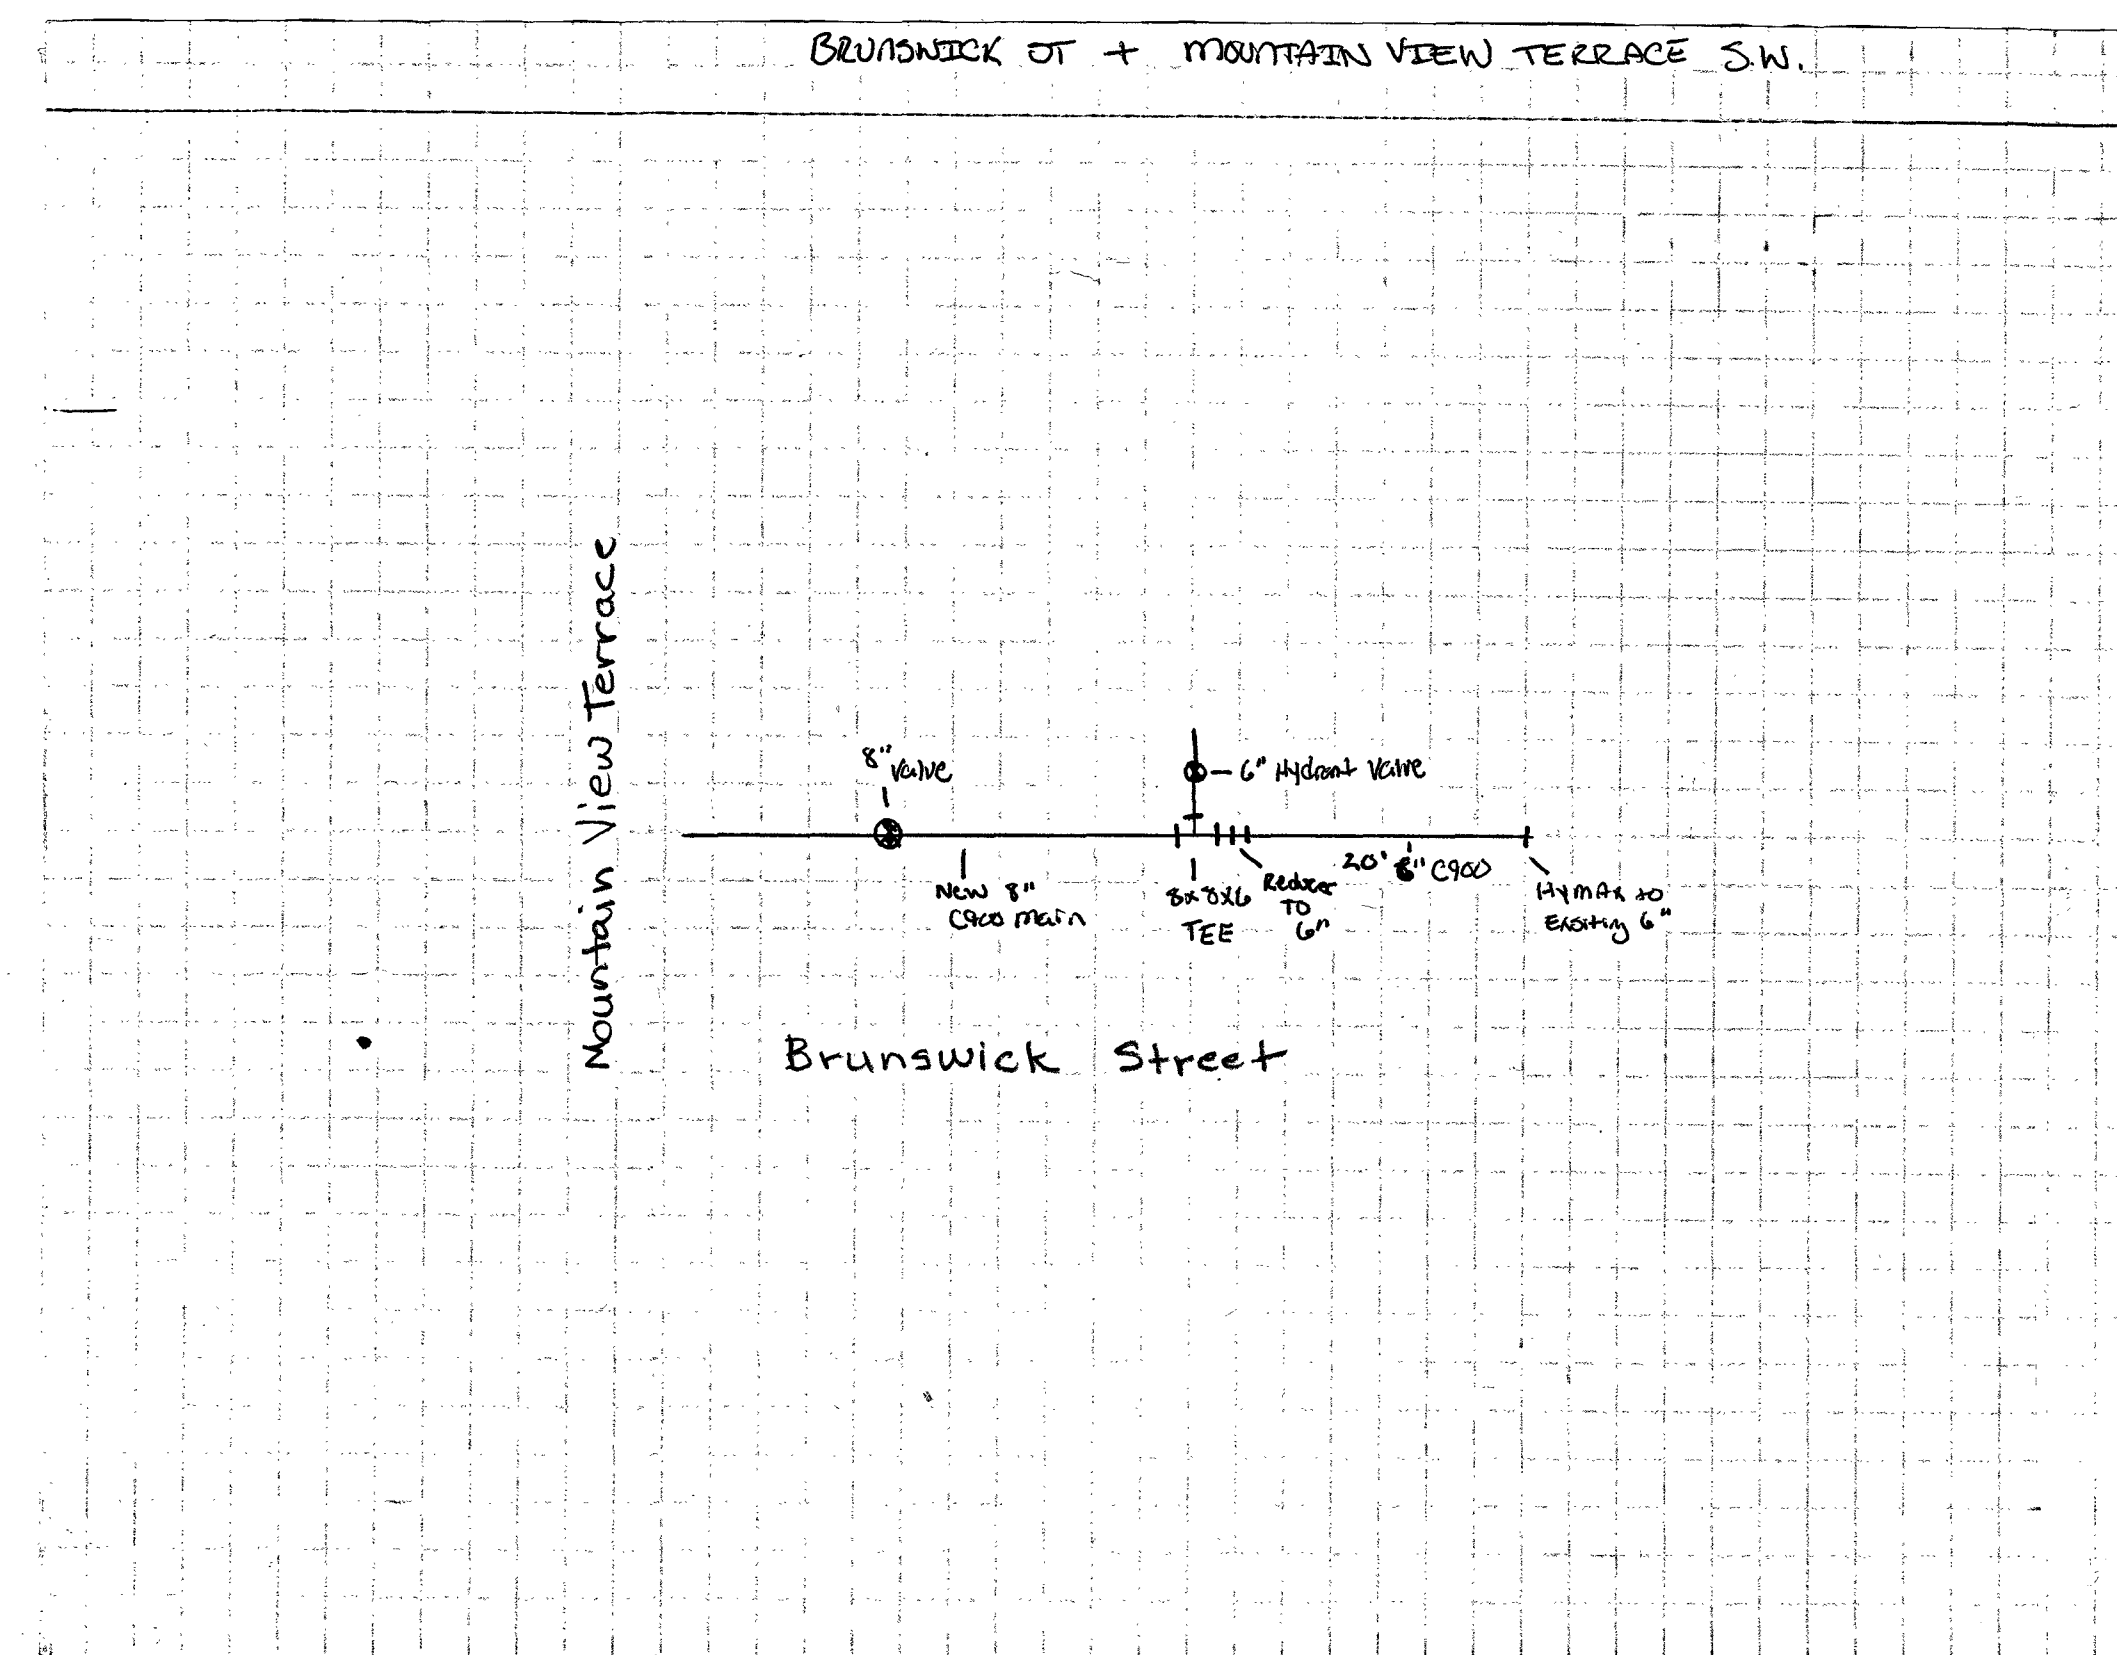

WESTERN VIRGINIA WATER AUTHORITY ENGINEERING SERVICES 601 S JEFFERSON ST, SUITE 300 ROANOKE, VA 24011 540-853-5700		MOUNTAIN VIEW TERRACE WATERLINE REPLACEMENT		By Date 01/24/2019	
WATER CONNECTIONS DETAIL		Description AS-BUILT			
Rev					
Designed: Drawn: Checked: Approved: Date: January 24, 2019 Project: WCIP-061					
5 Sheet 4 of 45					