

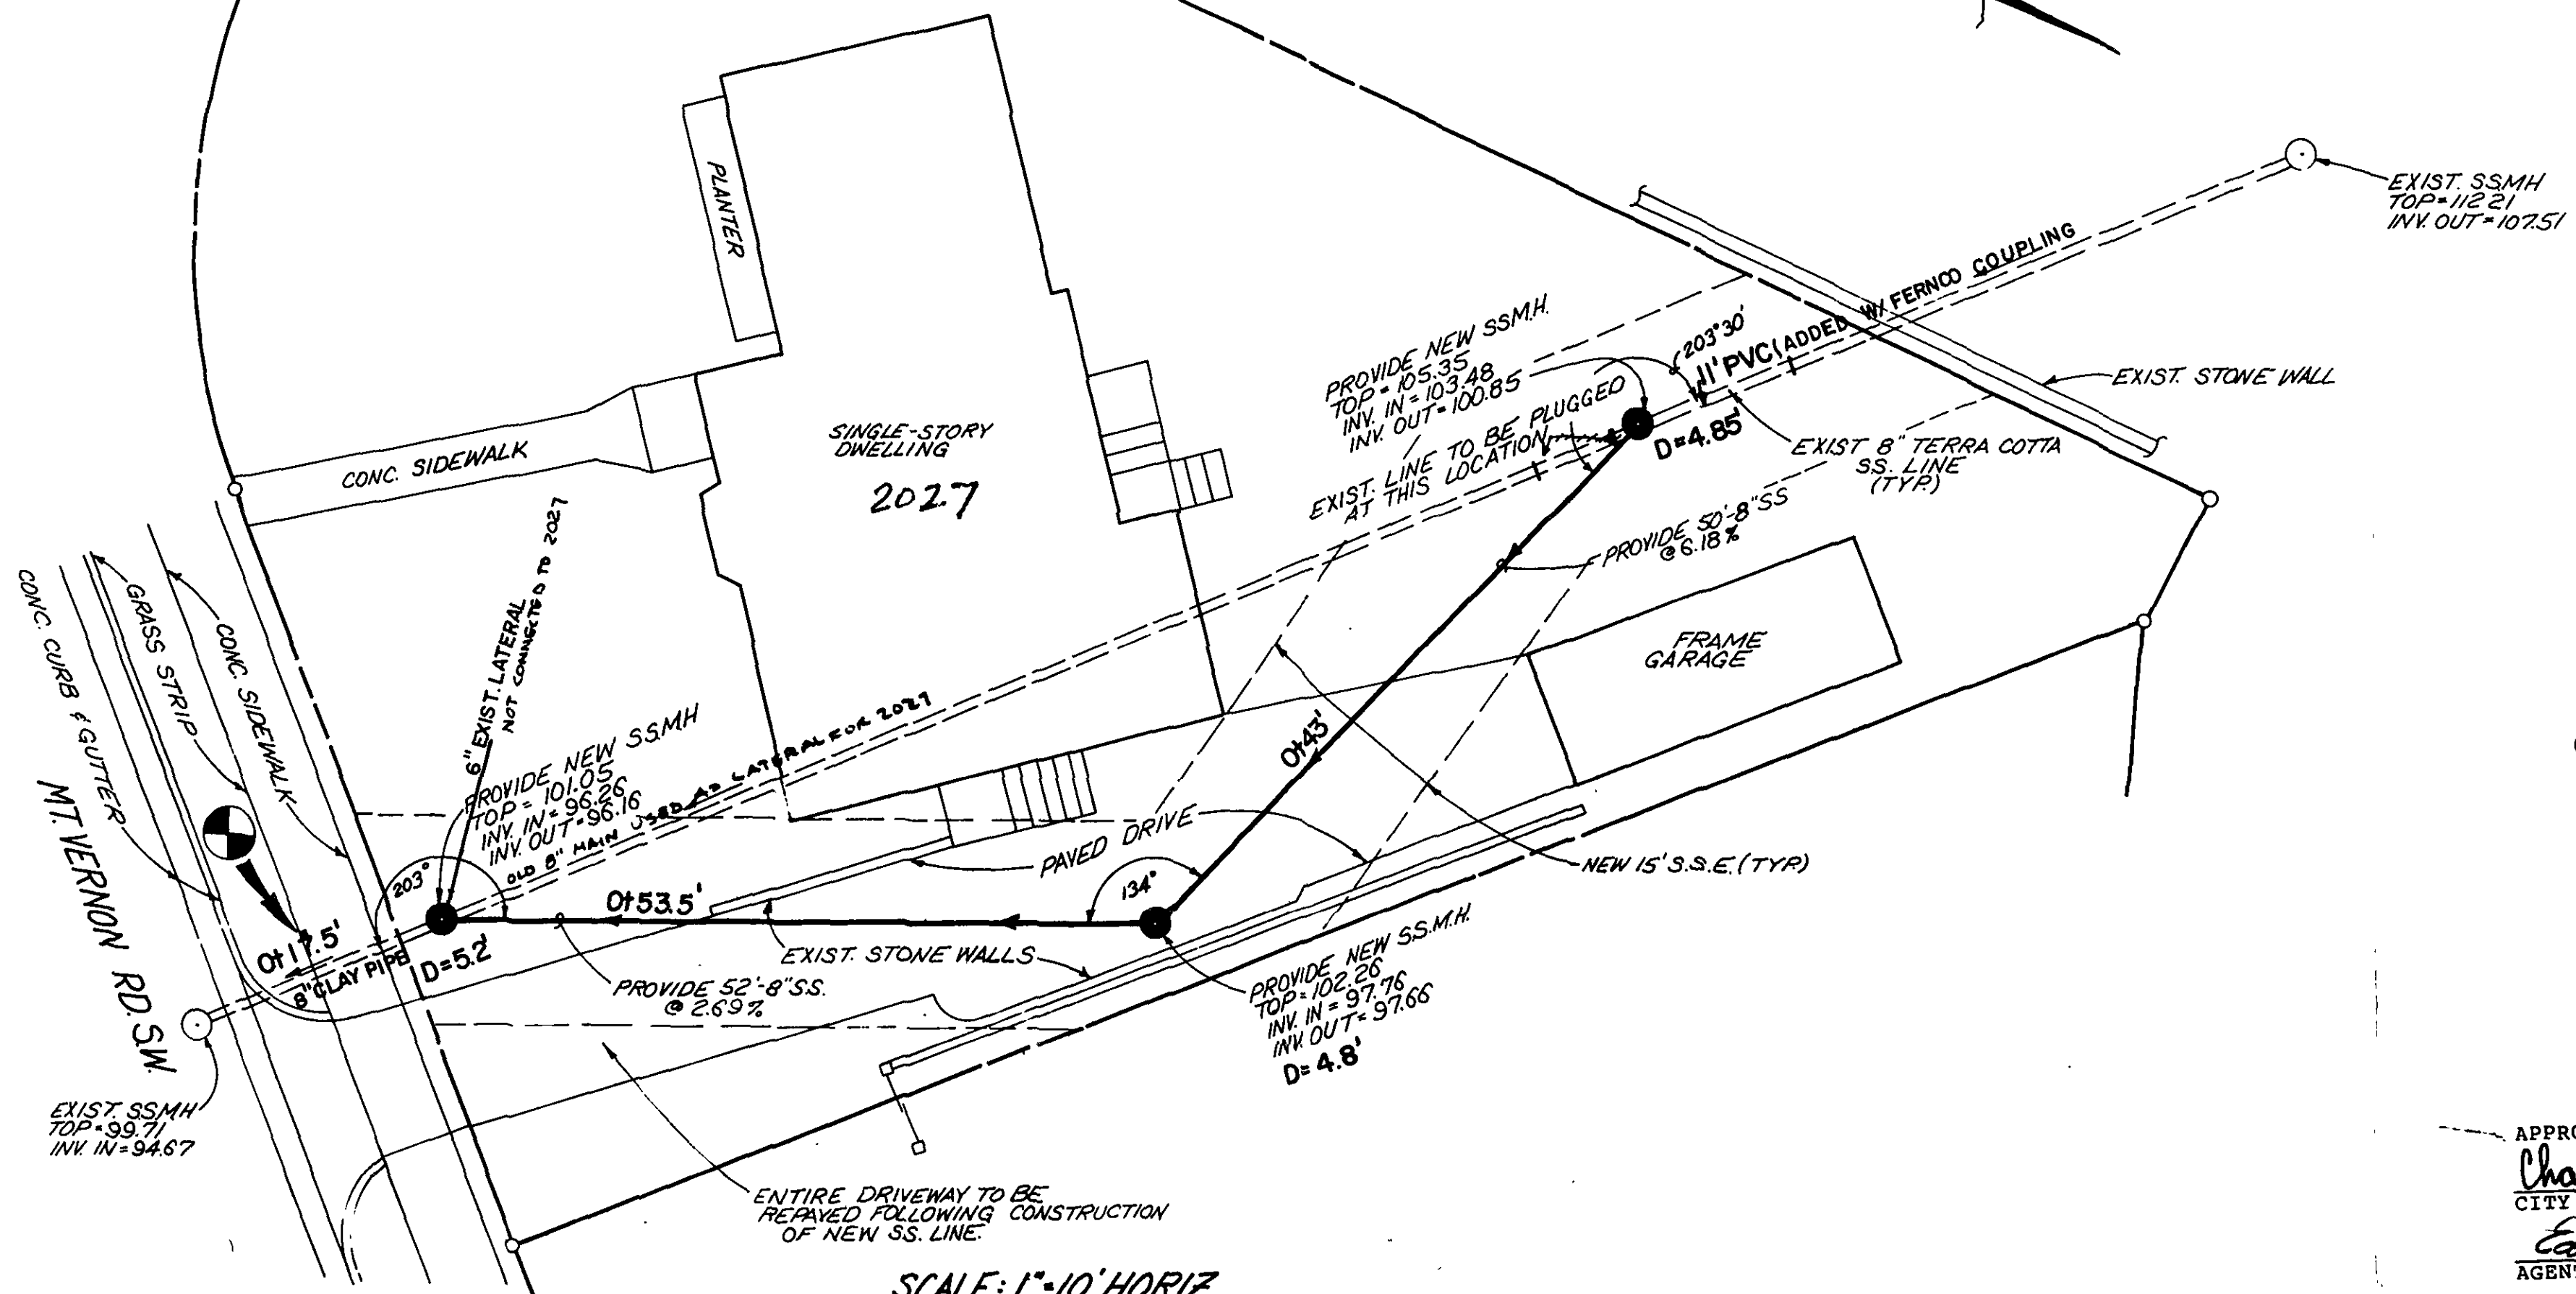


CENTER HILL DR. S.W.

NORTH

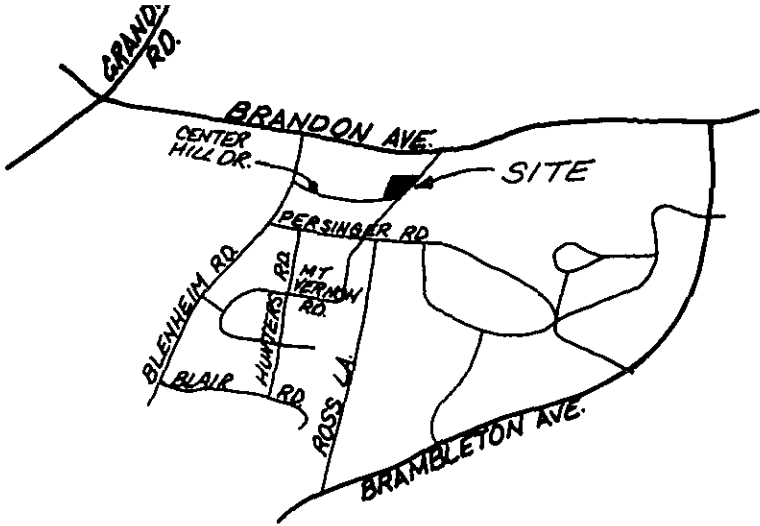

AS-BUILT
CONTRACTOR-E.C. PACE 2/28/91

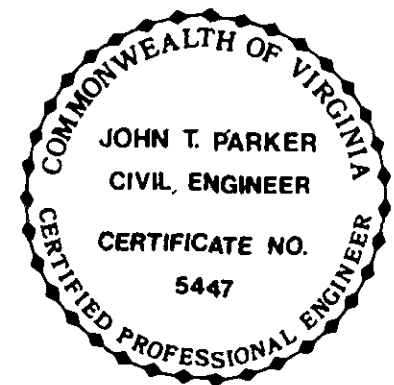


APPROVED:
Charles M. Haffner
CITY ENGINEER OF ROANOKE, VIRGINIA
Edward R. Tuckey
AGENT FOR CITY OF ROANOKE PLANNING COMMISSION

2/25/91
DATE
2/25/91
DATE

NOTE:
ALL NEW S.S. PIPE SHALL
BE SDR-14 PVC OR CITY
OF ROANOKE ENGINEERING
DEPT. APPROVED EQUAL.

SCALE: 1"=10' HORIZ.
1"=5' VERT.

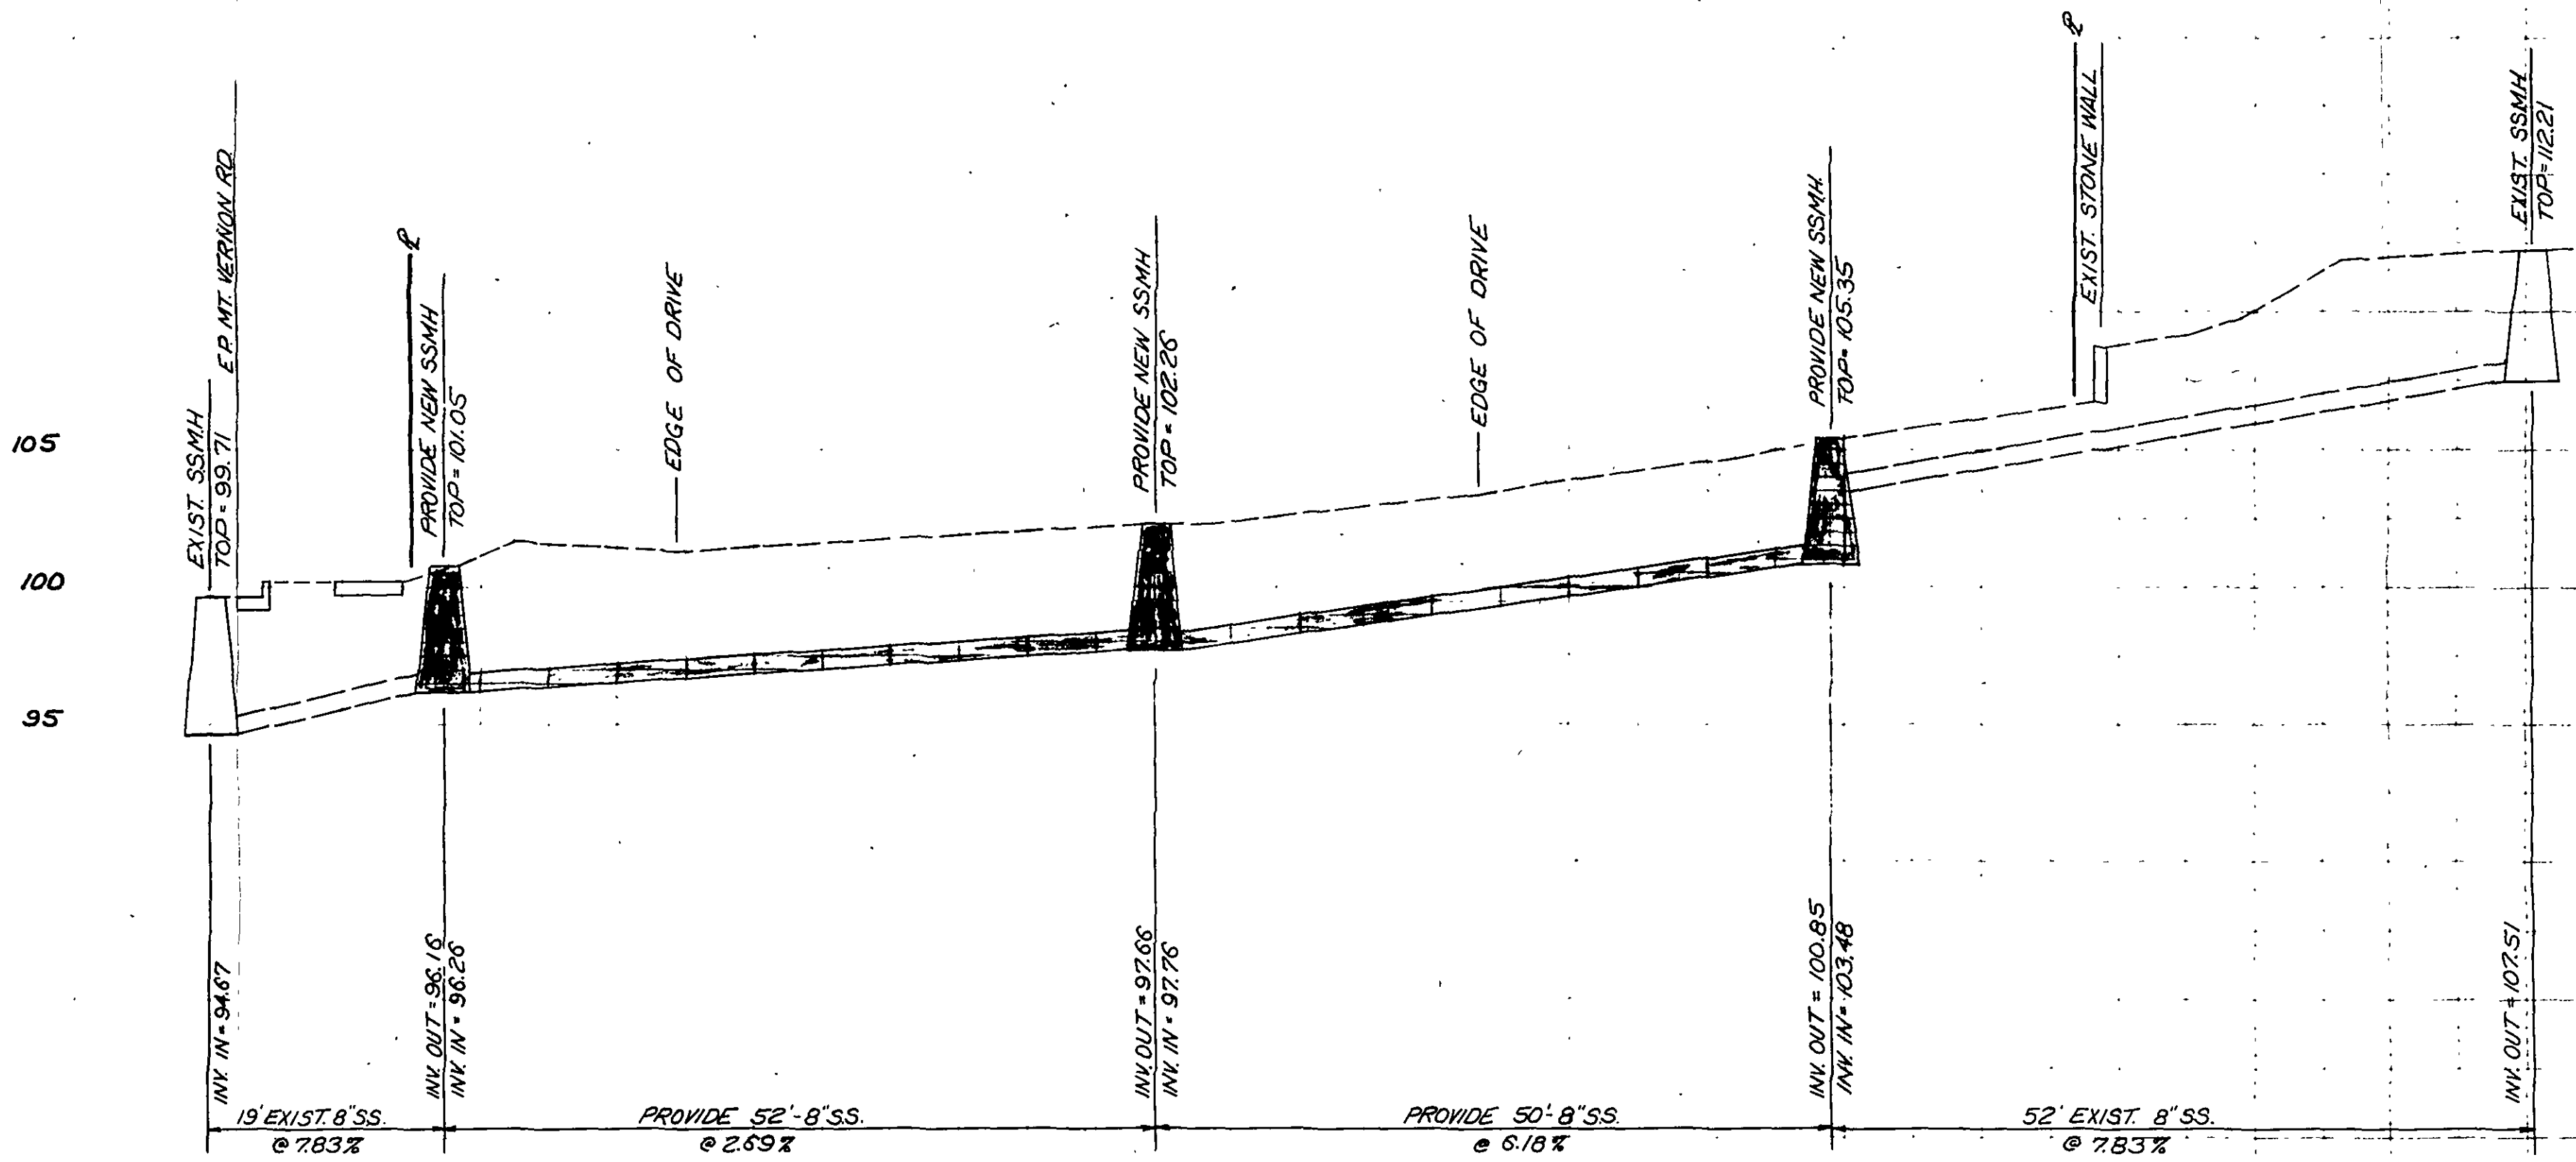

SANITARY SEWER PLAN & PROFILE FOR THE ESTATE OF K.O. BARNETT SHOWING THE RELOCATION OF AN EXISTING SANITARY SEWER LINE			
SITUATE MT. VERNON RD SW & CENTER HILL DR. SW CITY OF ROANOKE, VIRGINIA			
 TPP&S ENGINEERS SURVEYORS PLANNERS	DESIGNED CLW T. P. Parker & Son 816 Boulevard Post Office Box 39 Salem, Virginia 24153 Telephone: 703-387-1153 FAX: 703-389-5767	DRAWN CLW AS SHOWN	CHECKED SCALE W.O. NO. 91-0210 N.B. JR-85 SHEET 1 OF 2
	DATE FEB 25, 1991		